

PARENT PARCEL: ADD TO DUP.



CHILD PARCEL: 03-00-040-104-034

05-01240-V

STARTING POINT:

ADD TO DUP

PER VACATION ORD 67-05

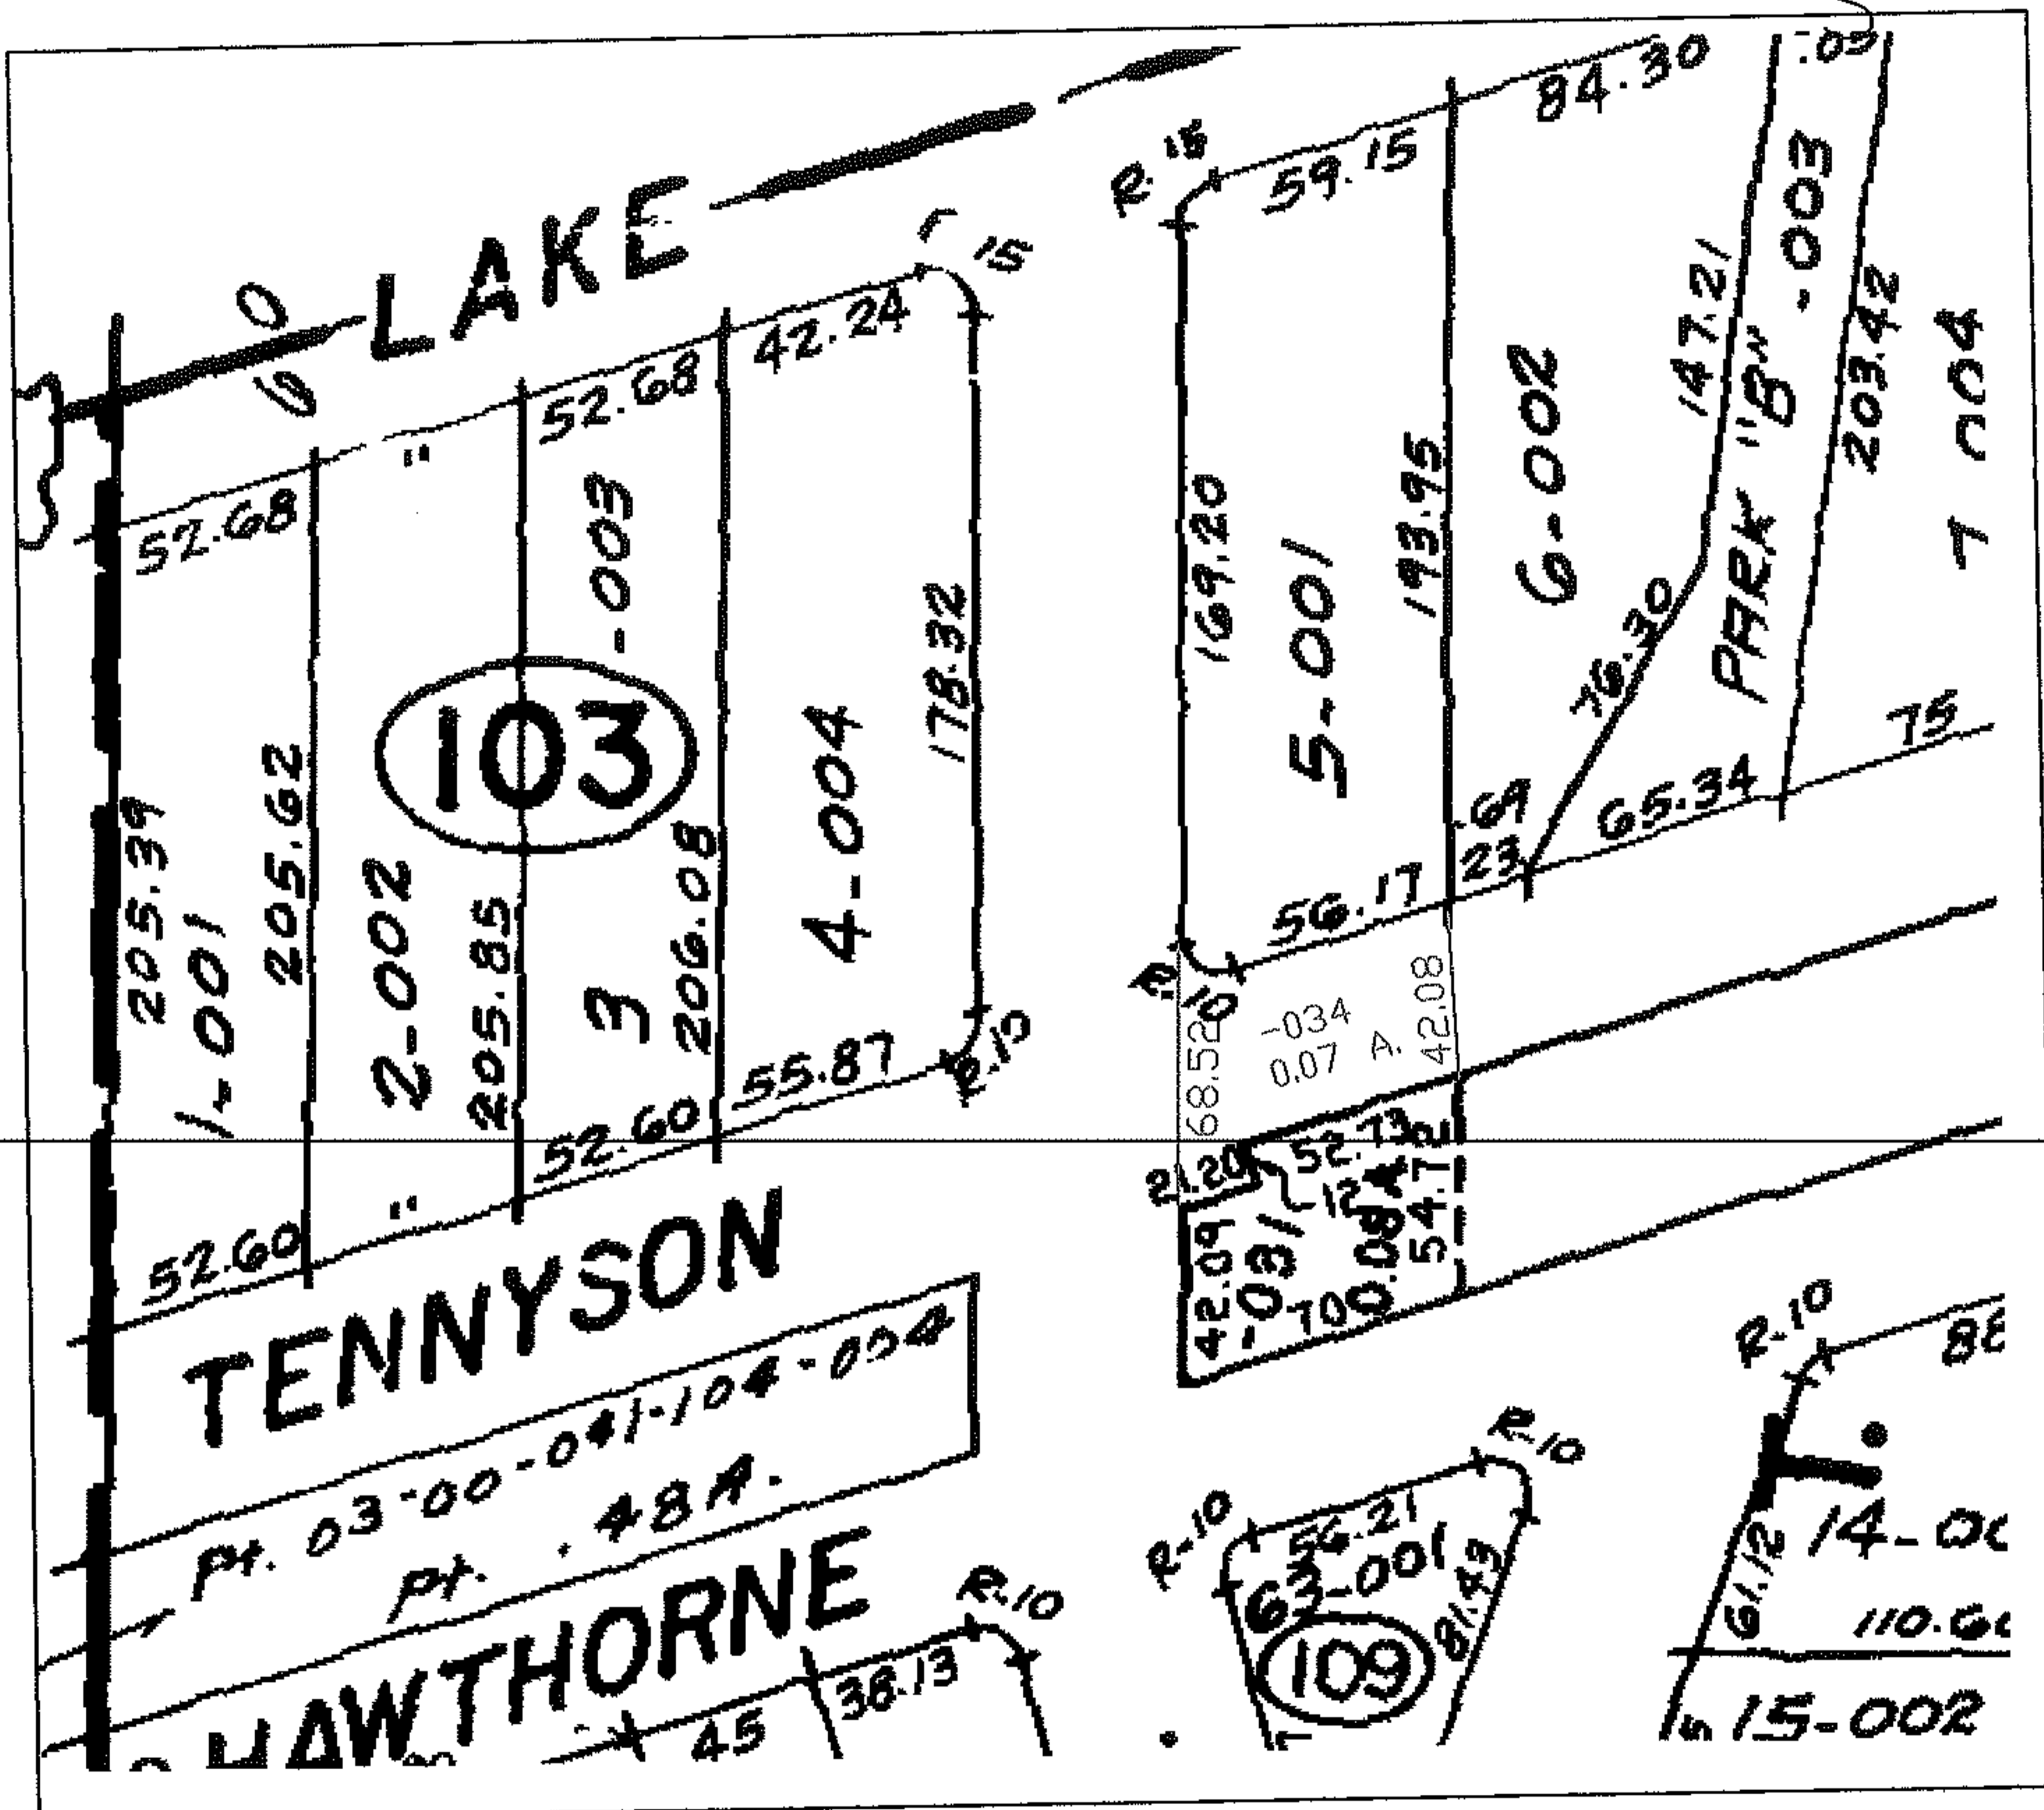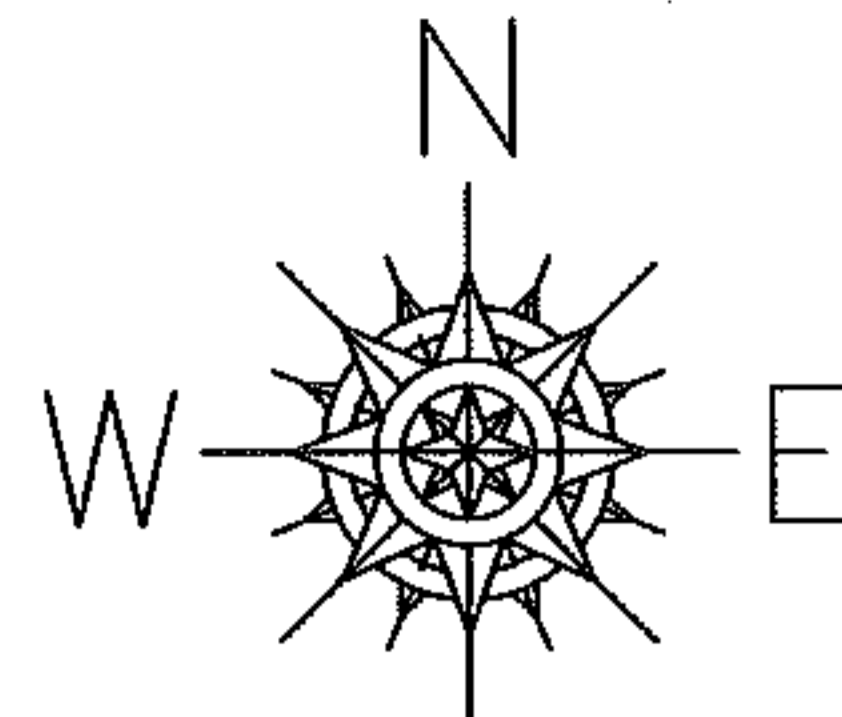

SPLITS/DEEDS PROCESSED

LORAIN COUNTY TAX MAP DEPARTMENT  
226 MIDDLE AVE. ELYRIA, OHIO

SURVEYED BY: PATRICK A. MCGANNON

CLOSURE: 1:10,000

MAP PAGE(S): 03-00-040

APPROVED BY: DRH DATE: 11/30/2005

SCALE: 1" = 100 PRIOR INSTRUMENT: