

RASTER



PARENT PARCEL: 04-00-006-114-056

CHILD PARCEL: --SAME--

STARTING POINT: INT CL WALKER RD AND MOORE RD

05-01245-C


AC. CORR.
PER SURVEY
C. HIRZEL

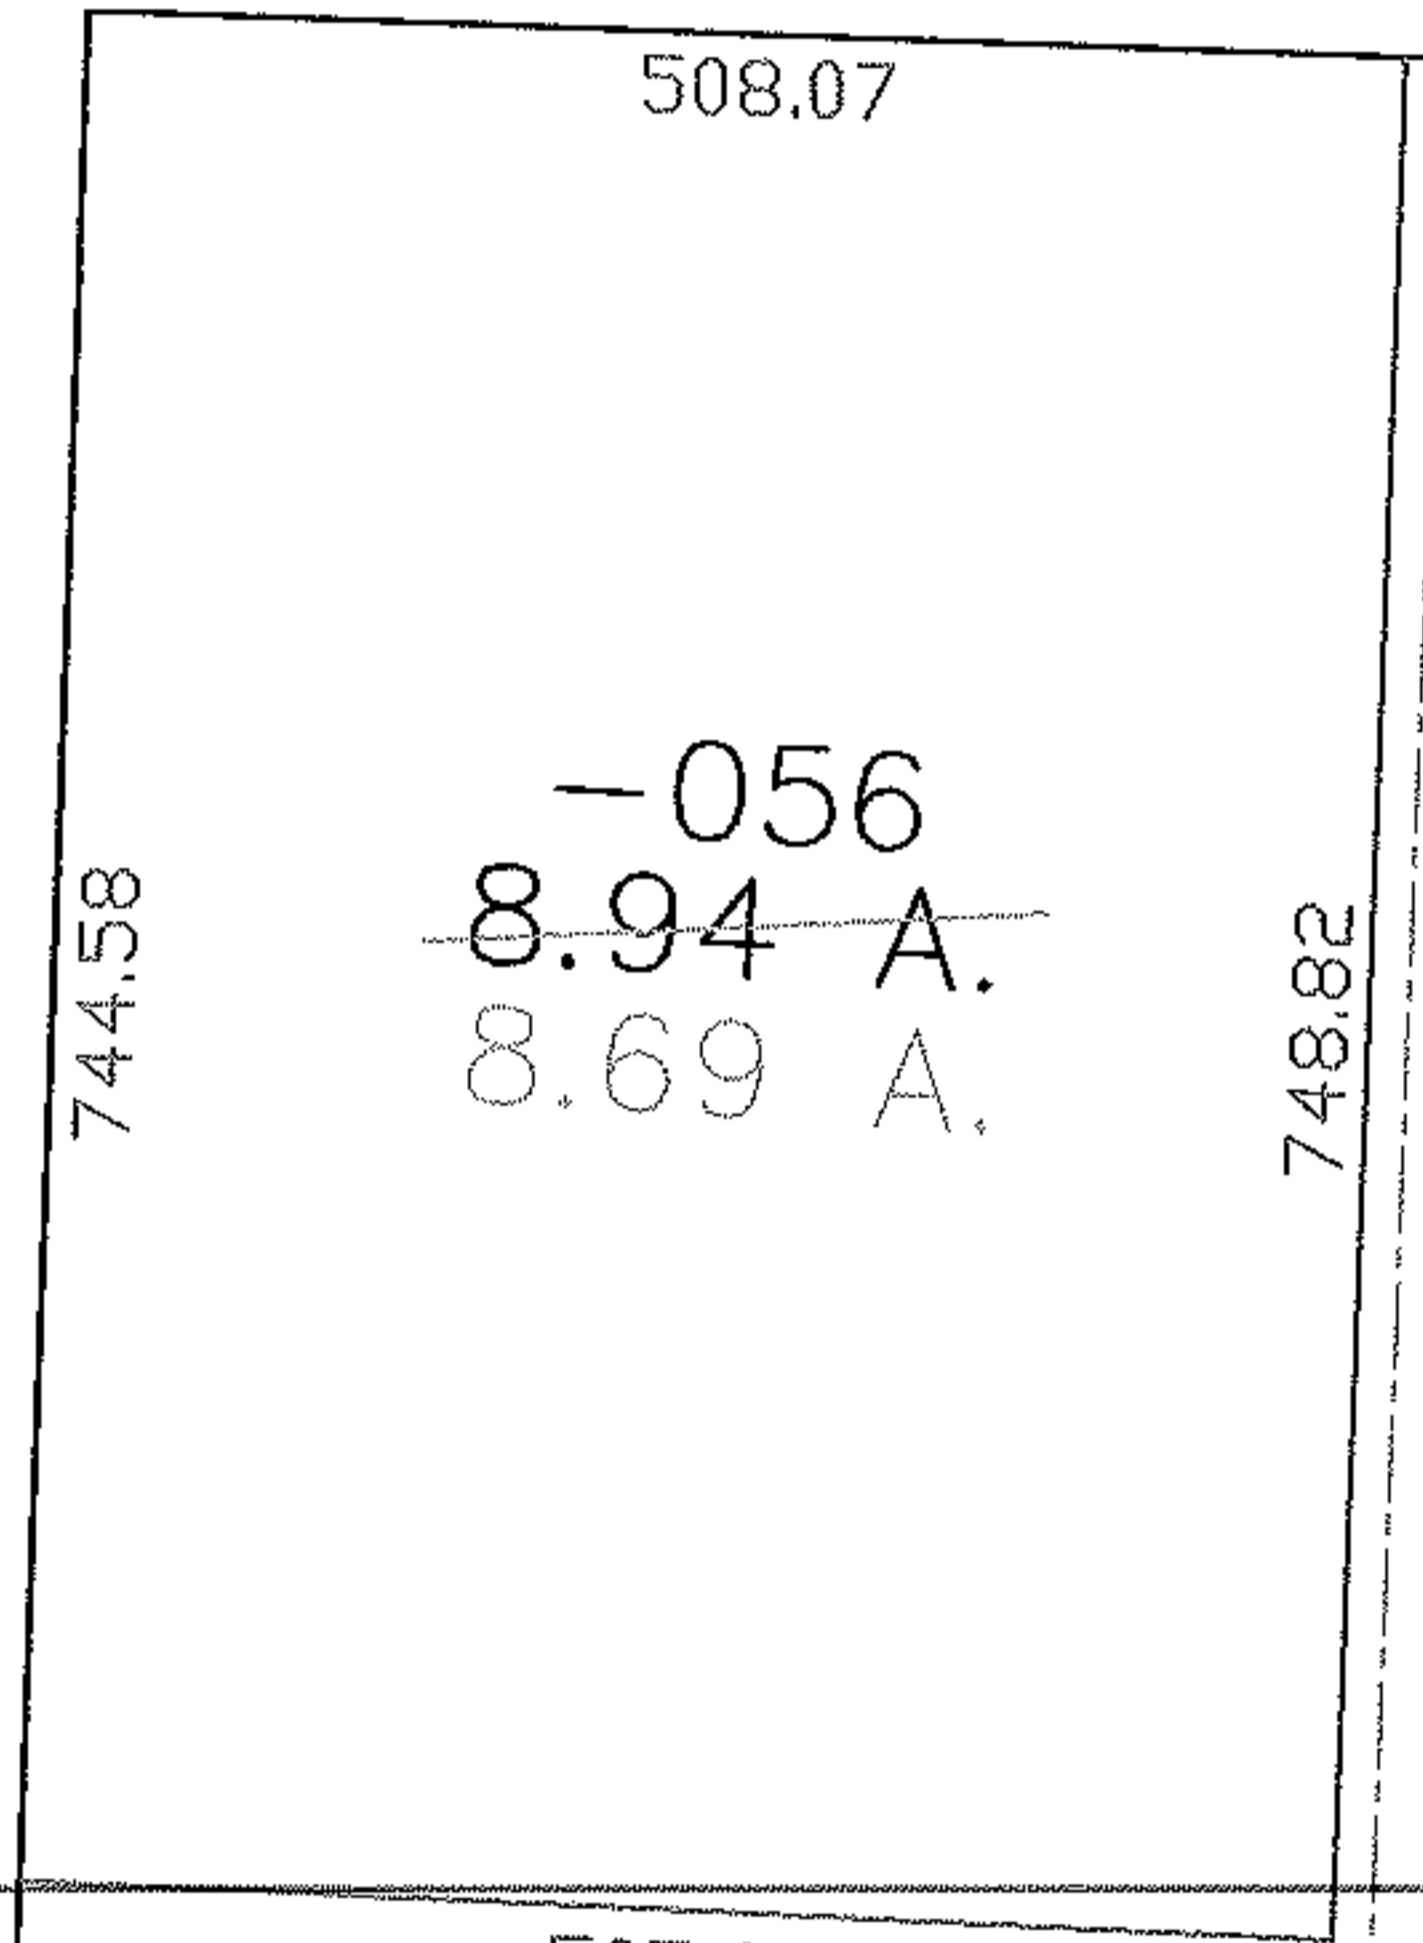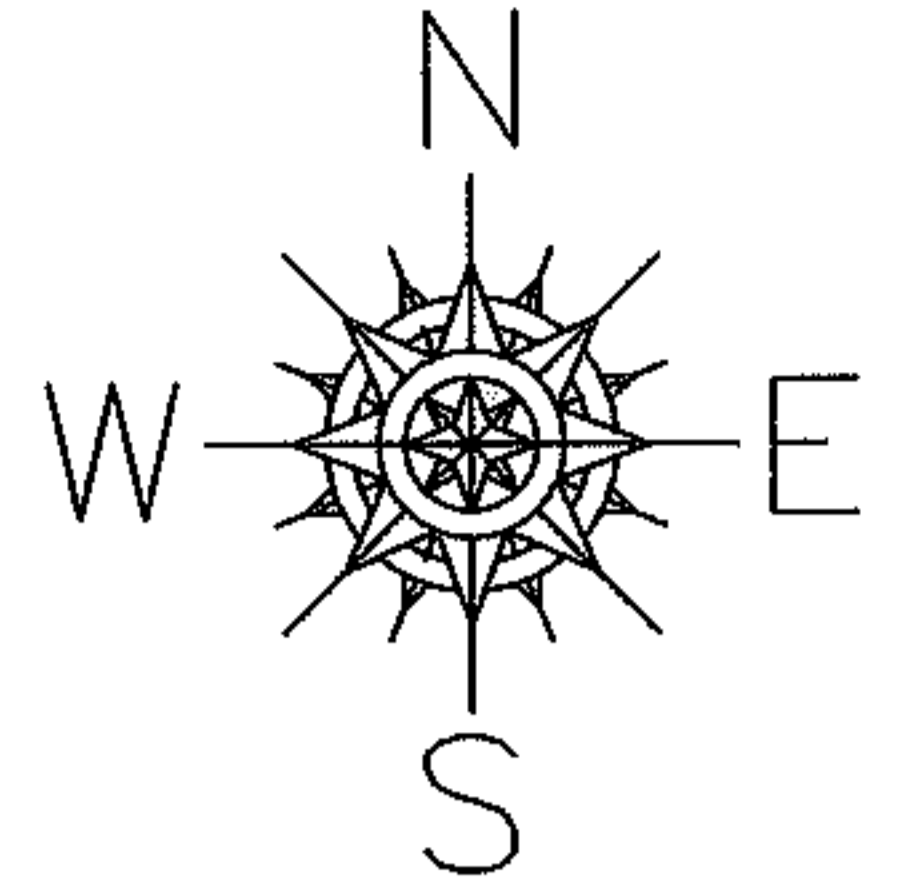

WALKER RD

2689.66

MOORE RD

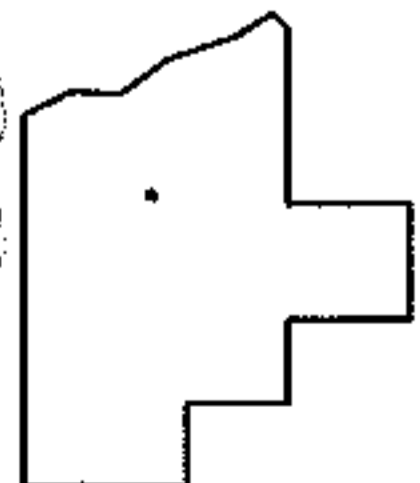

SPLITS/DEEDS PROCESSED
LORAIN COUNTY TAX MAP DEPARTMENT
226 MIDDLE AVE. ELYRIA, OHIO

SURVEYED BY: CHRISTOPHER HIRZEL

CLOSURE: 1:10,000

MAP PAGE(S): 04-00-006-F

APPROVED BY: DRH DATE: 12/9/2005

SCALE: 1" = 200' PRIOR INSTRUMENT: 605/13