
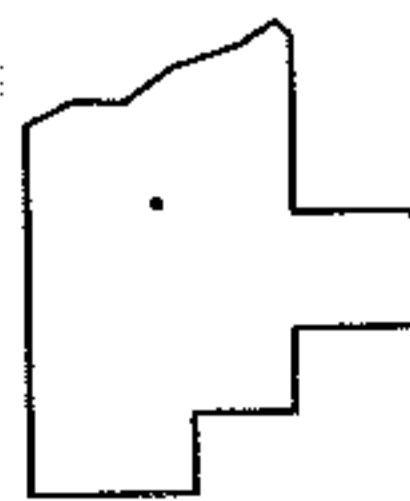
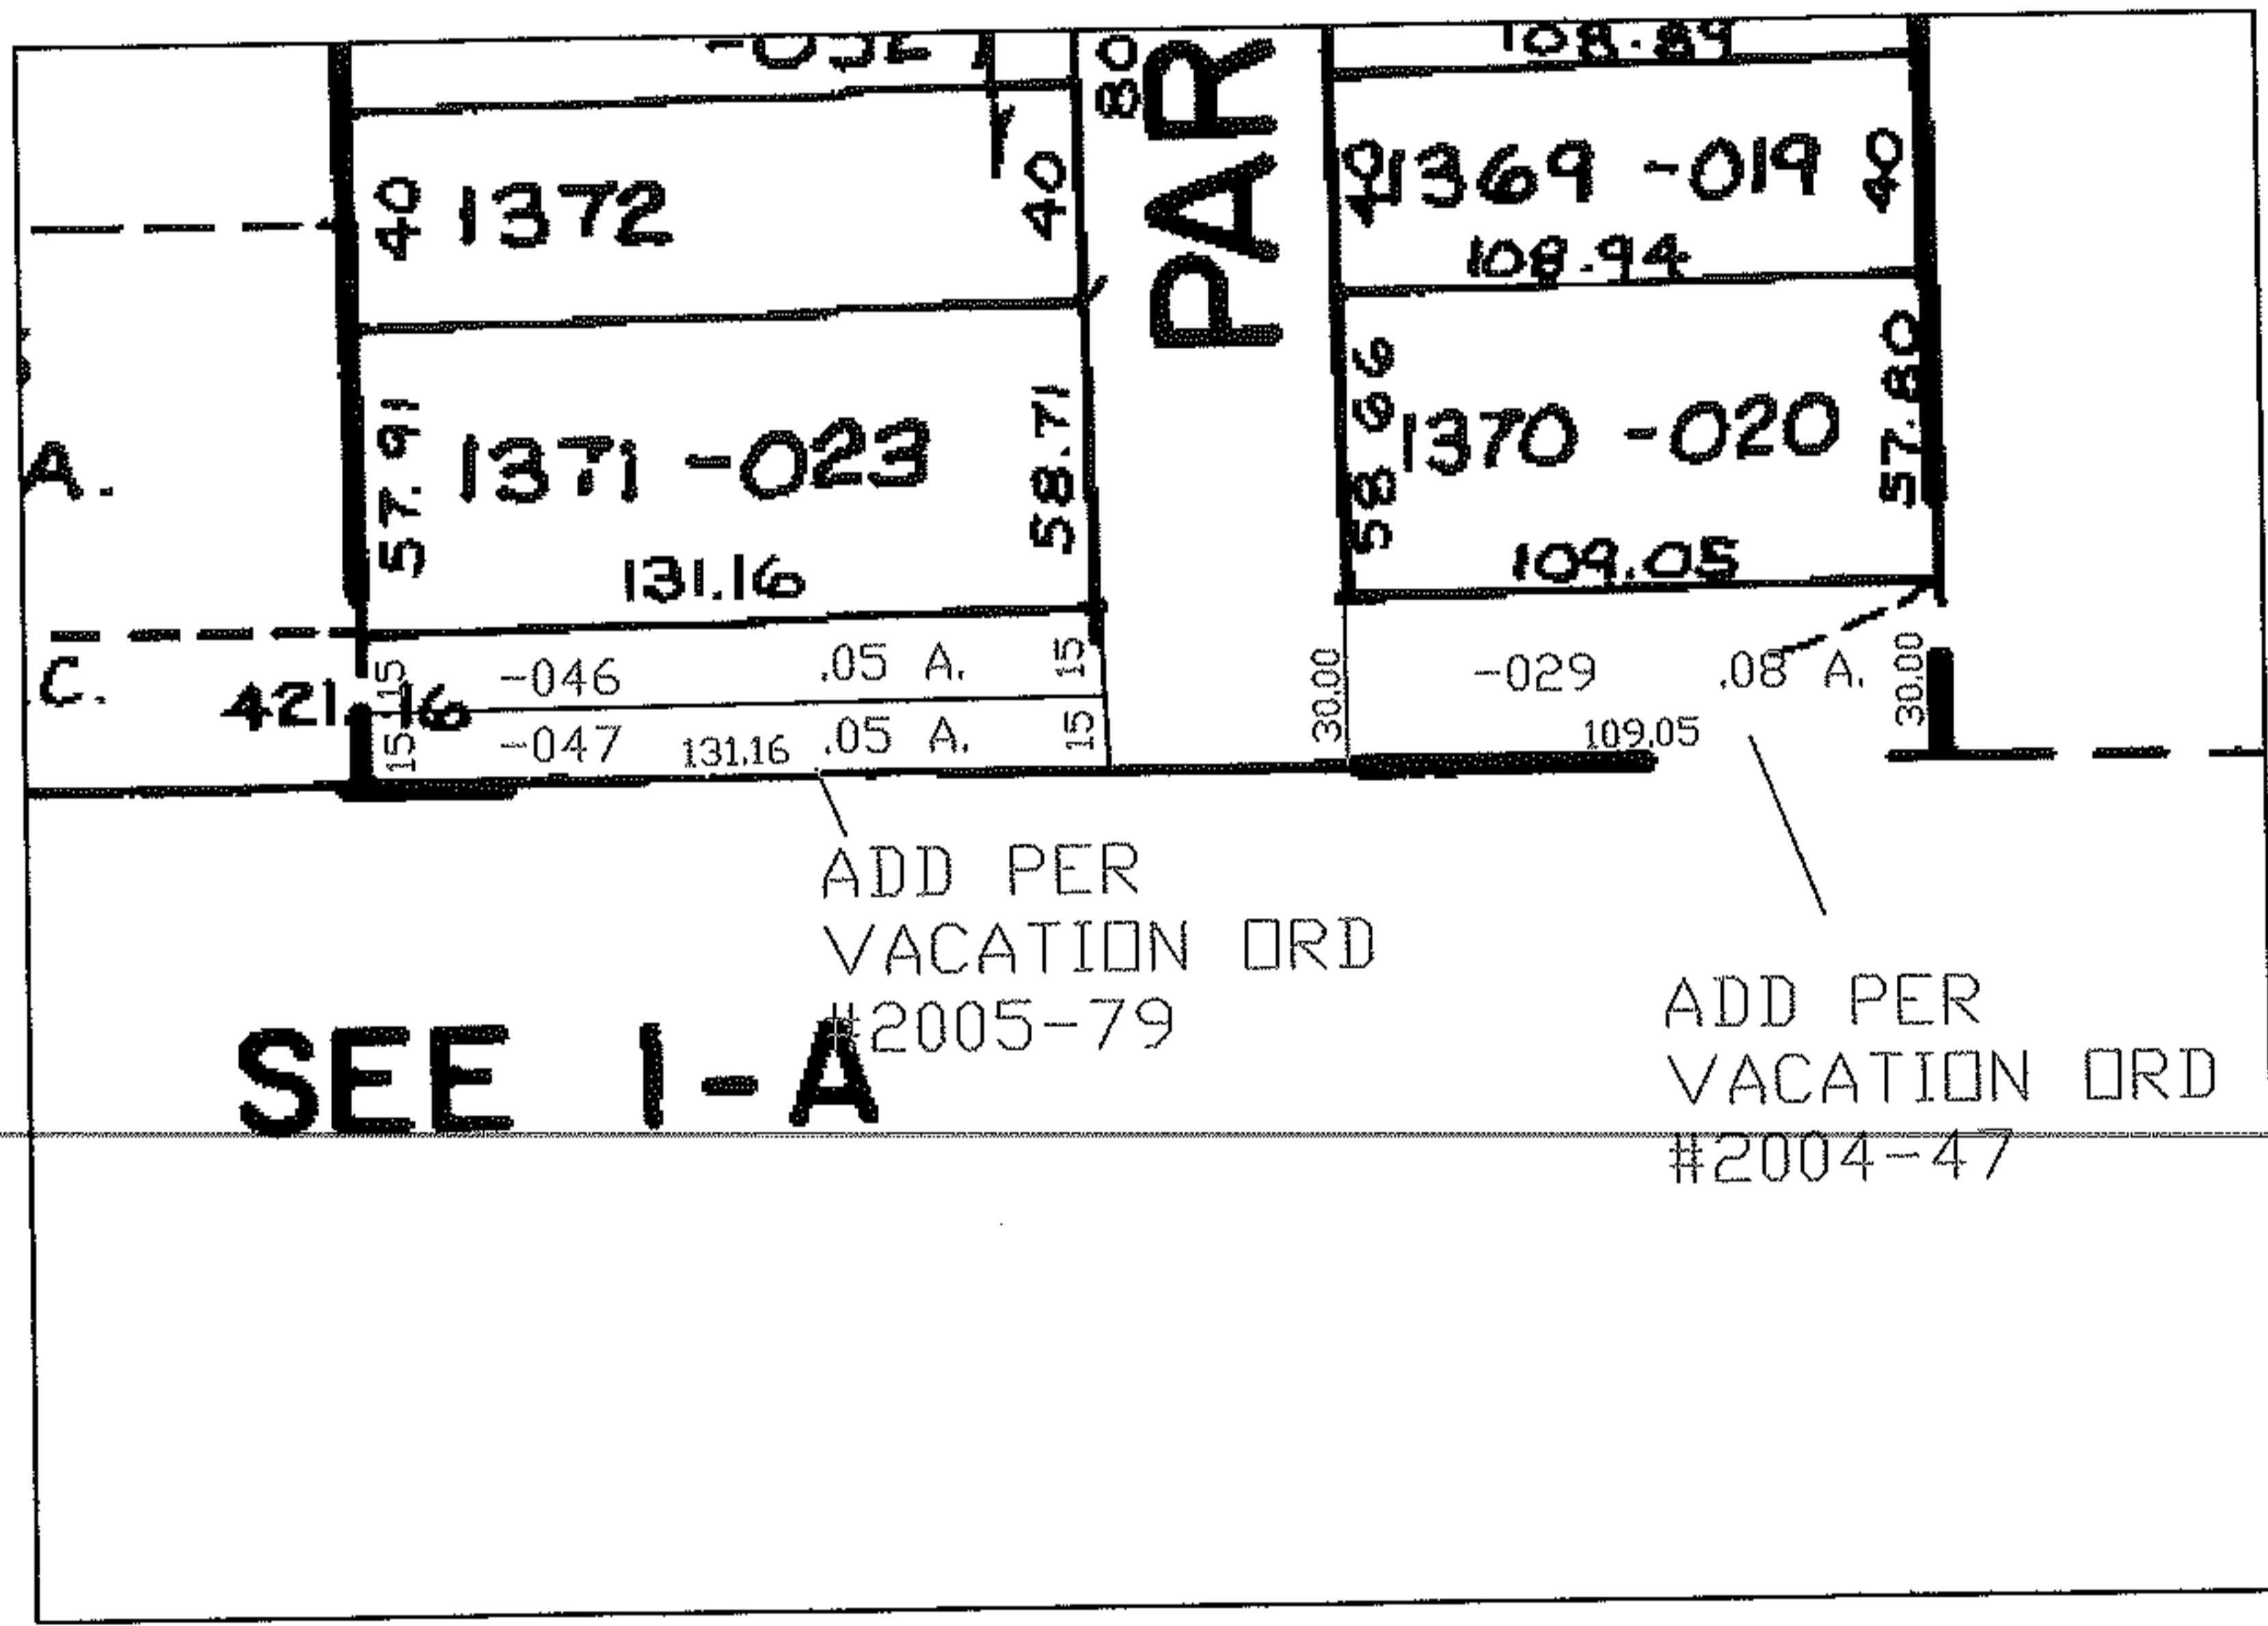


RASTER

PARENT PARCEL: --NONE--  
CHILD PARCEL: 01-00-002-122-029, 01-00-002-121-046 & -047  
STARTING POINT: BOYNTON ROAD

05-01255-V

VACATION OF BOYNTON RD  
PER ORD # 2004-47

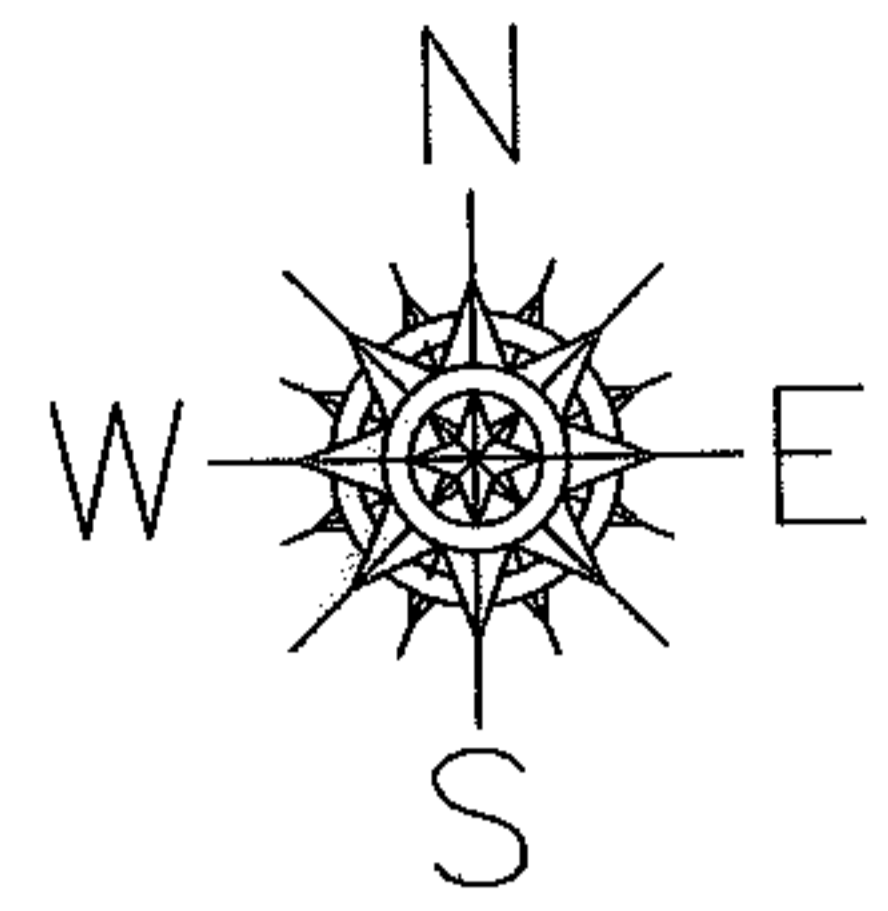

SPLITS/DEEDS PROCESSED  
LORAIN COUNTY TAX MAP DEPARTMENT  
226 MIDDLE AVE. ELYRIA, OHIO

SURVEYED BY: DALE HAYWOOD  
CLOSURE: N/A  
MAP PAGE(S): 01-00-002-D  
APPROVED BY: DRH DATE: 1/10/2006  
SCALE: 1"= 100 PRIOR INSTRUMENT: N/A