

RASTER

PARENT PARCEL: 12-00-083-000-062

CHILD PARCEL: 12-00-083-000-065 & -066


STARTING POINT: MON BOX AT INT ROOT RD AND OSBORNE RD

06-01265-U


OSBORNE RD

PT. 062
2.25 A.



-065
0.69 A.

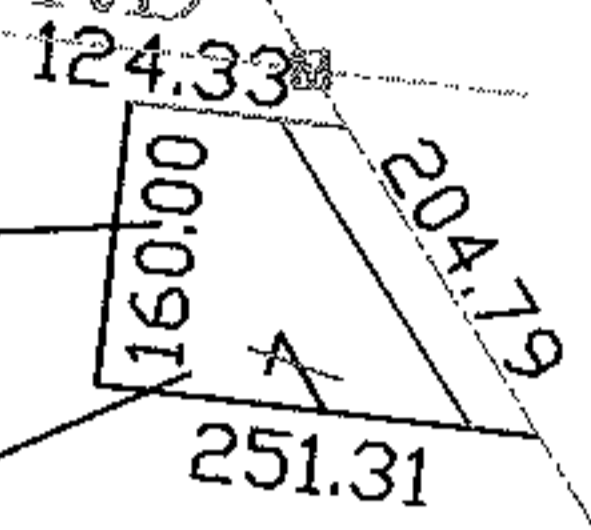

ROOT ROAD
1796.57

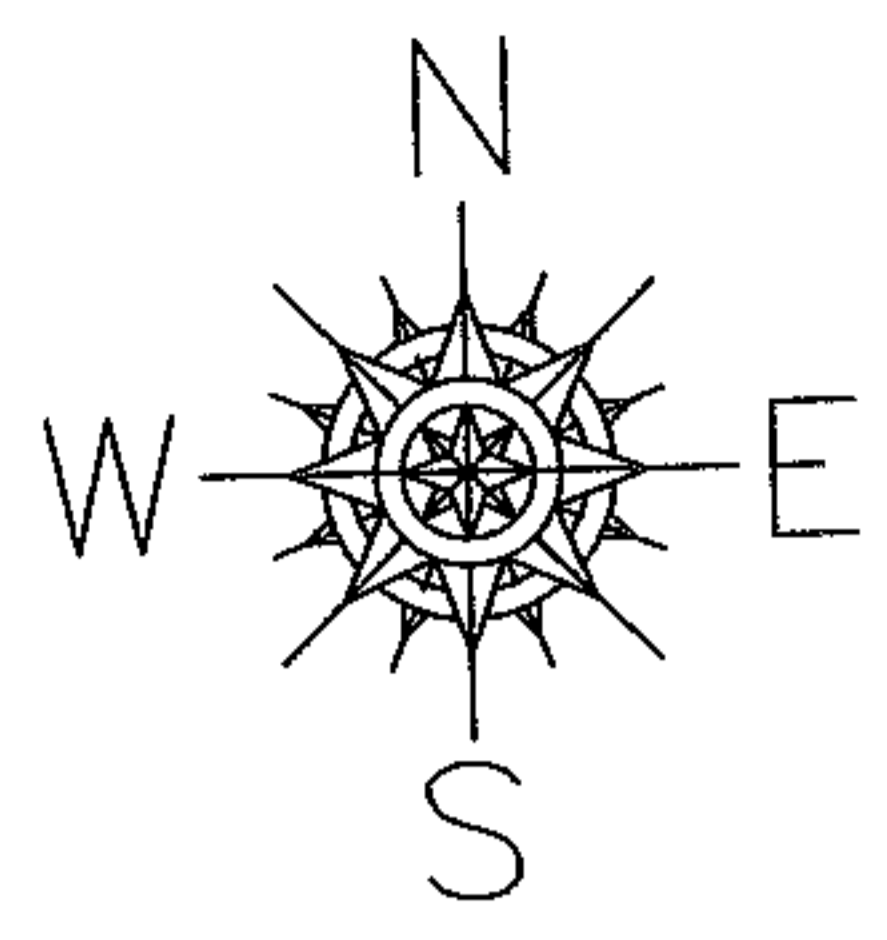

UNCOMBINATION
& AC. CORR
PER SURVEY
MICHAEL SPELLACY

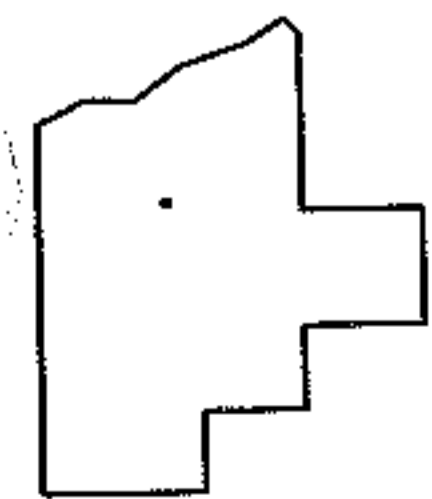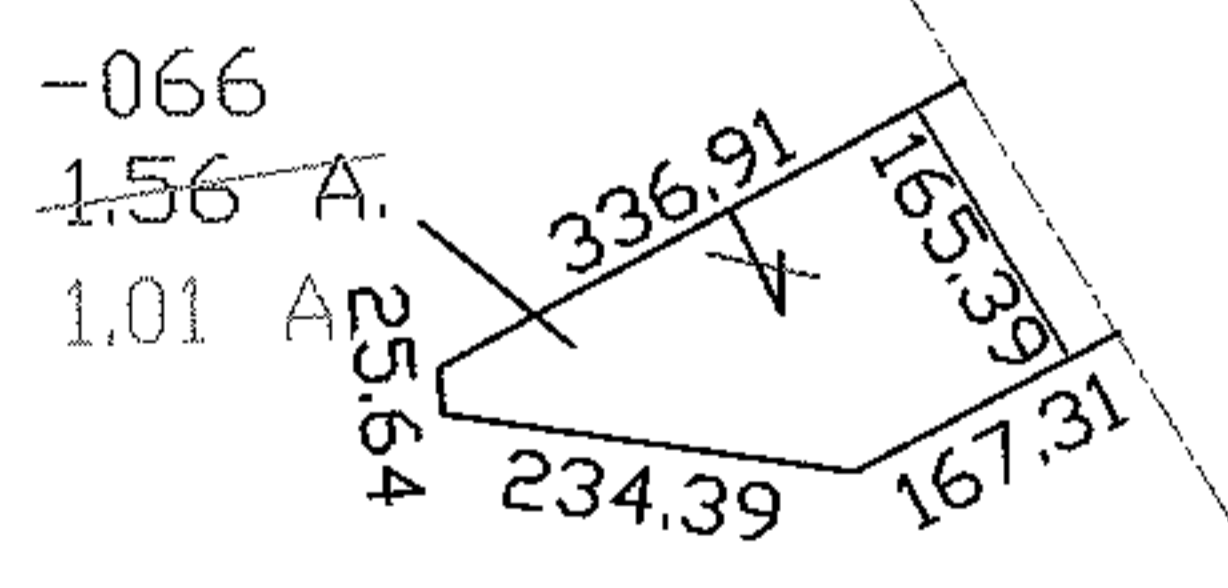

SPLITS/DEEDS PROCESSED
LORAIN COUNTY TAX MAP DEPARTMENT
226 MIDDLE AVE. ELYRIA, OHIO

SURVEYED BY: MICHAEL P. SPELLACY
 CLOSURE: 1:10,000
 MAP PAGE(S): 12-00-083-A
 APPROVED BY: DRH DATE: 2/9/2006
 SCALE: 1" = 300 PRIOR INSTRUMENT: DV XXXX/XXX