


REVISION 2

PARENT PARCEL: ADD TO DUPLICATE & DROP FROM DUPLICATE
CHILD PARCEL: XX-XX-XXX-XXX-XXX
STARTING POINT: XXXXXX

NO. 01270-D

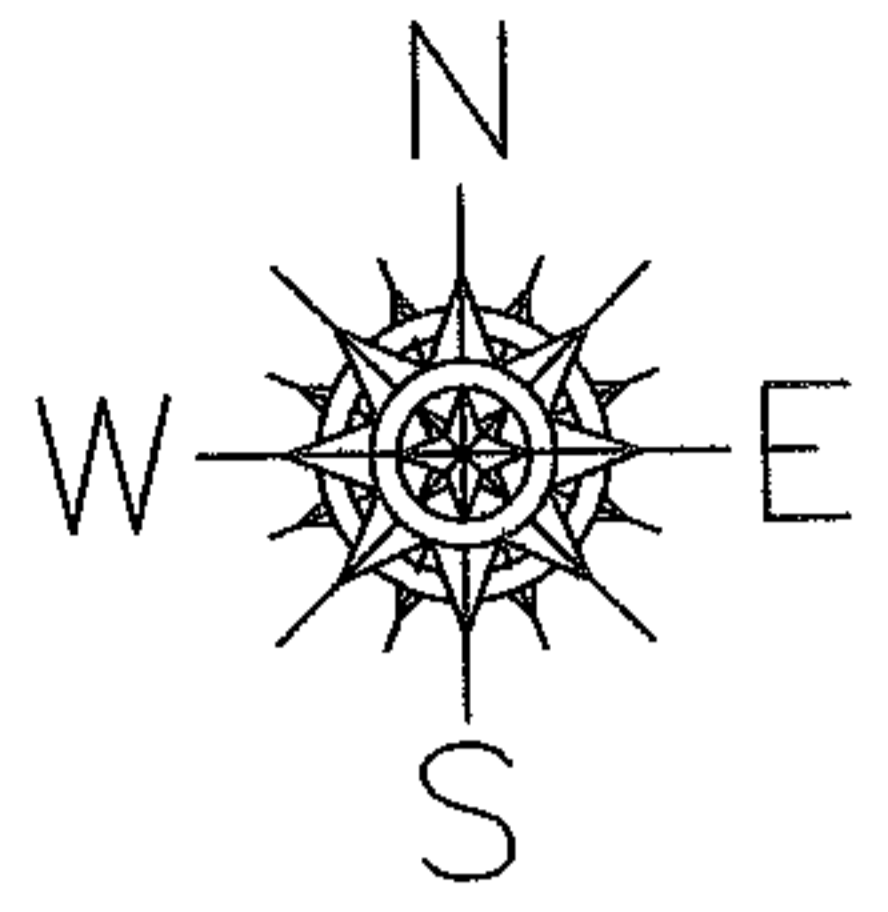

ADD TO DUPLICATE

04-00-017-103-233
2.11 A.


DROP FROM DUPLICATE

04-00-017-103-234
1.24 A.

WENT INTO

04-00-017-103-235
0.91 A.

-234 SHOULD HAVE GONE INTO PLAT
NOT -233
#05-00934

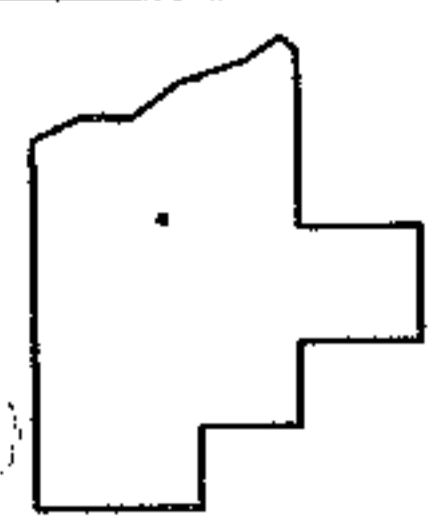

SPLITS/DEEDS PROCESSED
LORAIN COUNTY TAX MAP DEPARTMENT
226 MIDDLE AVE. ELYRIA, OHIO

SURVEYED BY: XXXXXXXXXX
CLOSURE: XXXXXX
MAP PAGE(S): 4-00-017-D
APPROVED BY: TJS DATE: 2/1/06
SCALE: 1"=100 PRIOR INSTRUMENT: DV XXXX/XXX