


RASTER

PARENT PARCEL: 18-00-042-000-014, 18-00-043-000-006



CHILD PARCEL: --SAME--

STARTING POINT: INT CL PECK-WADSWORTH RD AND PITTS RD

06-01277-C

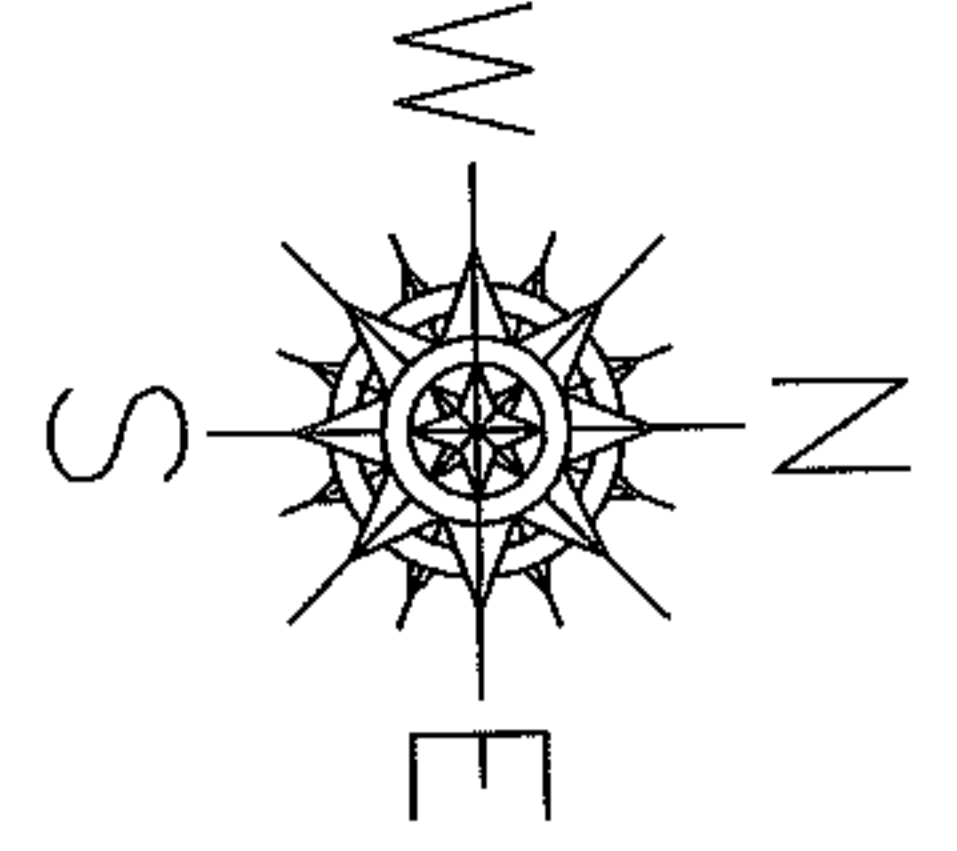

AC. CORR.  
PER SURVEY  
THOMAS M. SNEZEK  
PECK  
WADSWORTH RD

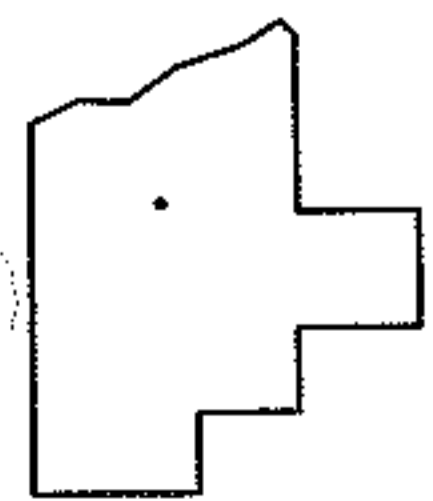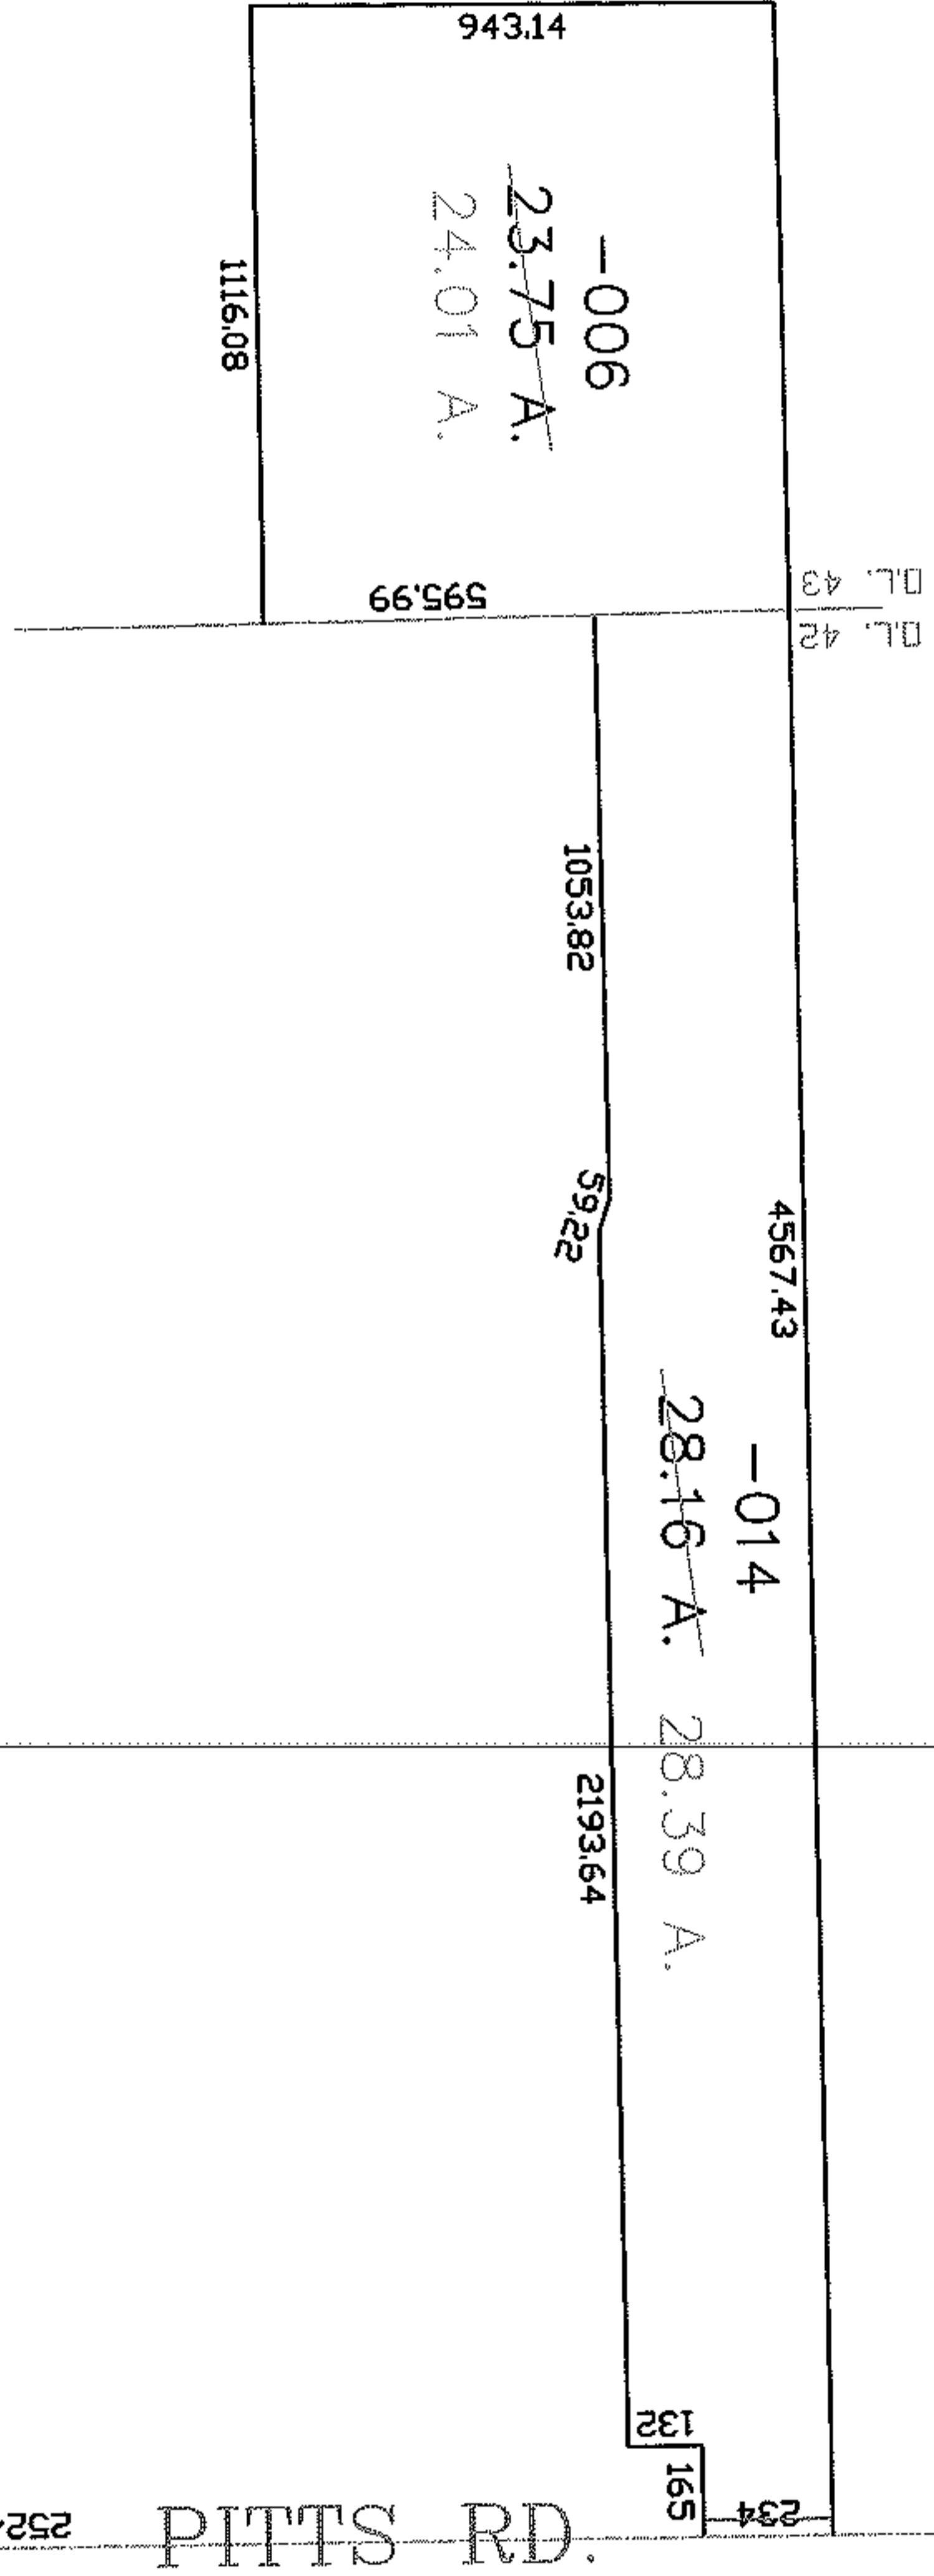

SPLITS/DEEDS PROCESSED

LORAIN COUNTY TAX MAP DEPARTMENT  
226 MIDDLE AVE. ELYRIA, OHIO

SURVEYED BY: THOMAS M. SNEZEK  
 CLOSURE: 1:10,000  
 MAP PAGE(S): 18-00-043-B  
 APPROVED BY: DRH DATE: 3/1/2006  
 SCALE: 1"=600' PRIOR INSTRUMENT: 19990595920