

MASTER




PARENT PARCEL: 08-13-017-000-010

CHILD PARCEL: --SAME--

STARTING POINT:

06-01280-C

AC. CORR.
PER SURVEY
C. WARYU

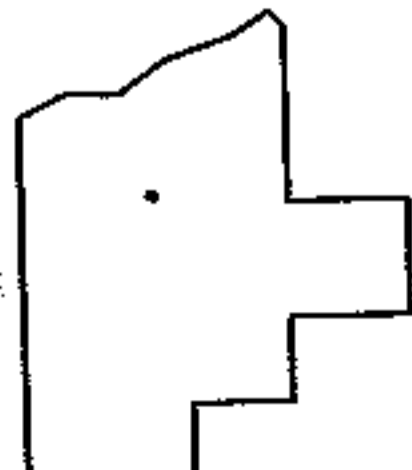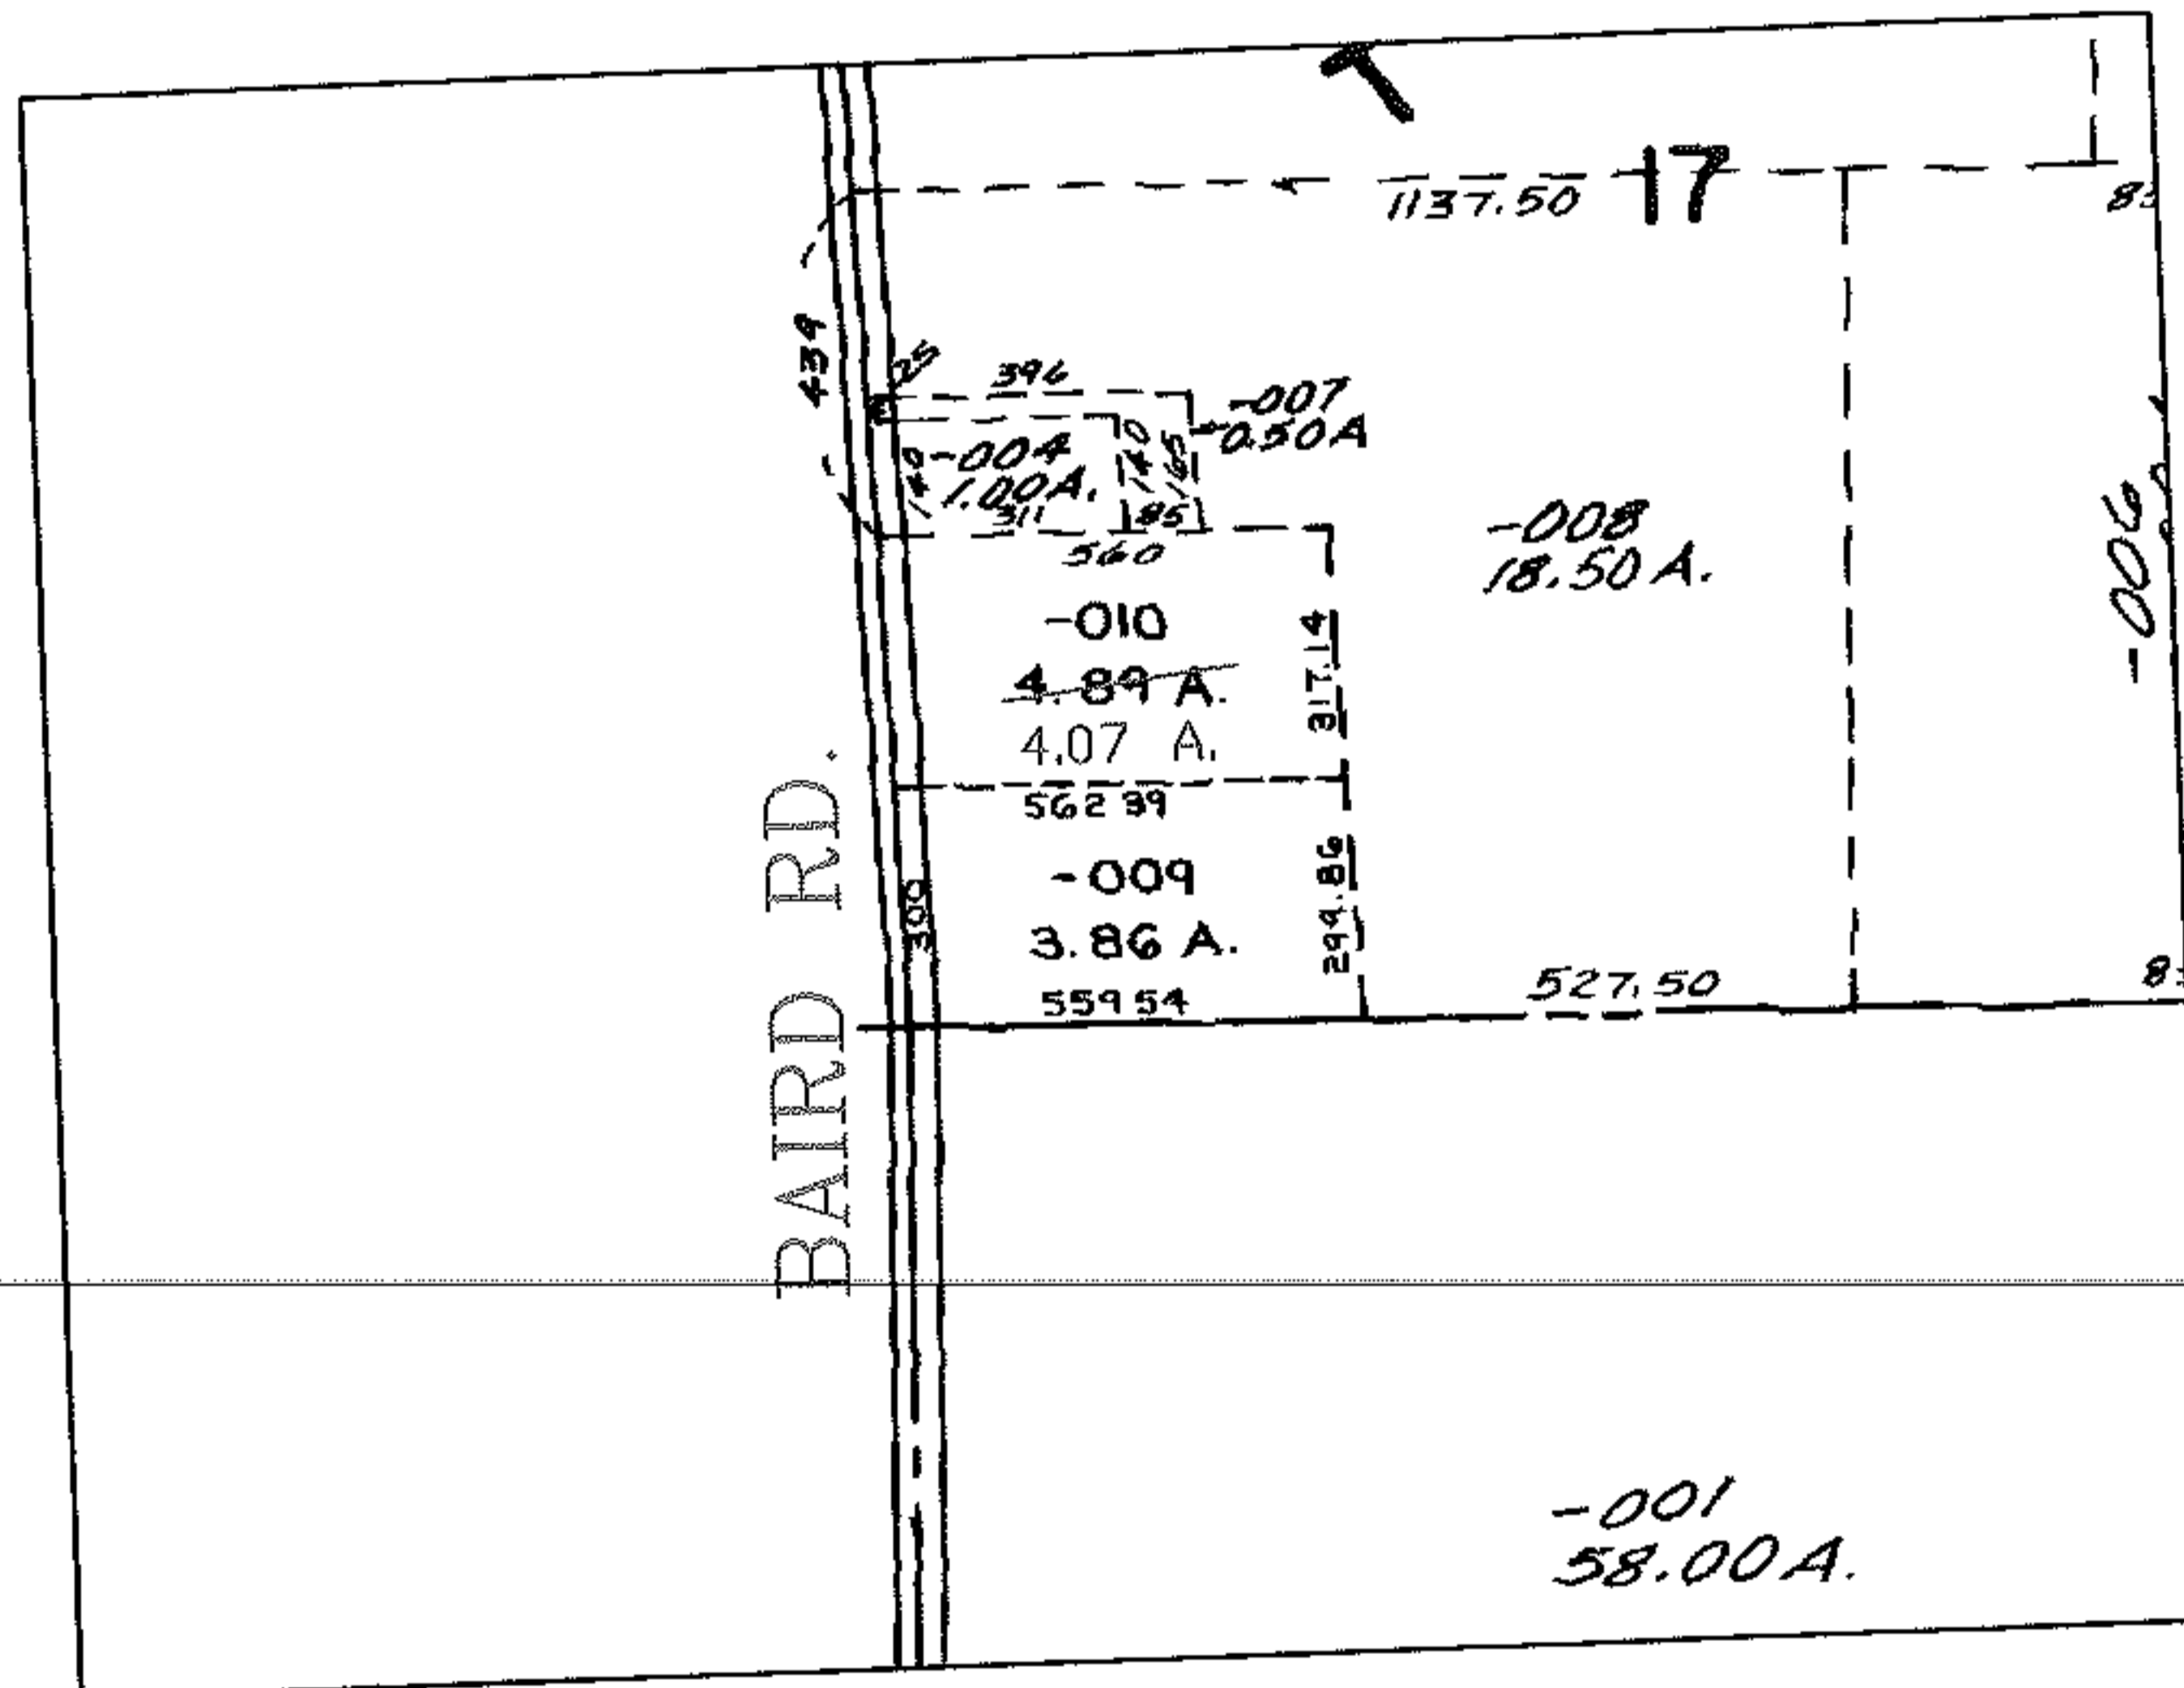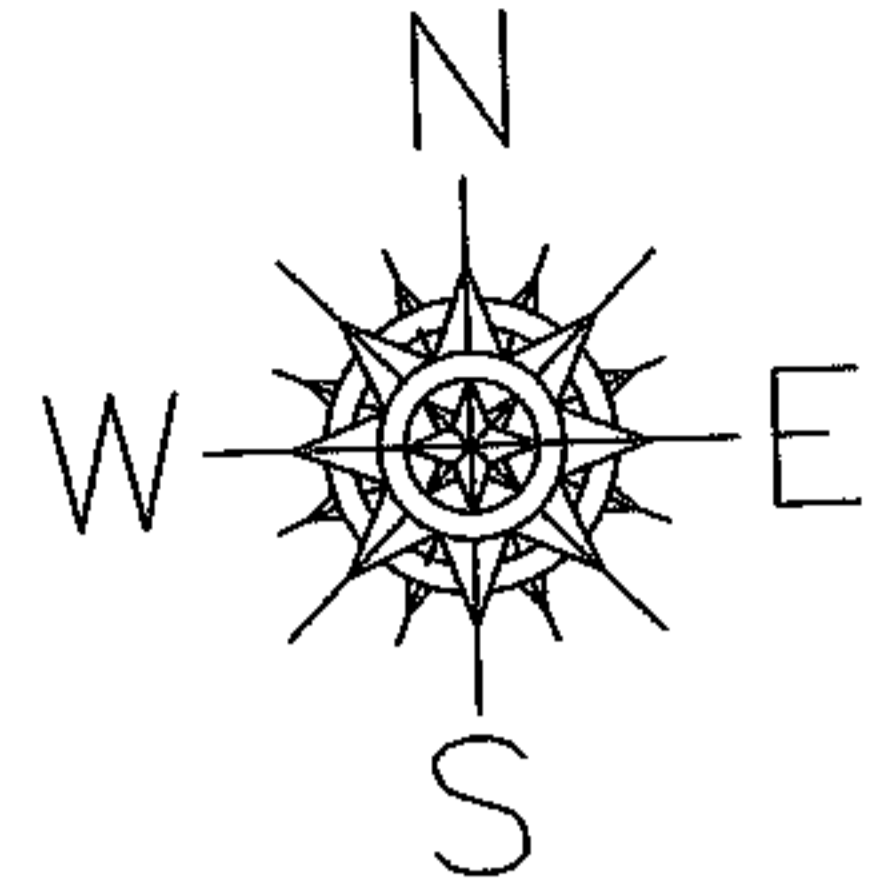

SPLITS/DEEDS PROCESSED
LORAIN COUNTY TAX MAP DEPARTMENT
226 MIDDLE AVE. ELYRIA, OHIO

SURVEYED BY: CHARLES P. WARYU
CLOSURE: 1:10,000
MAP PAGE(S): 8-F
APPROVED BY: DRH DATE: 2/20/2006
SCALE: 1" = 200' PRIOR INSTRUMENT: