




RASTER

PARENT PARCEL: _____
CHILD PARCEL: _____
STARTING POINT: ALLEY FROM EAST LINE OF INDIANA TO W LINE OF ILLINOIS

06-01288-Z

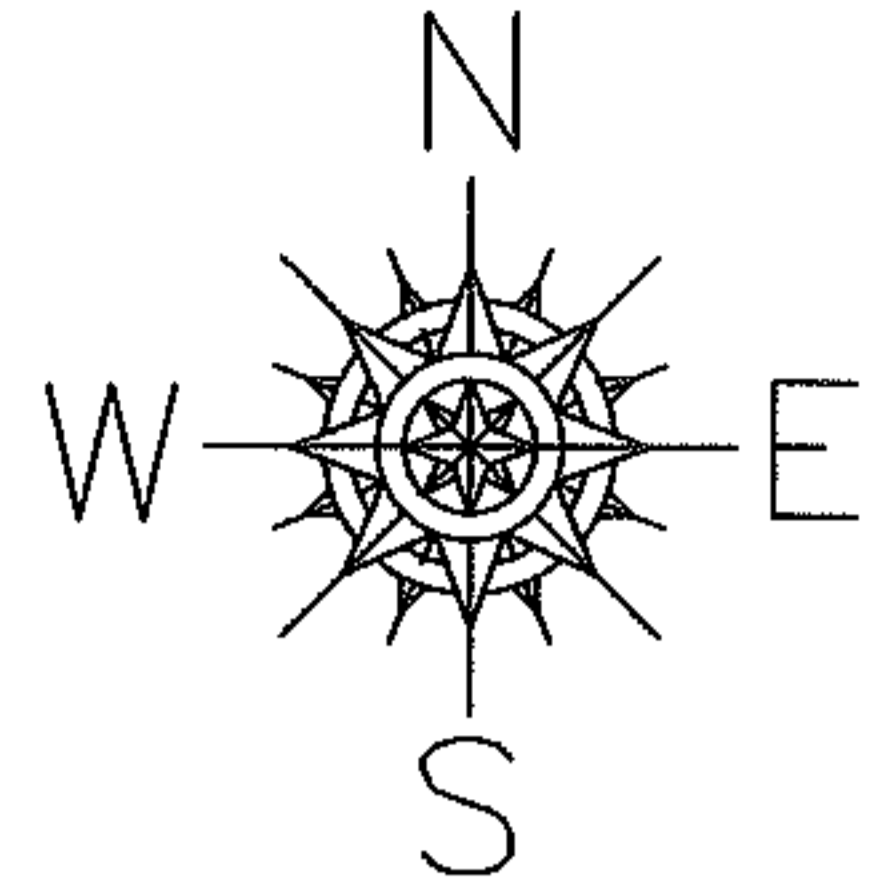

VACATION ORDINANCE 147-02

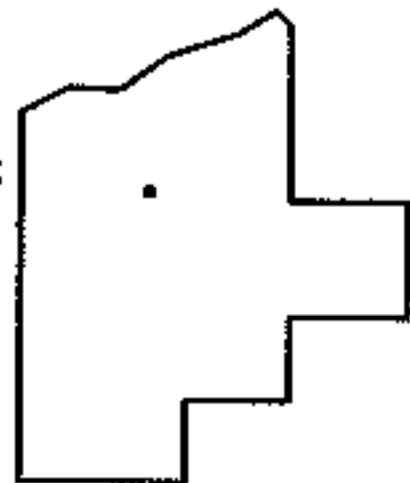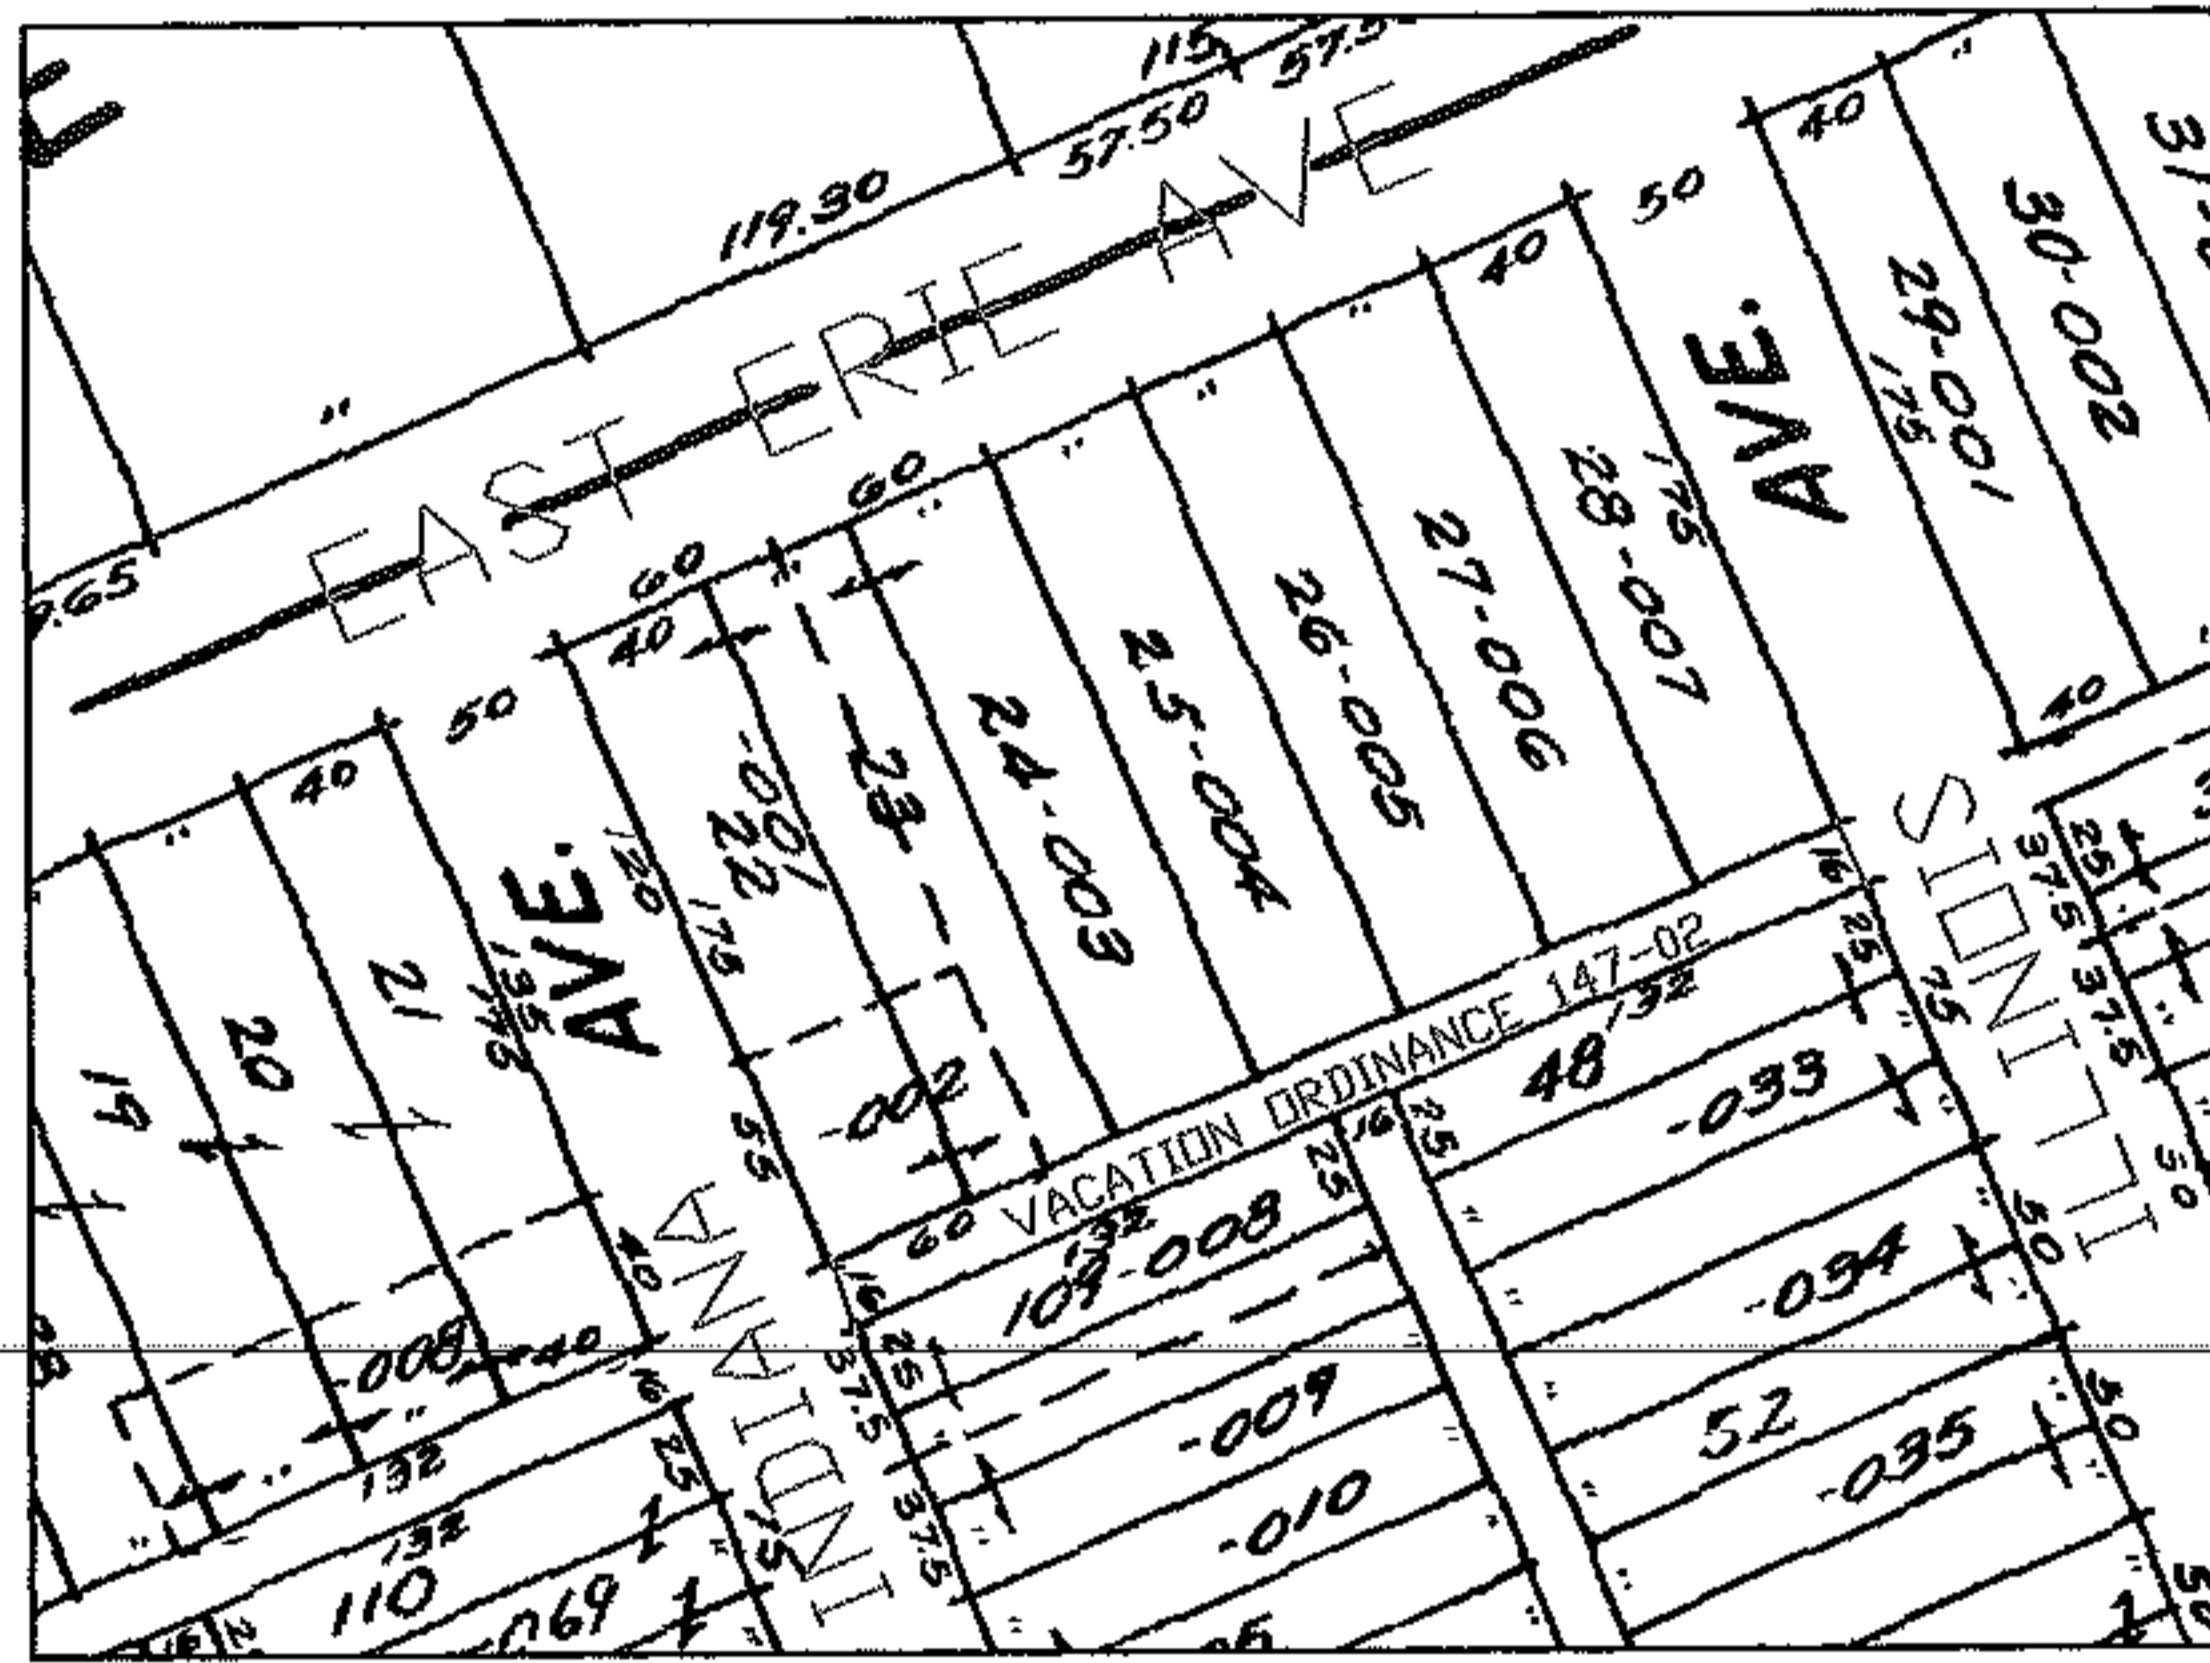

SPLITS/DEEDS PROCESSED

LORAIN COUNTY TAX MAP DEPARTMENT
226 MIDDLE AVE. ELYRIA, OHIO

SURVEYED BY: _____
CLOSURE: _____
MAP PAGE(S): 02-00-051-A
APPROVED BY: DRH DATE: 6/15/2006
SCALE: 1" = 200' PRIOR INSTRUMENT: _____