
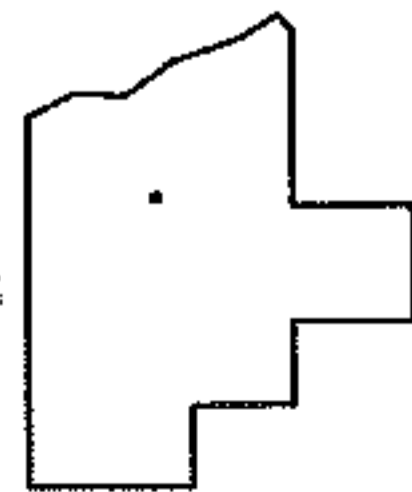
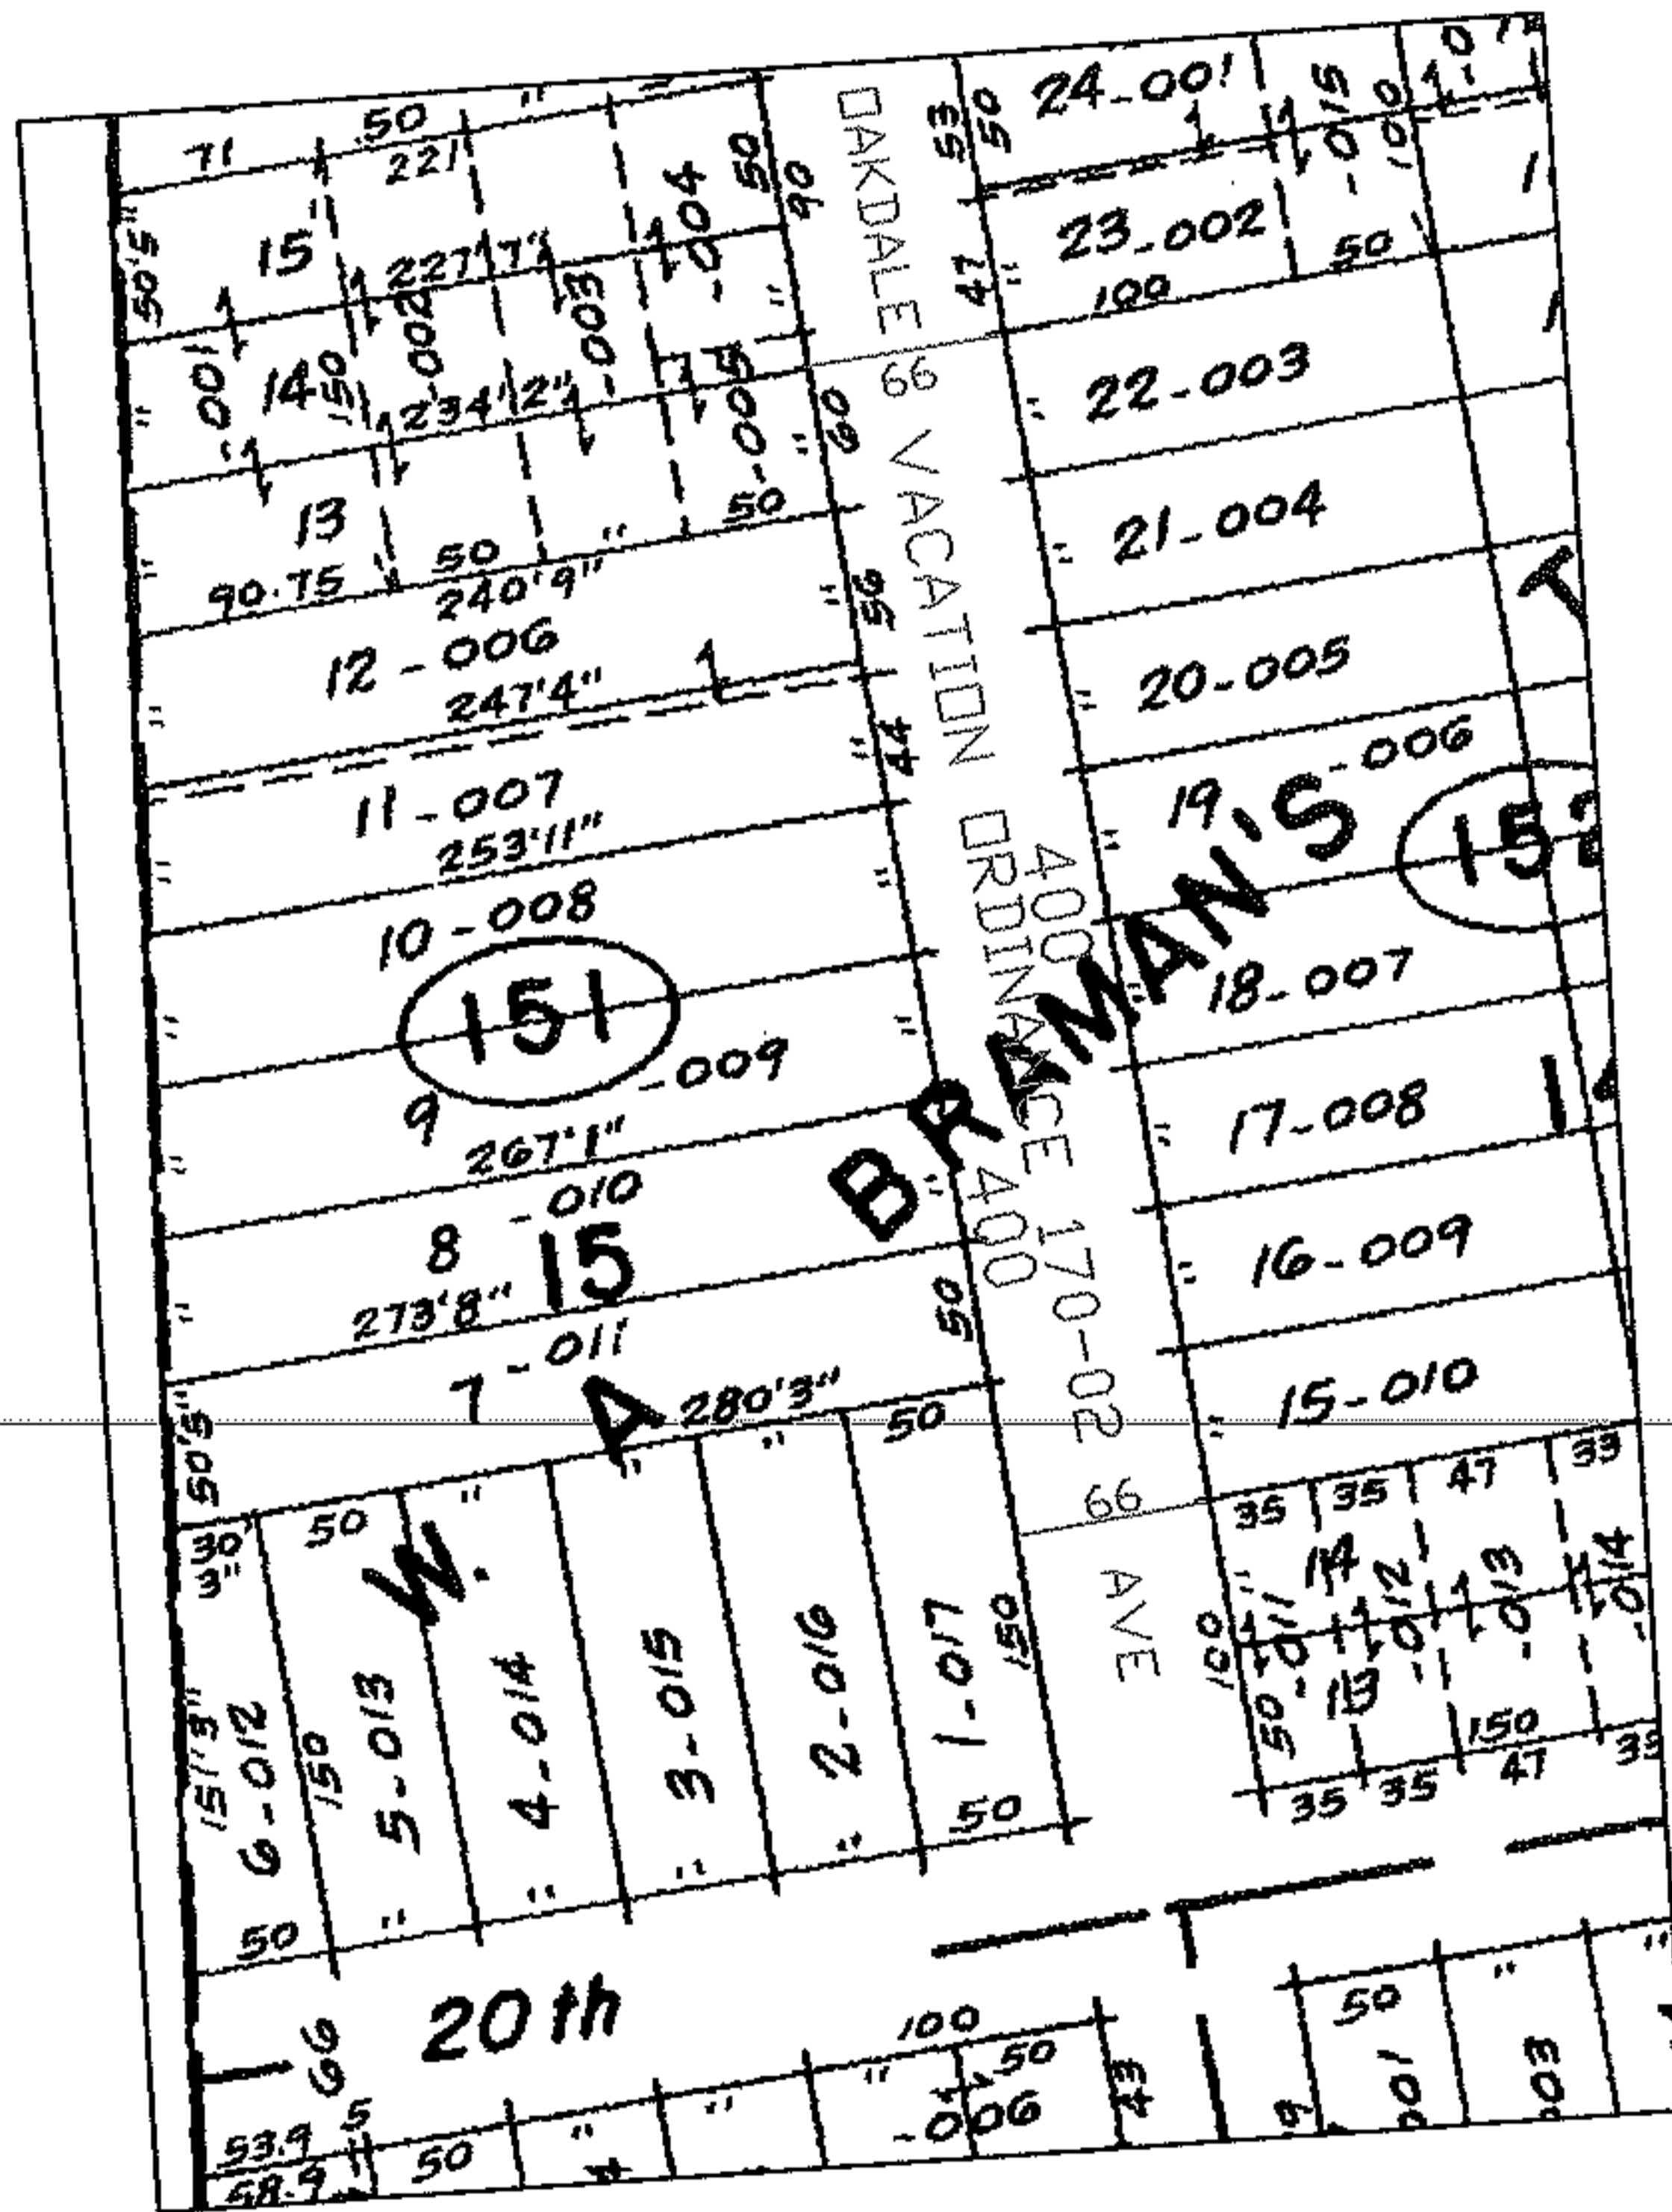


PARENT PARCEL: _____
CHILD PARCEL: _____
STARTING POINT: OAKDALE AVE 100 FEET NORTH OF 20TH ST

06-01290-Z

VACATION ORDINANCE 170-02

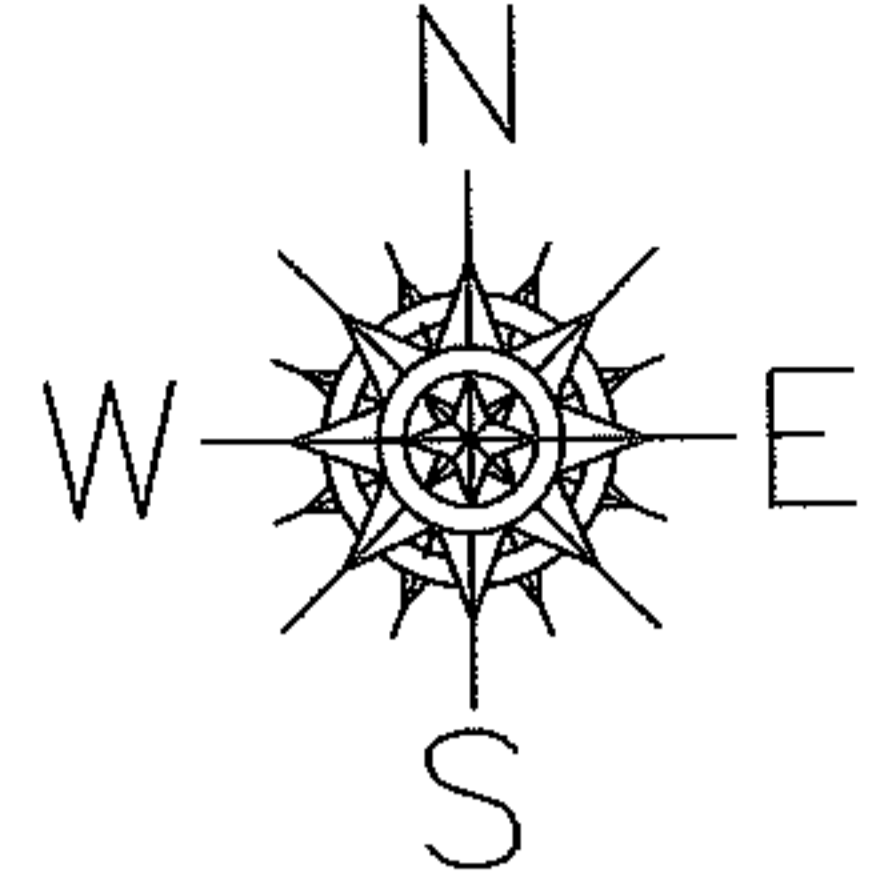

SPLITS/DEEDS PROCESSED
LORAIN COUNTY TAX MAP DEPARTMENT
226 MIDDLE AVE. ELYRIA, OHIO

SURVEYED BY: _____
CLOSURE: _____
MAP PAGE(S): 02-01-003-E
APPROVED BY: DRH DATE: 6/15/2006
SCALE: 1" = 200' PRIOR INSTRUMENT: _____