

RASTER




PARENT PARCEL: 02-01-006-145-036

CHILD PARCEL: --SAME--

STARTING POINT: SUBLOT 88

06-01296-C

DEPTH CORR PER PLAT

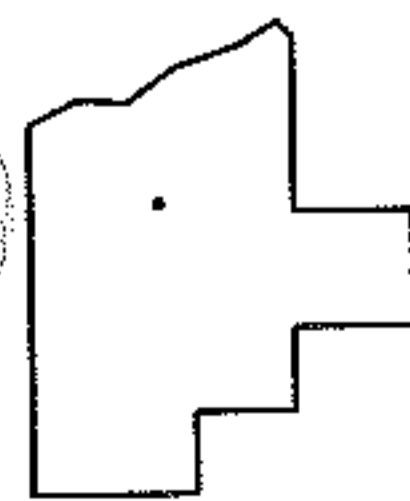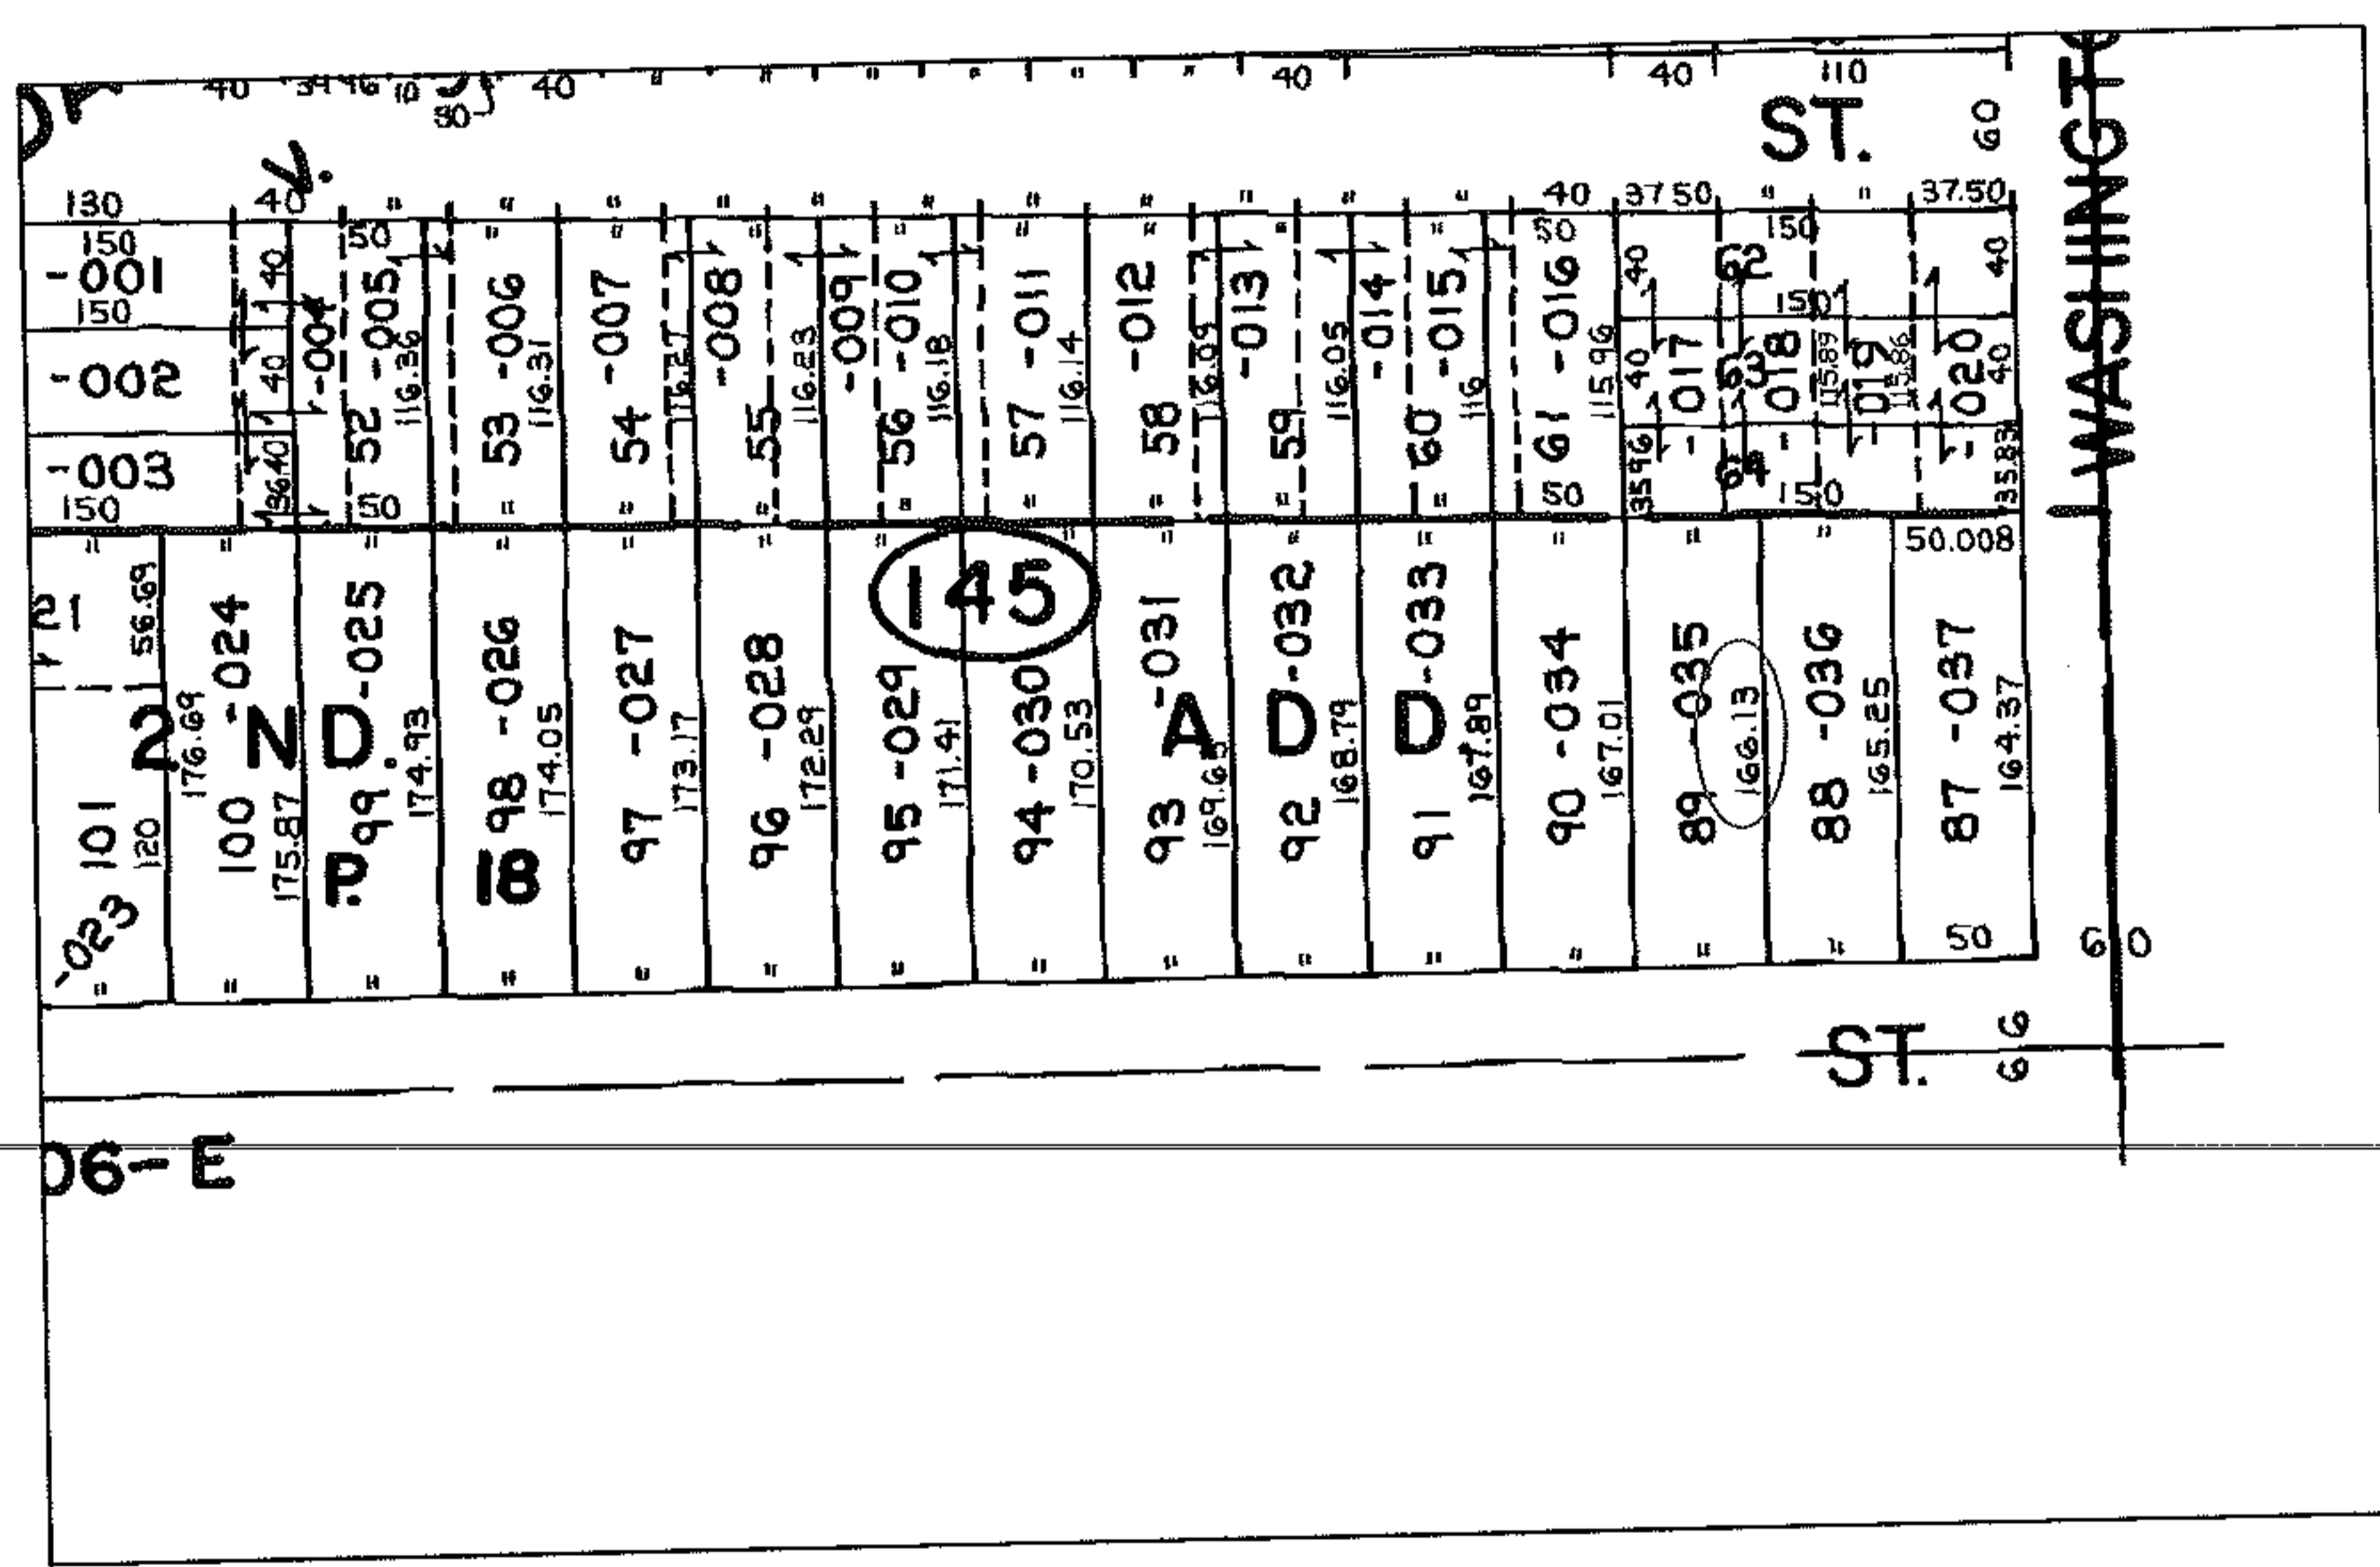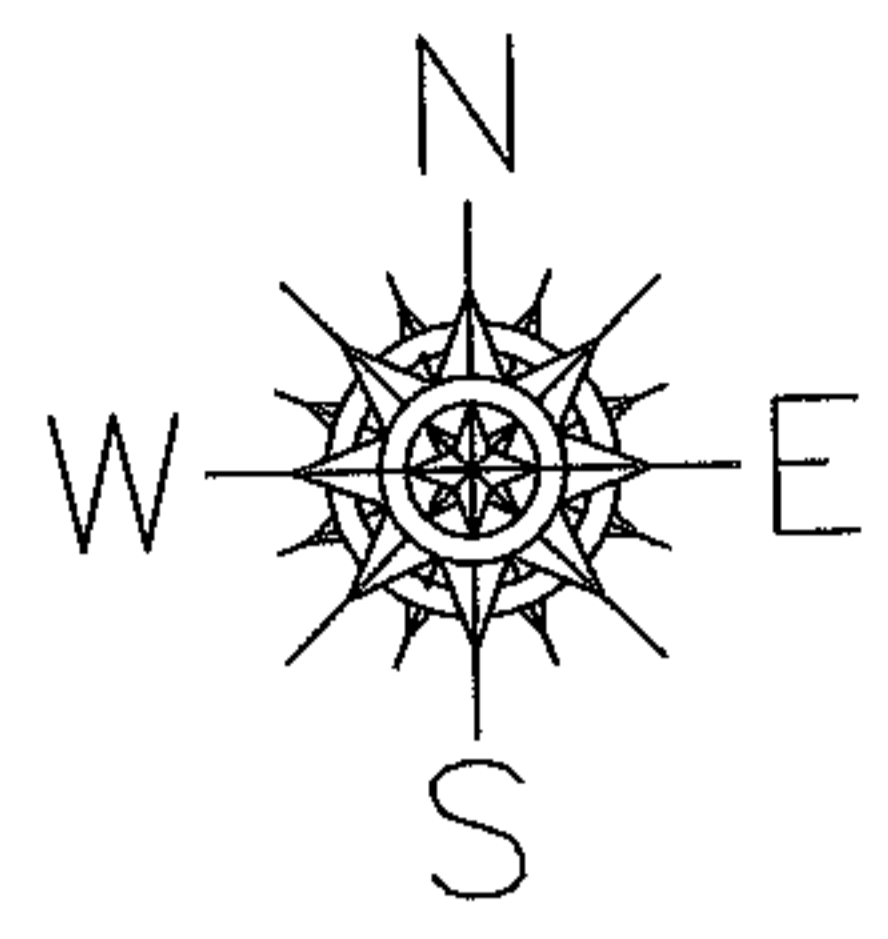

**SPLITS/DEEDS PROCESSED**  
 LORAIN COUNTY TAX MAP DEPARTMENT  
 226 MIDDLE AVE. ELYRIA, OHIO

SURVEYED BY: N/A  
 CLOSURE: N/A  
 MAP PAGE(S): 02-01-006-C  
 APPROVED BY: DRH DATE: 6/13/2006  
 SCALE: 1" = 200 PRIOR INSTRUMENT: