
DADENT	PARCEL: 07-00-028-103-062	-063
L WINTIA I	1 MIVEL-	


CHILD PARCEL: -- SAME--

06 - 01298 - A

STARTING POINT:\_\_

CORR PER DEED

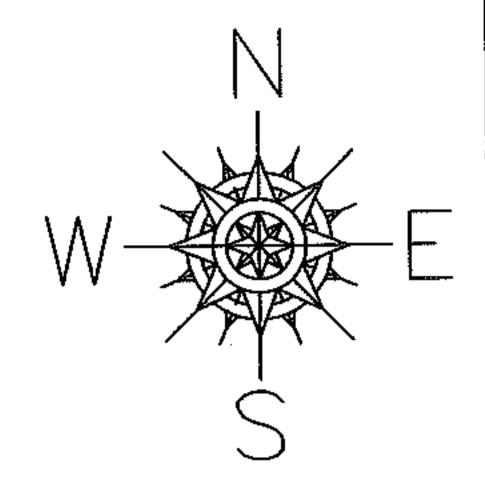

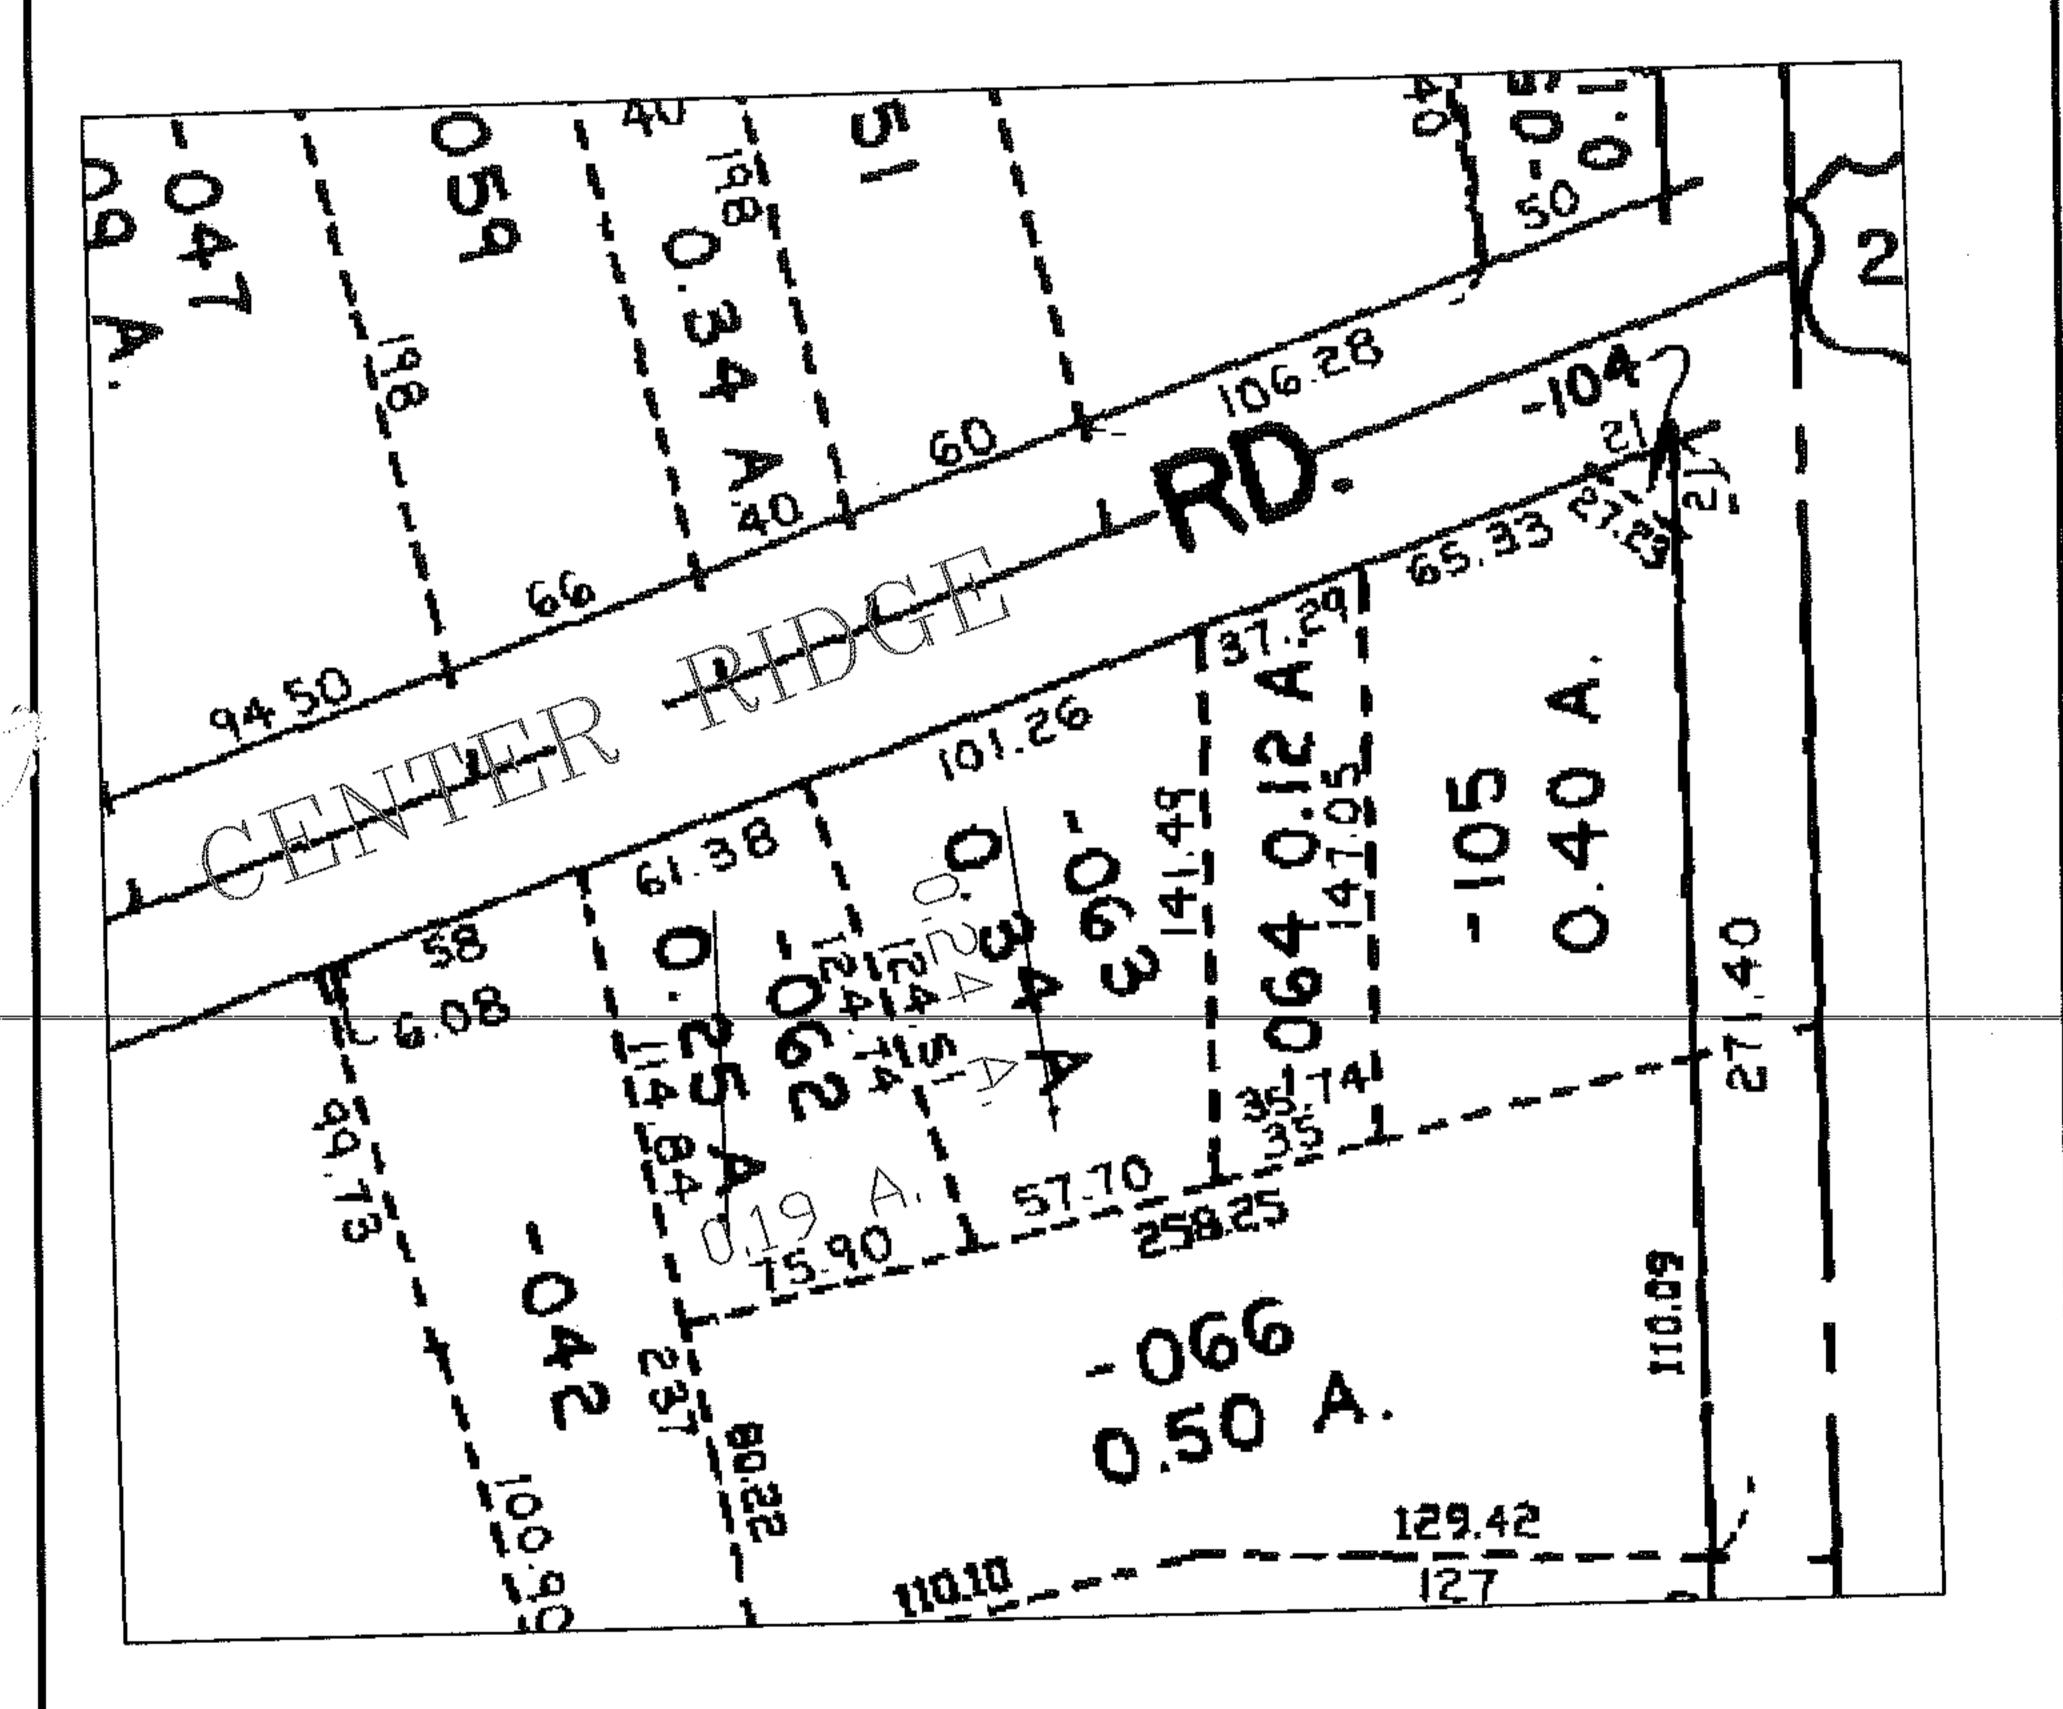

## SPLITS/DEEDS PROCESSED

LORAIN COUNTY TAX MAP DEPARTMENT 226 MIDDLE AVE. ELYRIA, OHIO

SURVEYED BY: N/A

CLOSURE: N/A

MAP PAGE(S): 07-00-028-D

APPROVED BY: DRH DATE: 3/14/2006

SCALE: 1"=100 PRIOR INSTRUMENT: 1256/267