


RASTER

PARENT PARCEL: 04-00-026-108-038

CHILD PARCEL: 04-00-026-103-061

STARTING POINT: PARCEL RE-NUMBER

NO. 01305-C

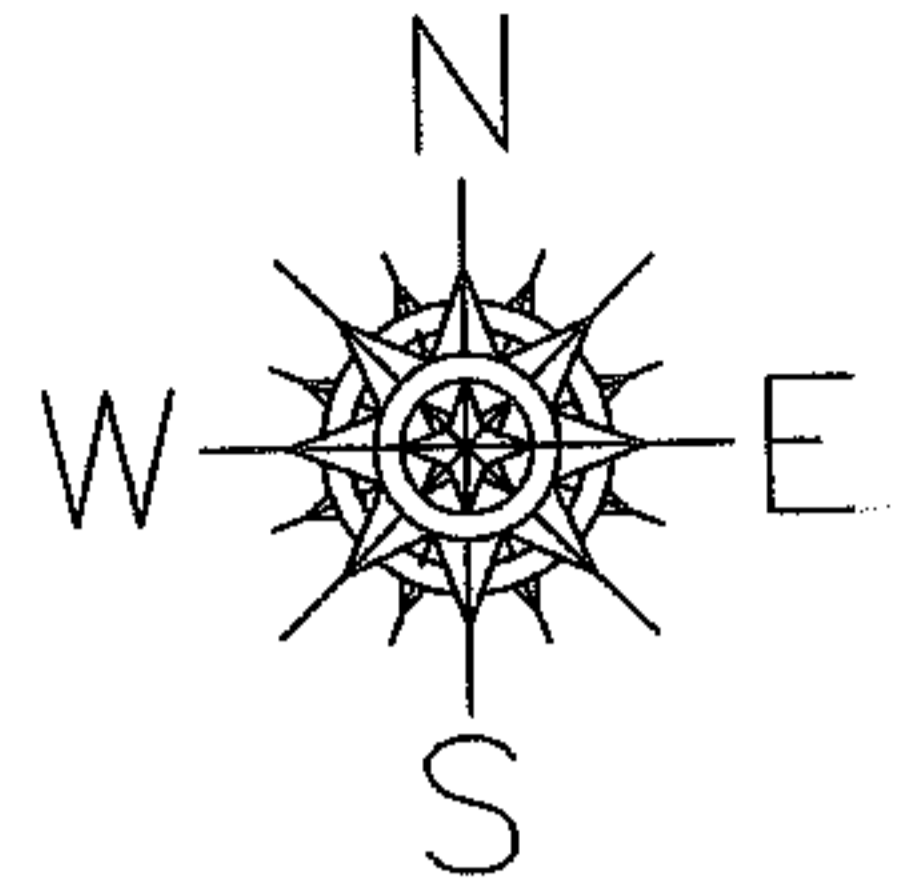

PARCEL RE-NUMBER

~~04-00-026-108-038~~

~~0.69 A.~~

04-00-026-103-061

0.69 A.

SPLITS/DEEDS PROCESSED

LORAIN COUNTY TAX MAP DEPARTMENT
226 MIDDLE AVE. ELYRIA, OHIO

SURVEYED BY: XXXXXXXXXXXX

CLOSURE: XXXXXX

MAP PAGE(S): 04-00-026-B

APPROVED BY: TJS DATE: 3/20/06

SCALE: 1" = 100 PRIOR INSTRUMENT: DV XXXX/XXX