

MASTER



PARENT PARCEL: 05-00-055-000-001, -002, -003

06-01306-Z


CHILD PARCEL: 05-00-055-000-040 & -041

STARTING POINT: INT NORTH LINE OF LOTS 34, 47 AND CL OF S.R. 58

NOT TO SCALE

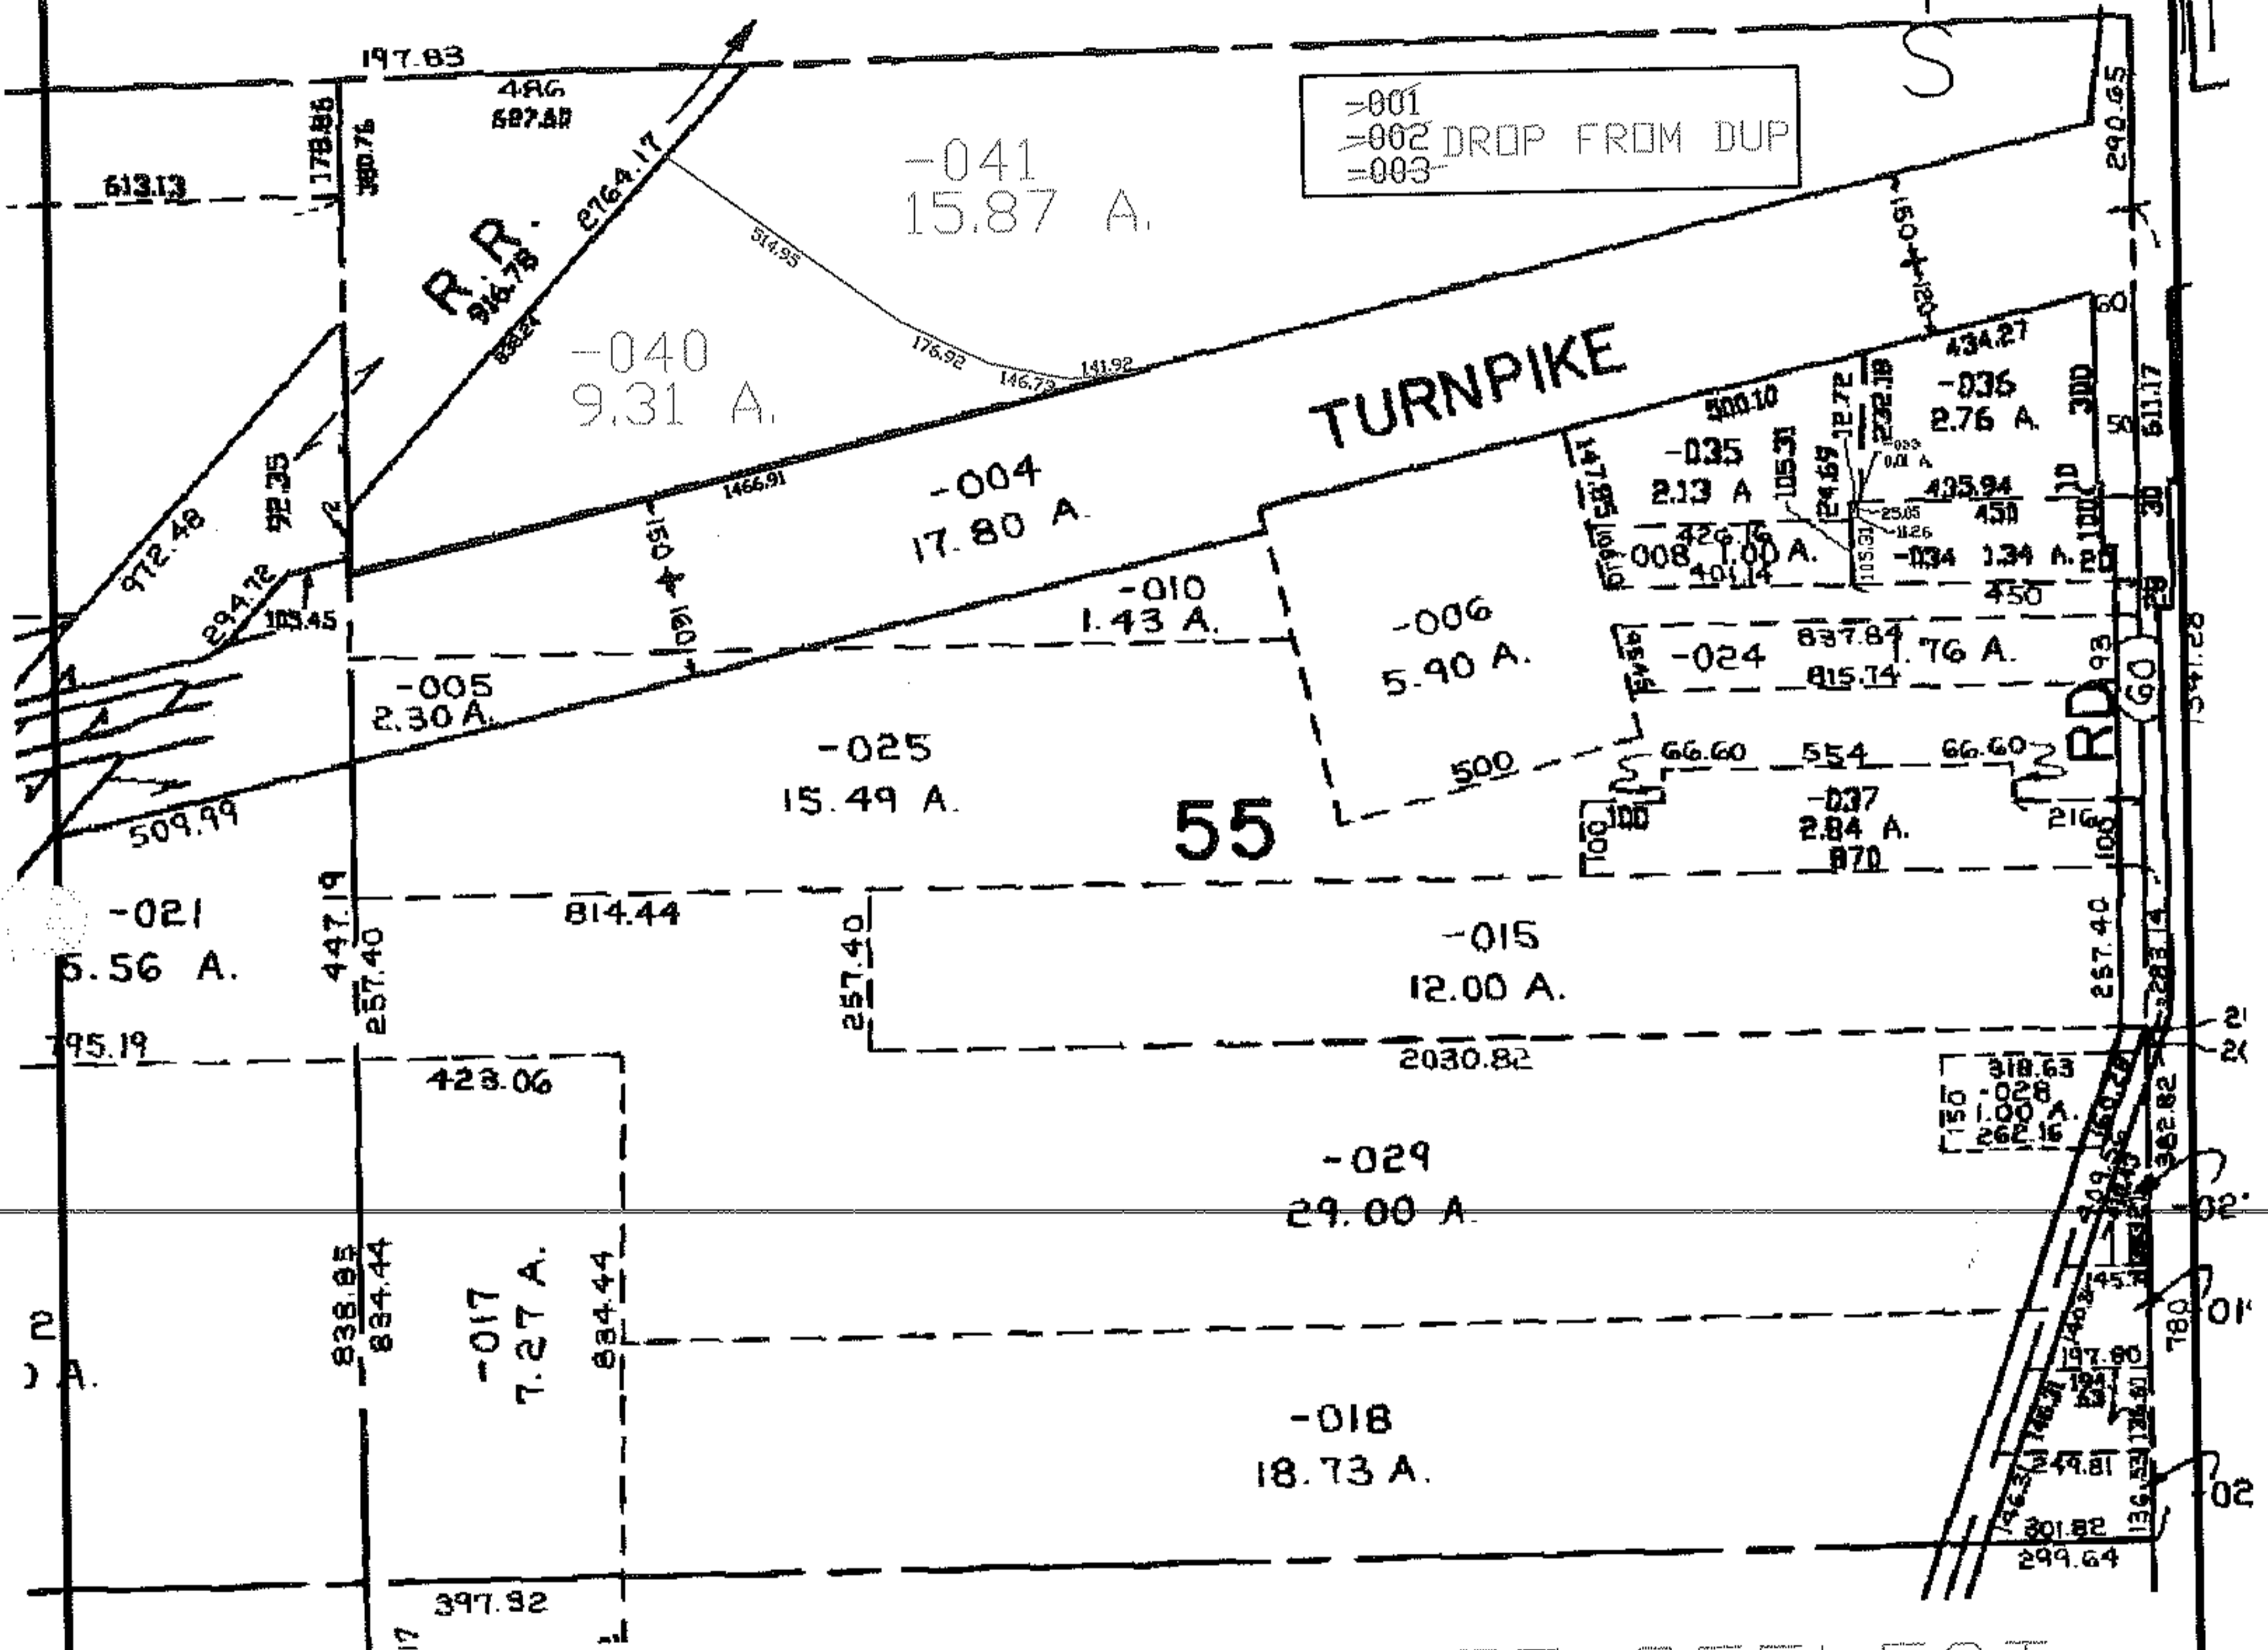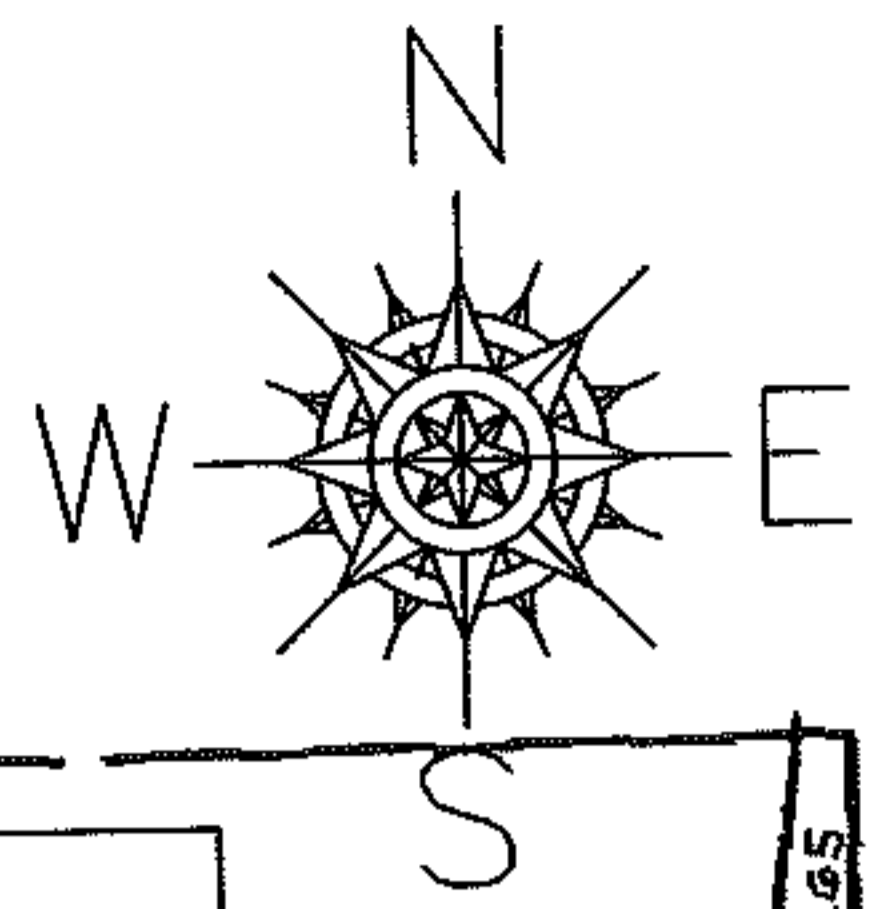

ADD AND DROPS DONE TO REFLECT JUDGEMENT FOR CASE #04CV139723

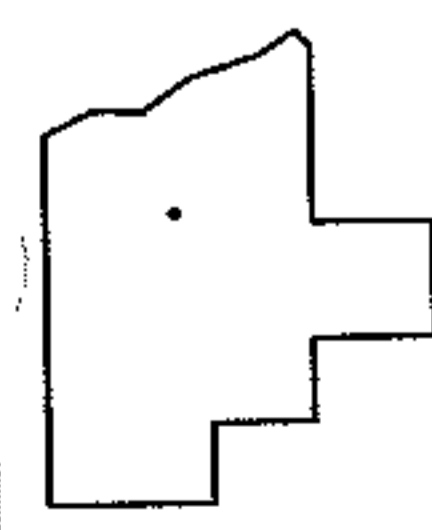

SPLITS/DEEDS PROCESSED

LORAIN COUNTY TAX MAP DEPARTMENT
226 MIDDLE AVE. ELYRIA, OHIO

SURVEYED BY: N/A
CLOSURE: 1:1,726,000
MAP PAGE(S): 5-G
APPROVED BY: DRH DATE: 4/3/2006
SCALE: 1"= 500 PRIOR INSTRUMENT: