


RASTER

PARENT PARCEL: 04-00-003-104-026



CHILD PARCEL: 04-00-003-104-026 & -038

STARTING POINT: REMAINDER OF STONEBRIDGE CREEK SUB NO 6

06-01315-C

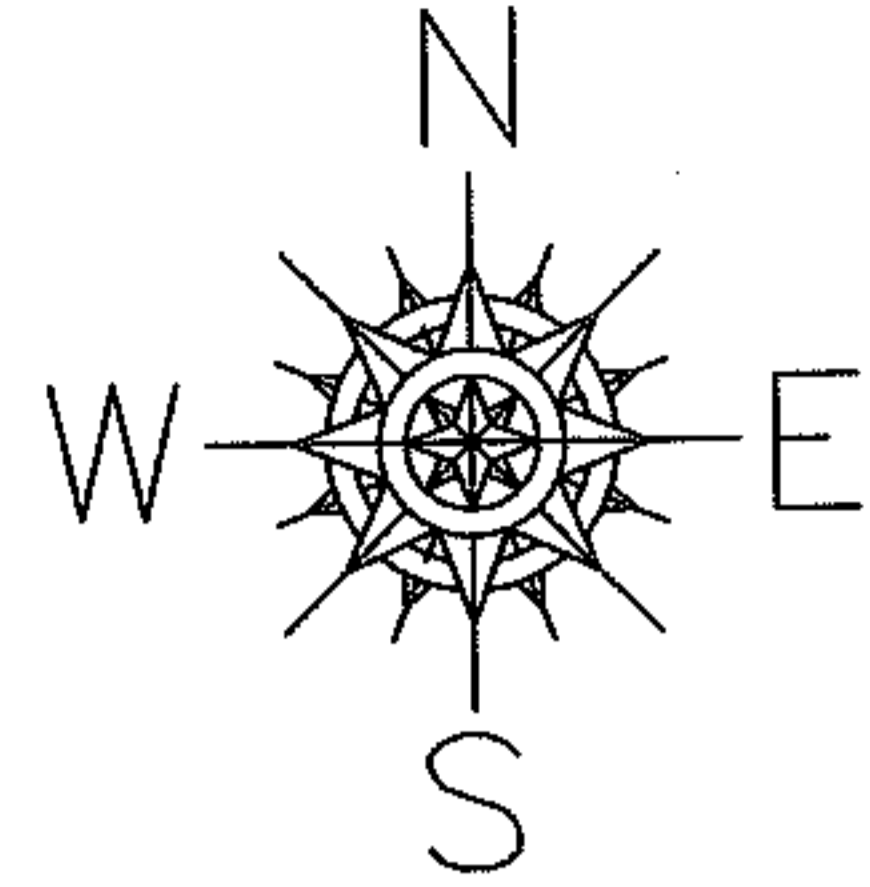

ADD TO DUP
04-00-003-104-038
CORR
04-00-003-104-026

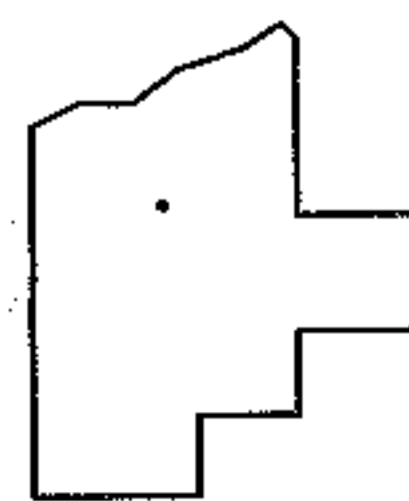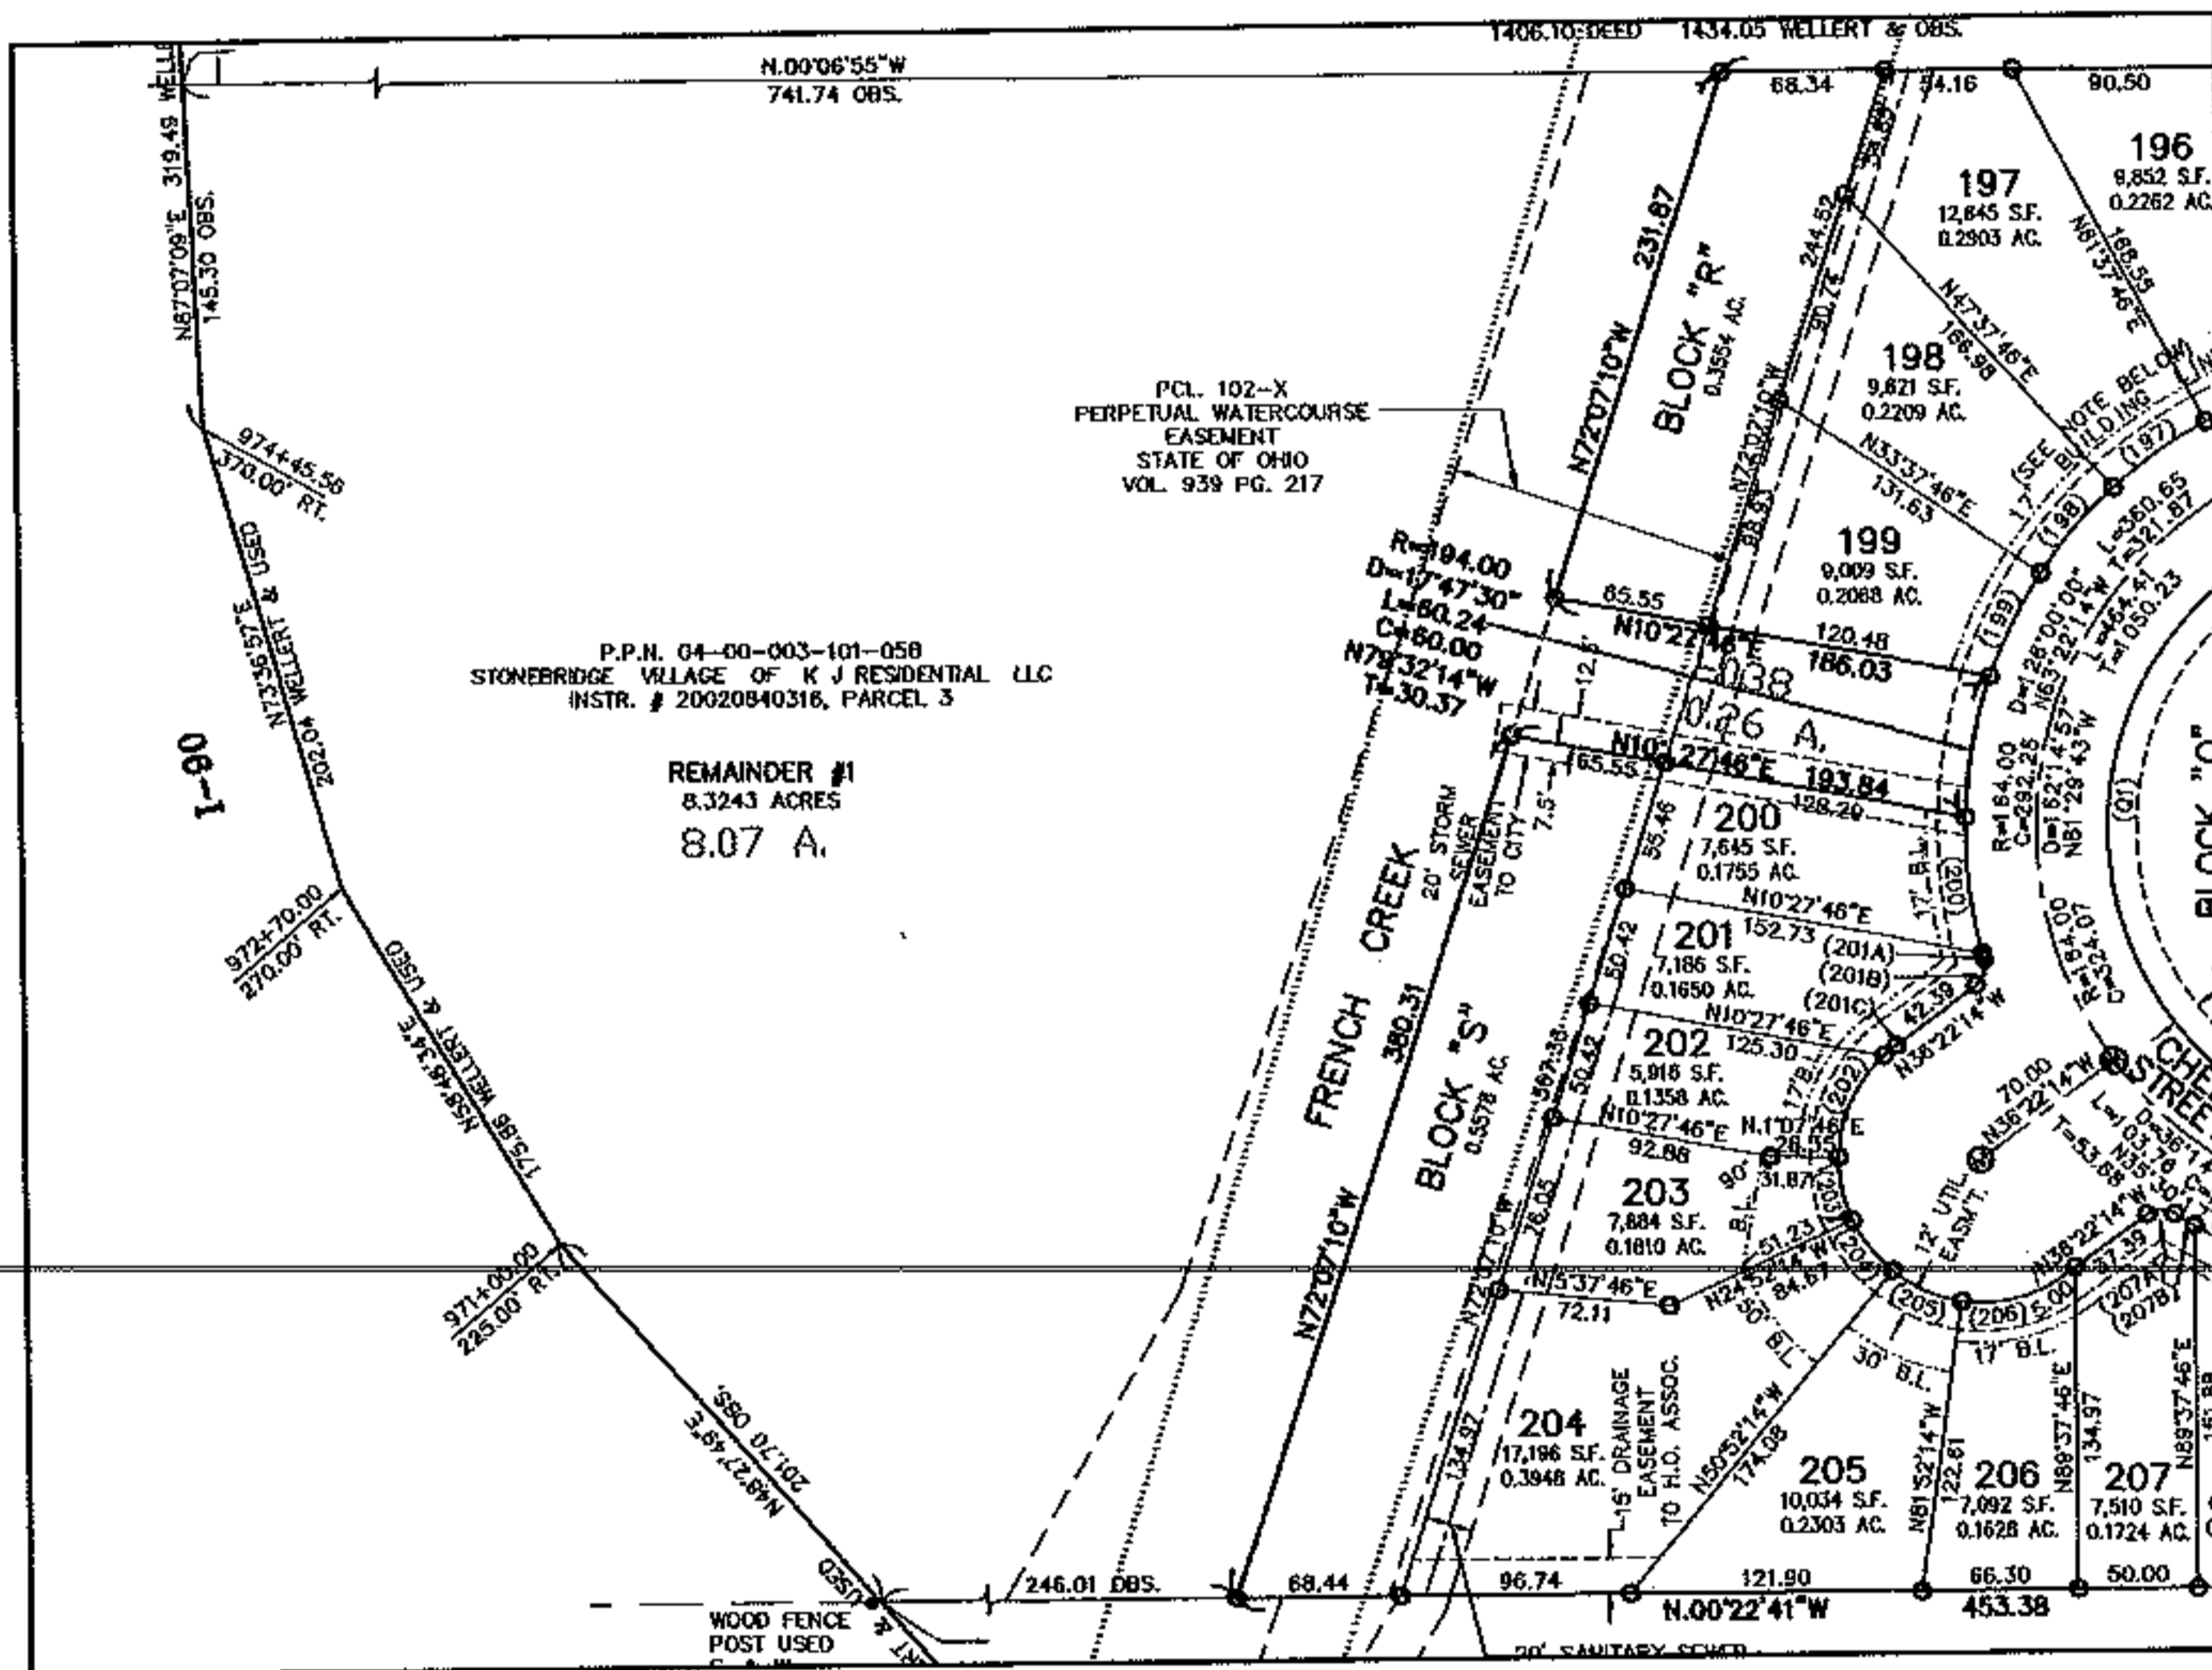

SPLITS/DEEDS PROCESSED
LORAIN COUNTY TAX MAP DEPARTMENT
226 MIDDLE AVE. ELYRIA, OHIO

SURVEYED BY: GUY P. HANEY
CLOSURE: 1:10,000
MAP PAGE(S): 04-00-003-C
APPROVED BY: DRH DATE: 3/30/2006
SCALE: 1" = 300' PRIOR INSTRUMENT: