


RASTER

PARENT PARCEL: 13-11-024-000-004

06-01325-D

CHILD PARCEL: --SAME--

STARTING POINT: INT BAIRD RD AND S.R. 20

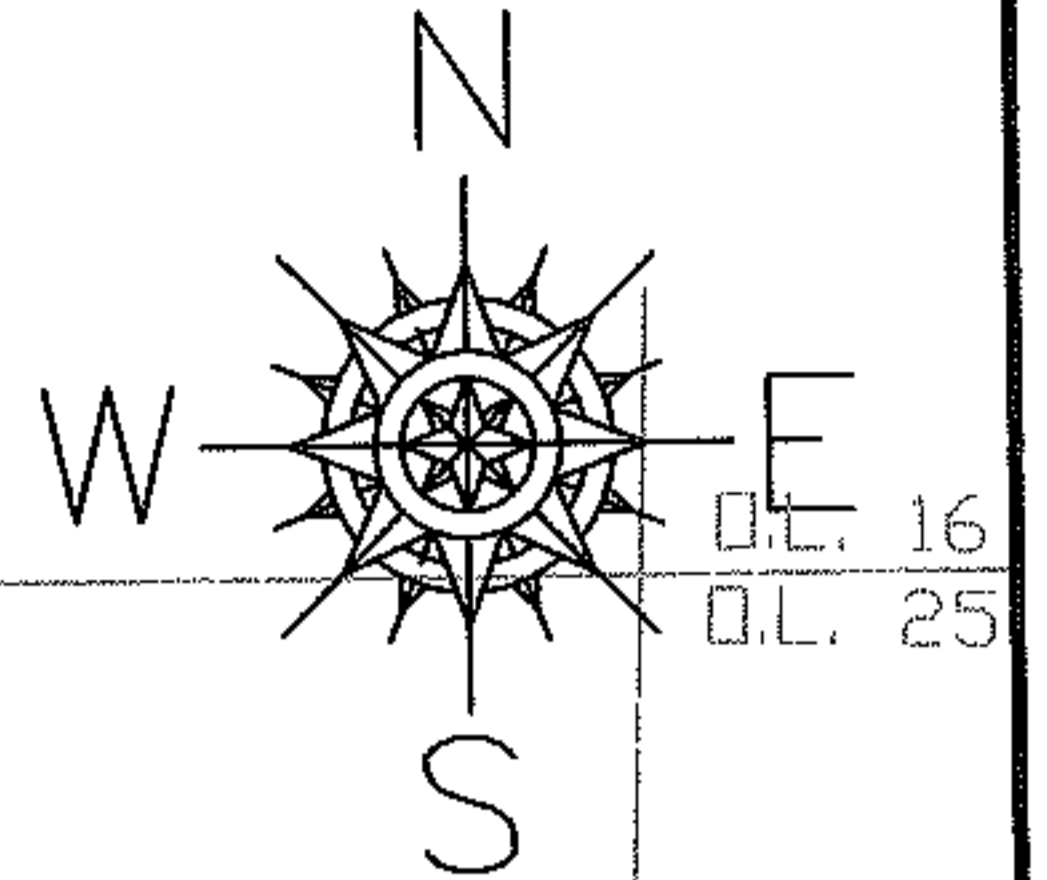

D.L. 17 D.L. 16
D.L. 24 D.L. 25

1633.34

175.00

300.00

AC. CORR.
PER SURVEY
EARL H. HUNTER

-004

~~87.69 A.~~

87.62 A.

2005.38

1829.18

D.L. 24
D.L. 25

55.00

S.R.


910.20

20

200.00



818.30

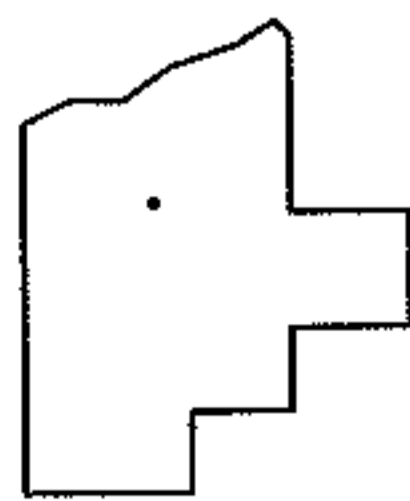

SPLITS/DEEDS PROCESSED
LORAIN COUNTY TAX MAP DEPARTMENT
226 MIDDLE AVE. ELYRIA, OHIO

SURVEYED BY: EARL H. HUNTER
CLOSURE: 1:10,000
MAP PAGE(S): ~~13-11-024-000-004~~ 13-B
APPROVED BY: DRH DATE: 4/17/2006
SCALE: 1" = 300' PRIOR INSTRUMENT: