



PARENT PARCEL: 04-00-030-136-063

CHILD PARCEL: 04-00-030-136-065, -066

STARTING POINT:

06-01329-V

VACATION OF BLOCK "D"
IN WESTWINDS SUB. NO. 6
VOL. 41 PGS.19-21
VAC. ORD. 248-2003

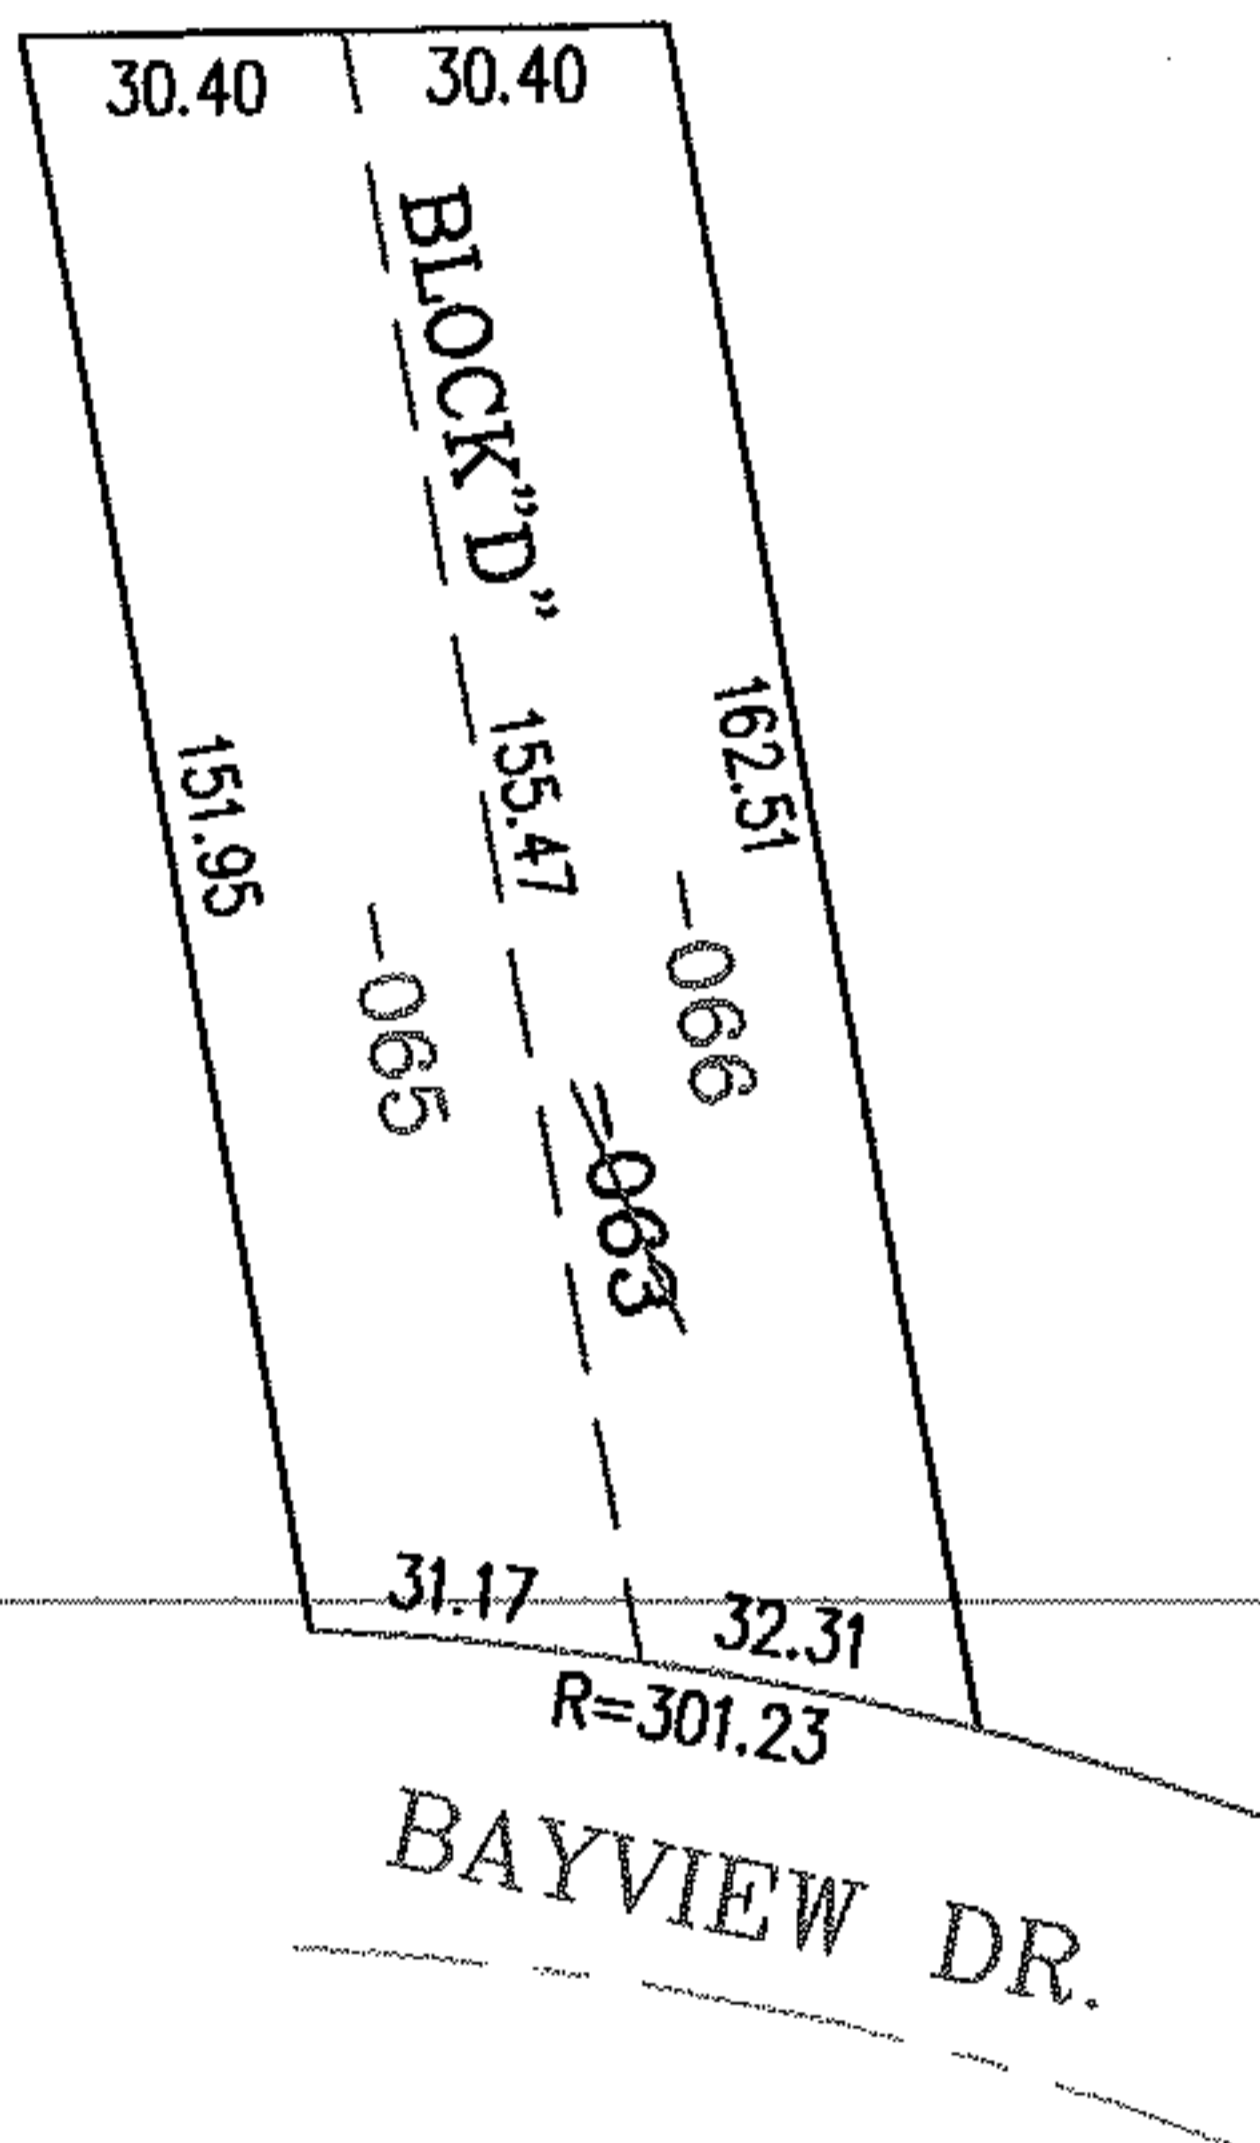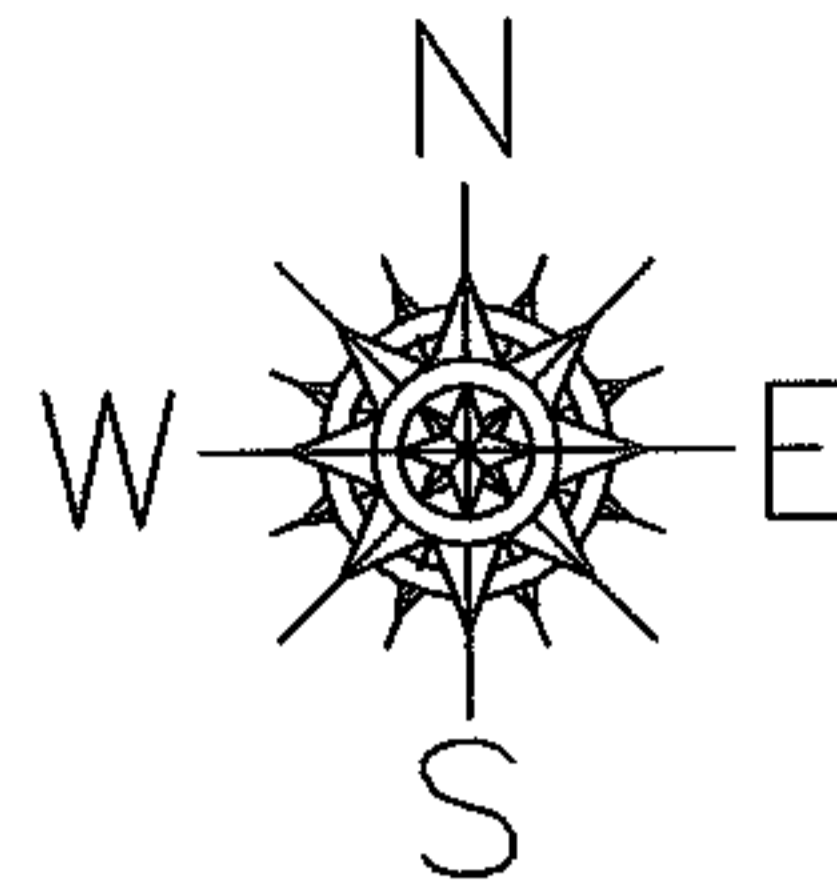

SPLITS/DEEDS PROCESSED

LORAIN COUNTY TAX MAP DEPARTMENT
226 MIDDLE AVE. ELYRIA, OHIO

SURVEYED BY: _____
CLOSURE: .01:10.000
MAP PAGE(S): 04-00-030-G
APPROVED BY: RRM DATE: 4/21/06
SCALE: 1"= 50 PRIOR INSTRUMENT: ORD.248-2003