




PARENT PARCEL: 11-00-089-000-023

06-01340-C

CHILD PARCEL: --SAME--

STARTING POINT:

BUTTERNUT RIDGE RD

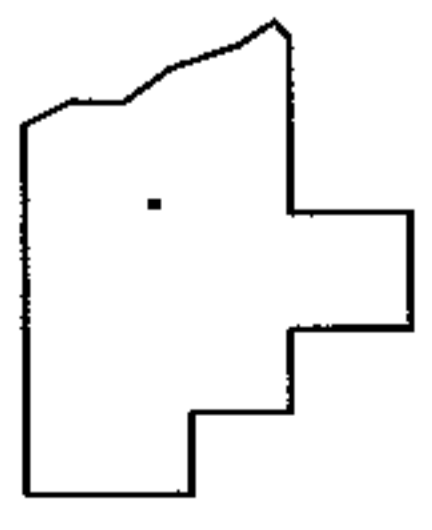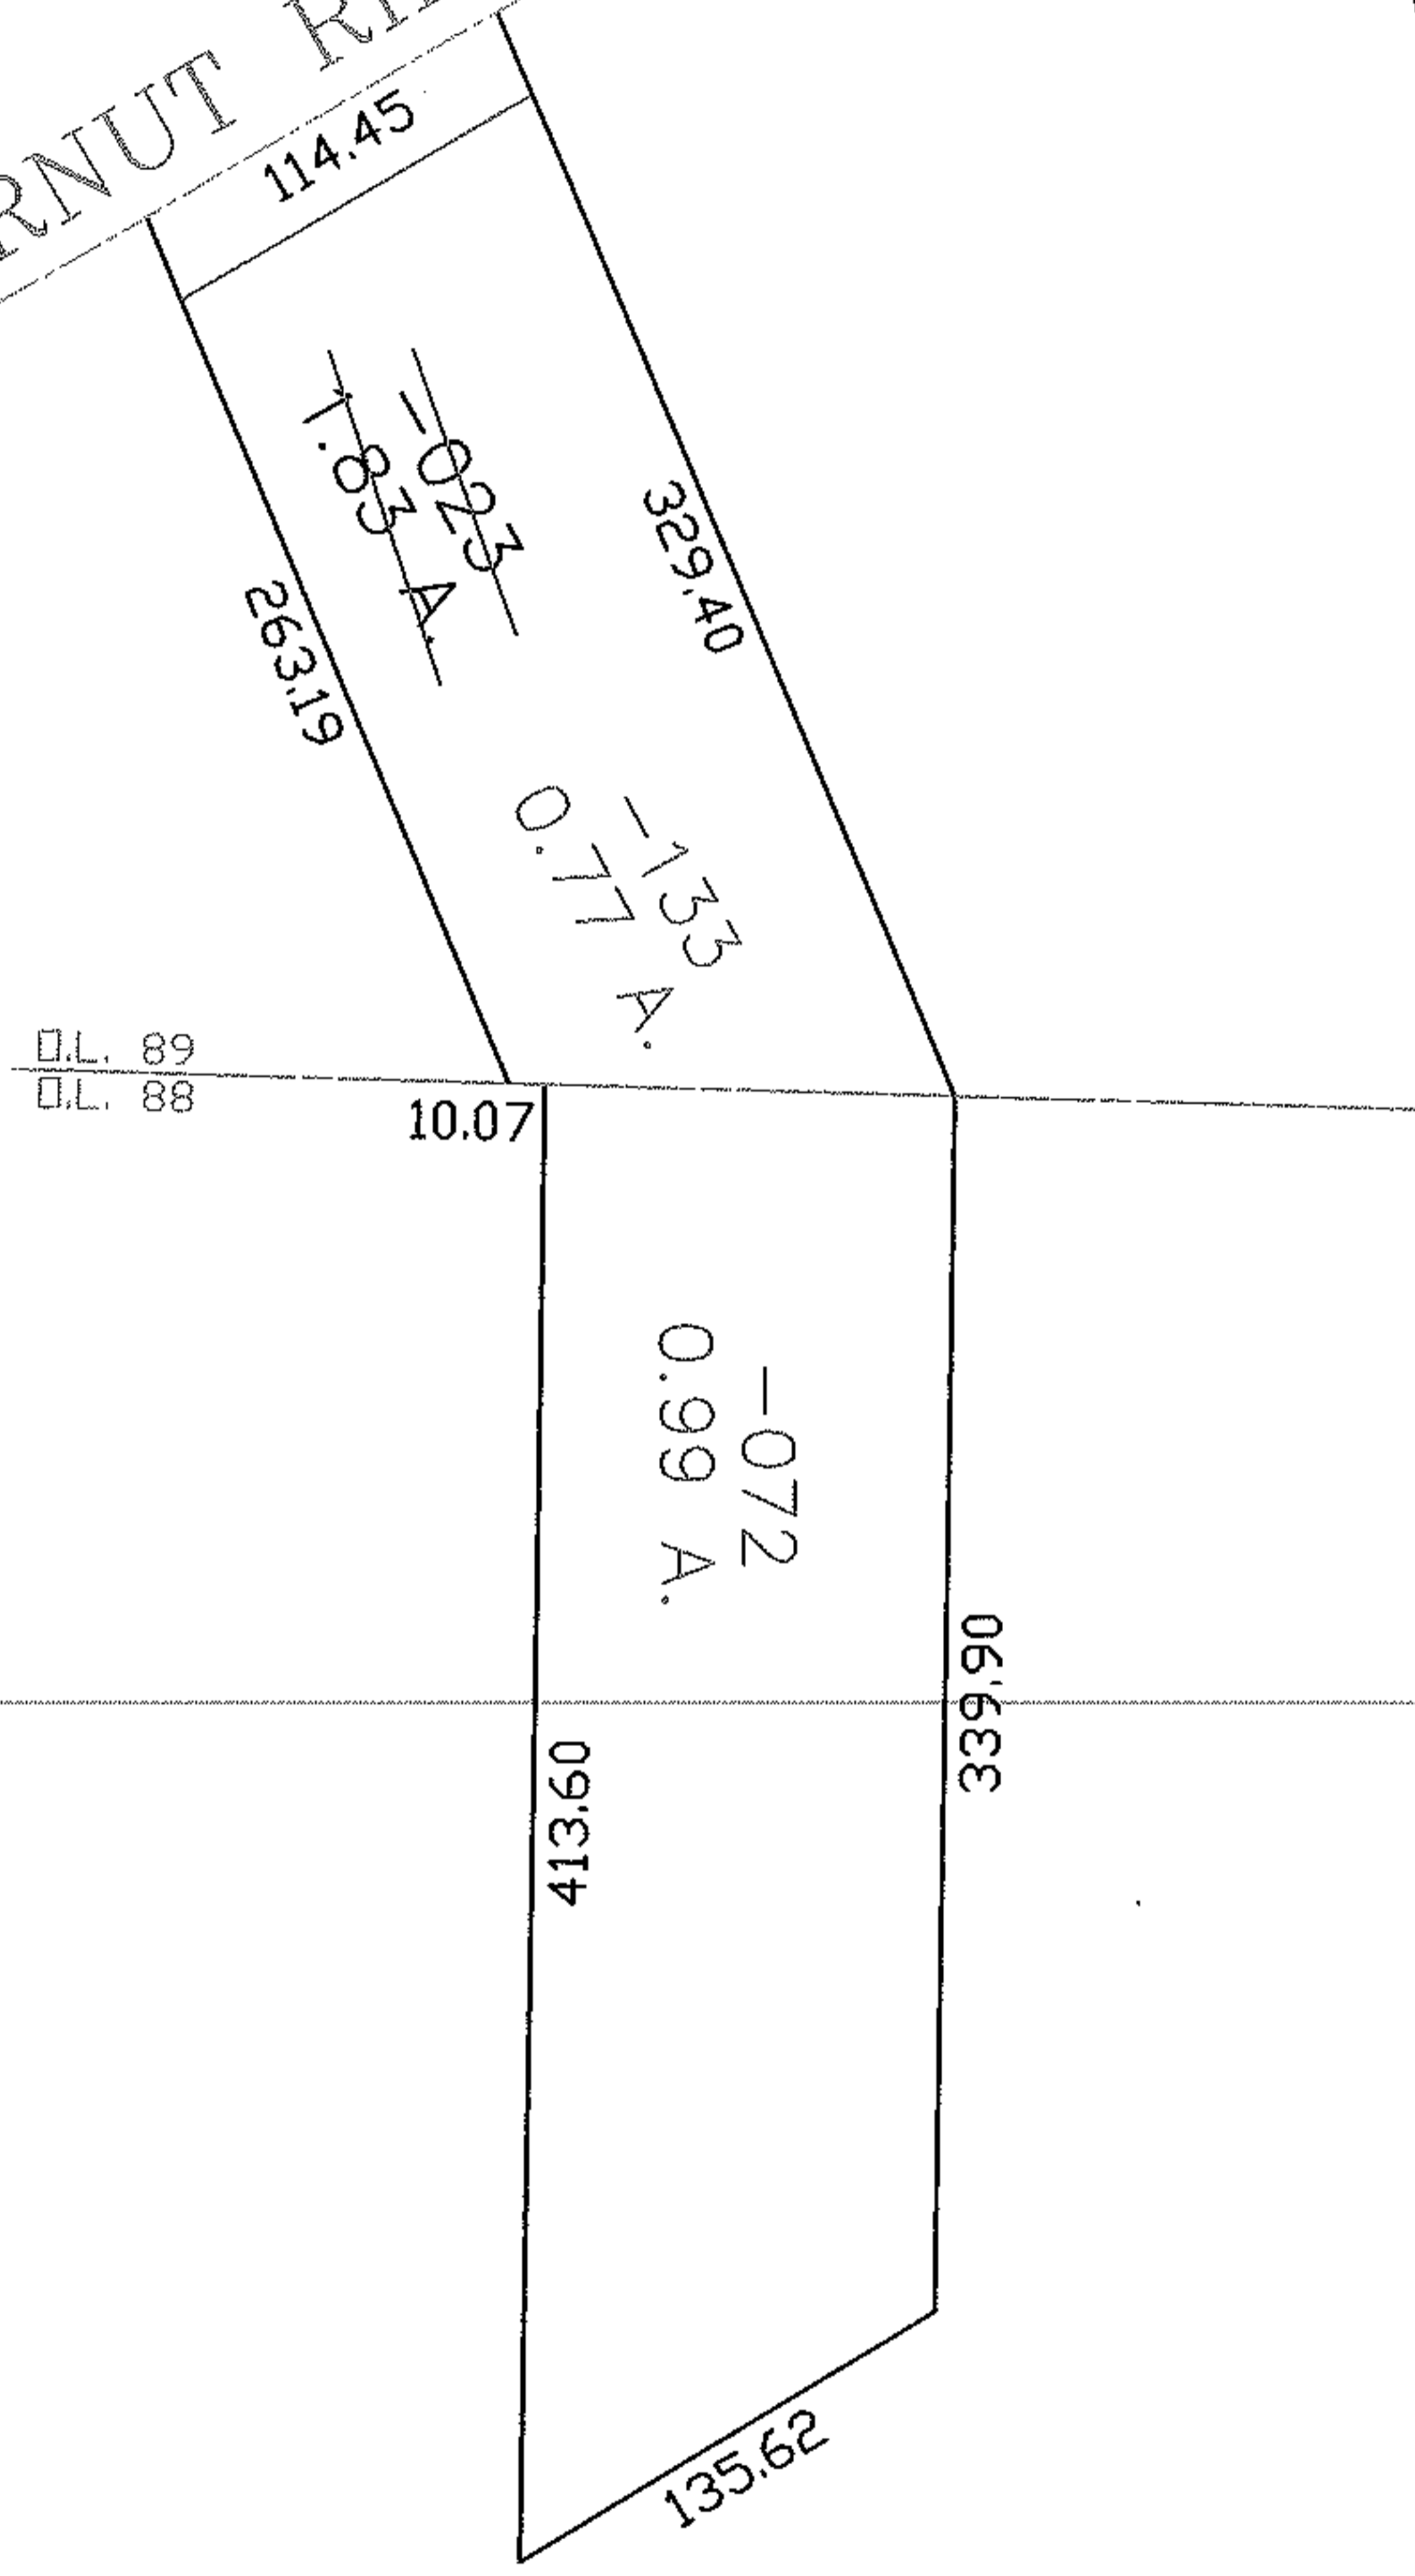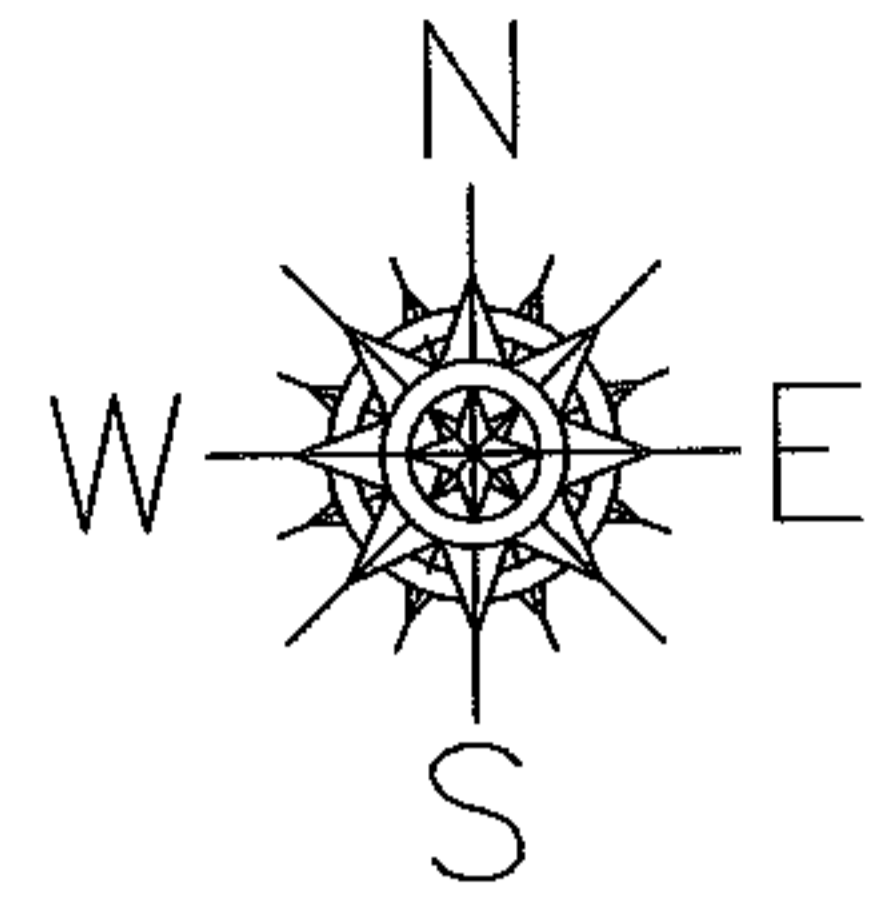

SPLITS/DEEDS PROCESSED

LORAIN COUNTY TAX MAP DEPARTMENT
226 MIDDLE AVE. ELYRIA, OHIO

SURVEYED BY: STUART W. SAYLER
 CLOSURE: 1:10,000
 MAP PAGE(S): 11-00-088-A
 APPROVED BY: DRH DATE: 5/30/2006
 SCALE: 1" = 100' PRIOR INSTRUMENT: 20000703966