

RASTER




PARENT PARCEL: 15-00-056-104-008

CHILD PARCEL: --SAME--

STARTING POINT: S/L 8 IN GRANT'S SUB. VOL 1 PAGE 30

06-01344-A

CHANGE ACREAGE 0.25 A.  
TO FRONTAGE AND DEPTH PER PLAT  
80.52 X 147.18

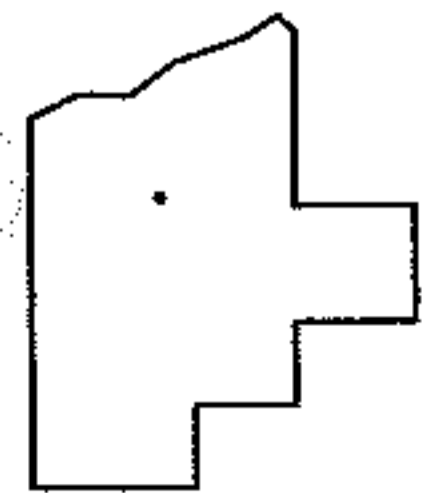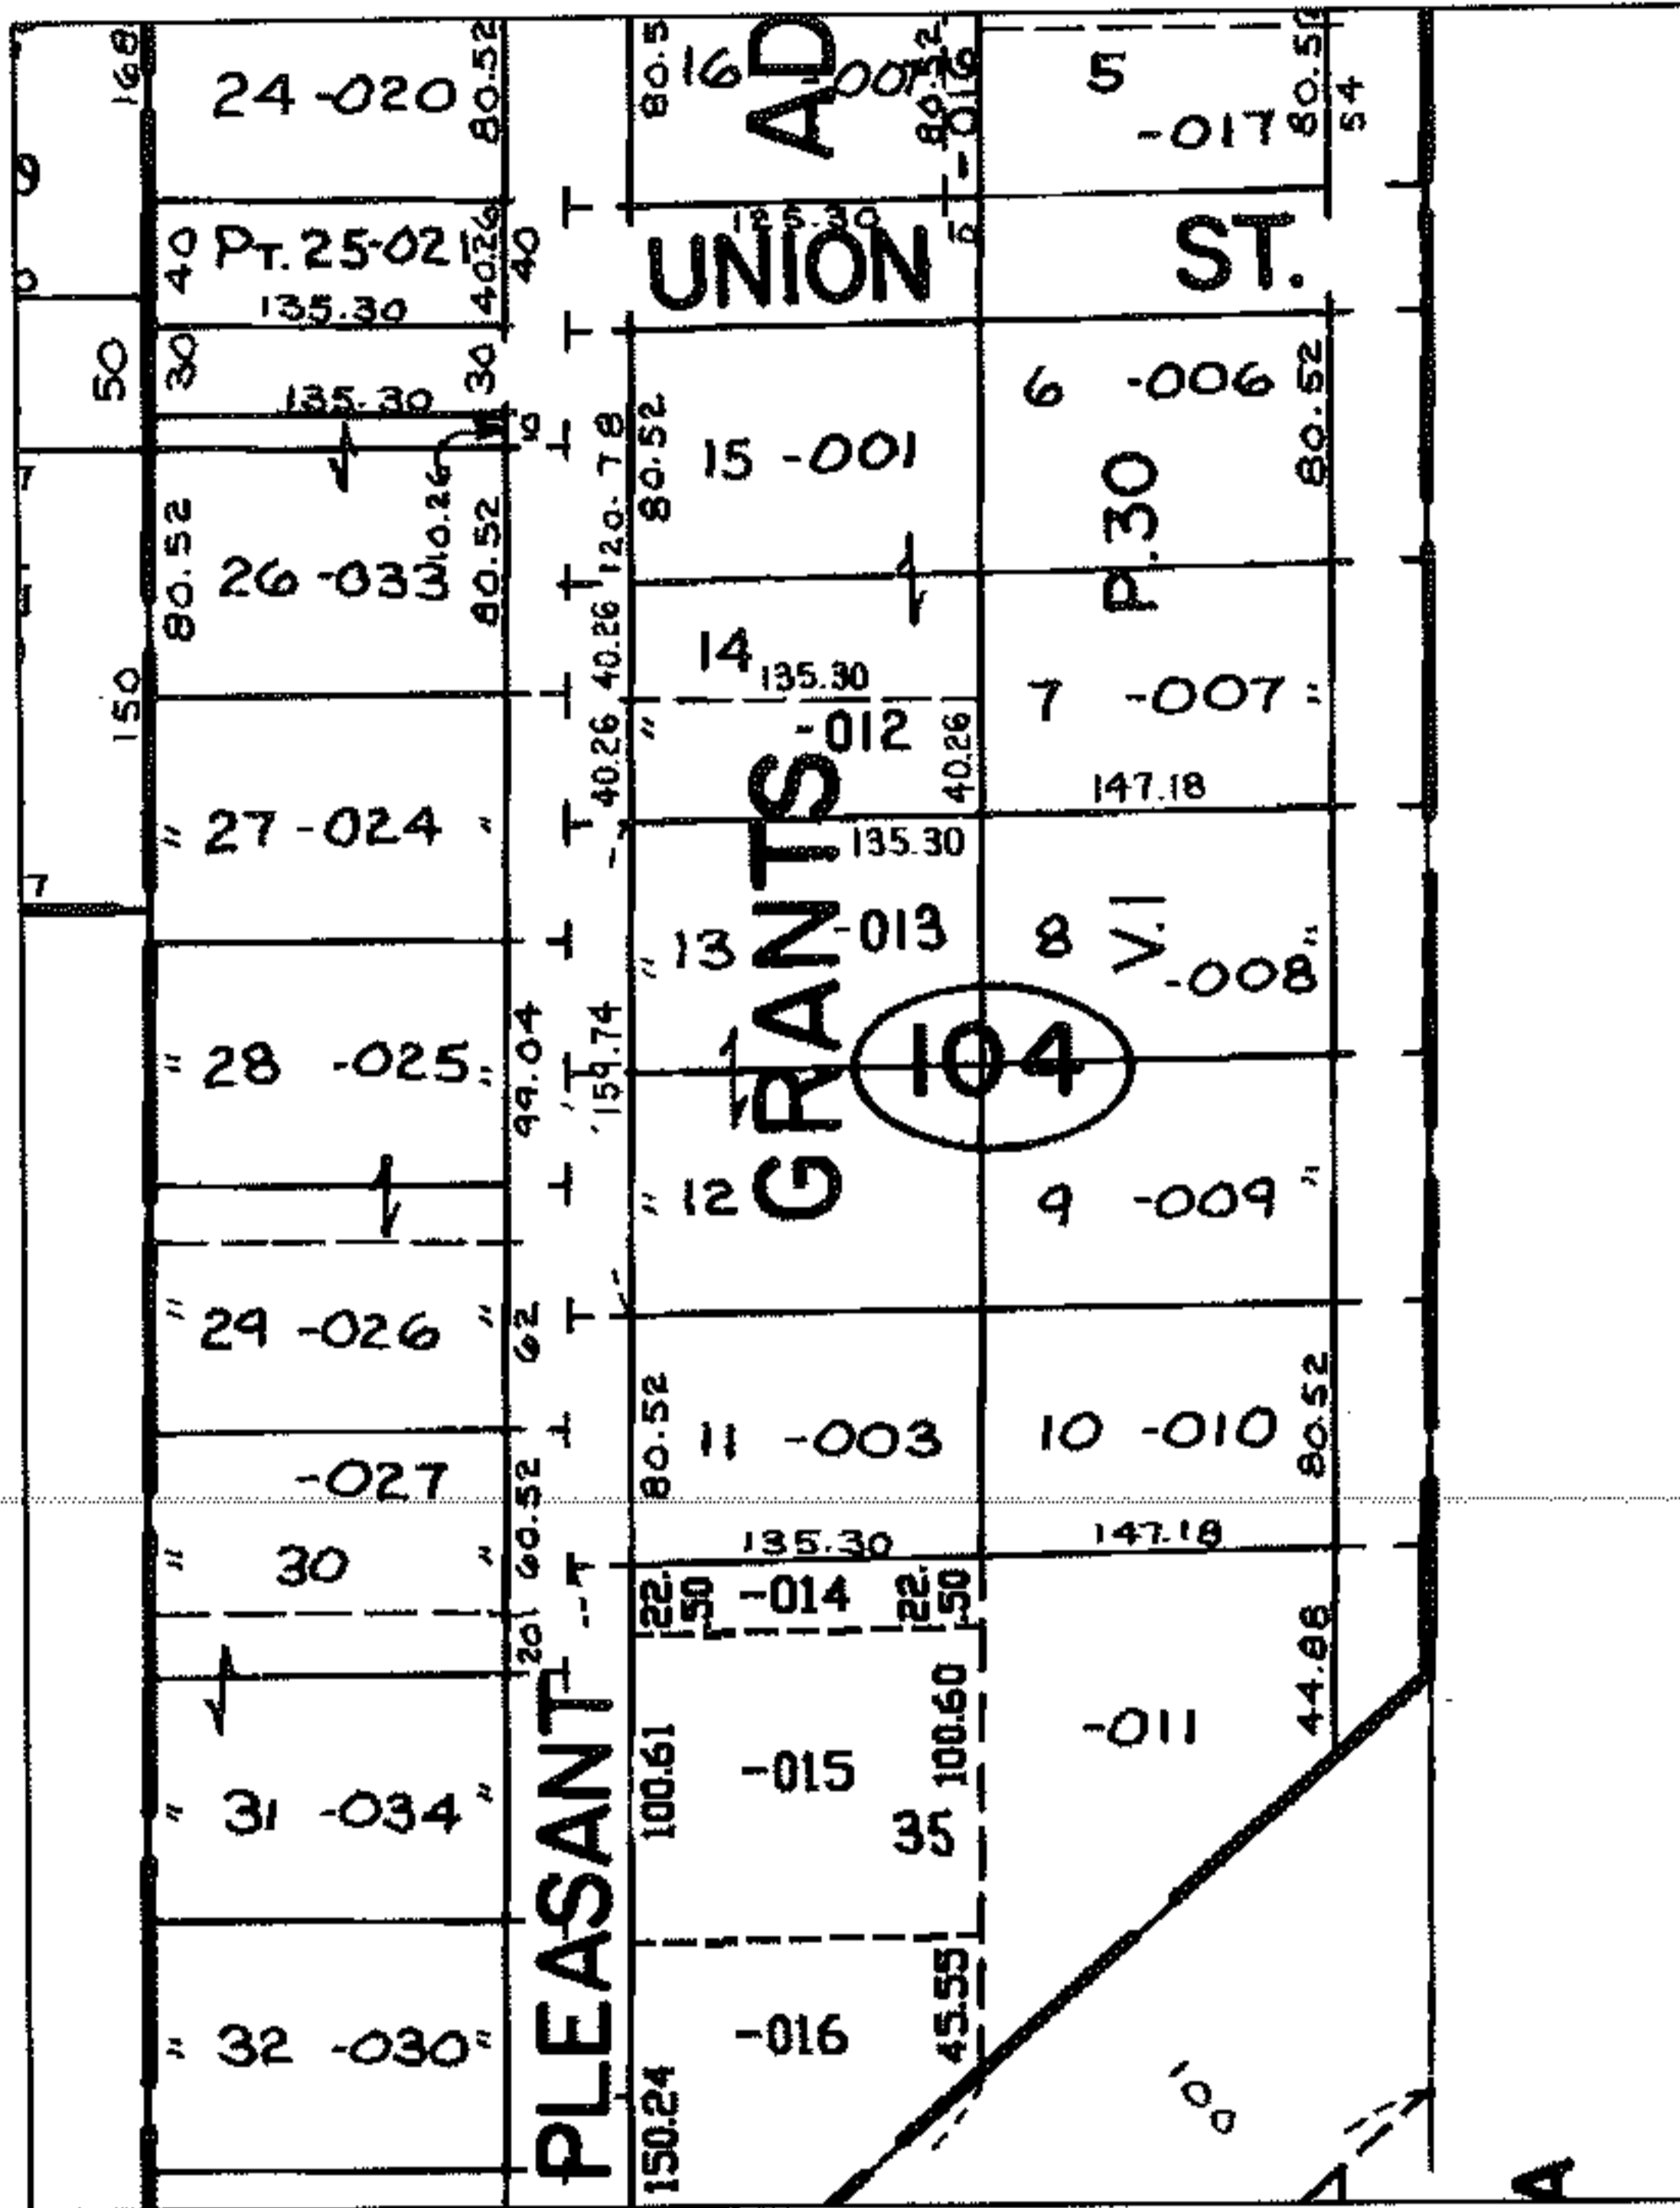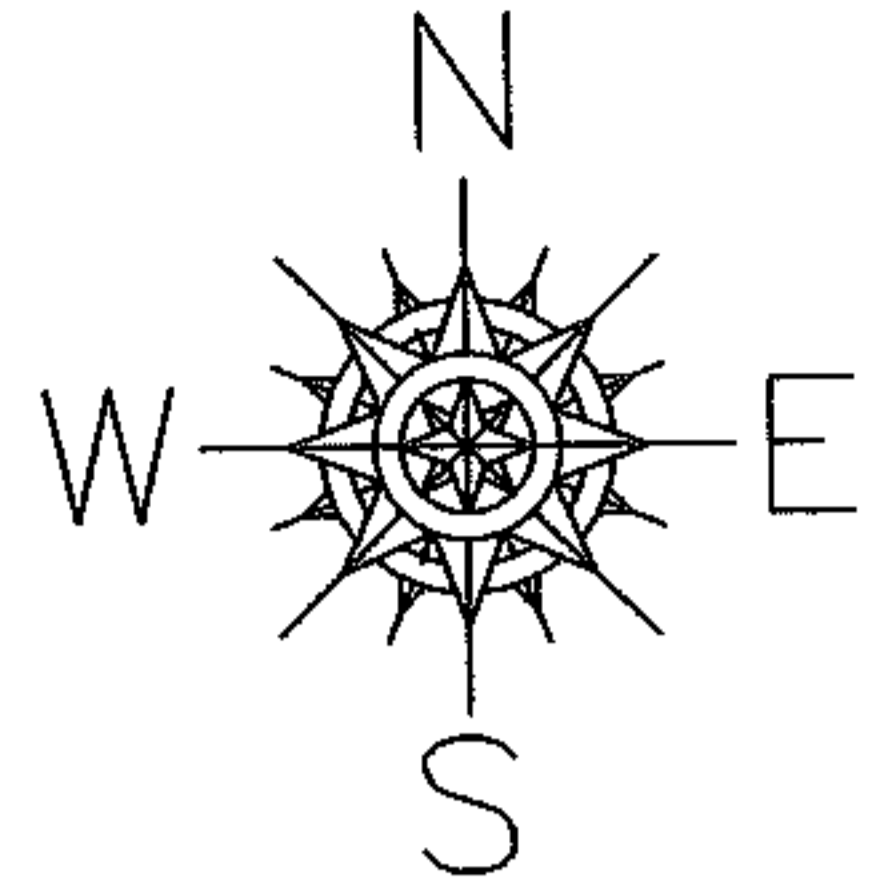

**SPLITS/DEEDS PROCESSED**  
LORAIN COUNTY TAX MAP DEPARTMENT  
226 MIDDLE AVE. ELYRIA, OHIO

SURVEYED BY: N/A  
CLOSURE: N/A  
MAP PAGE(S): 15-00-056-B  
APPROVED BY: DRH DATE: 5/25/2006  
SCALE: 1" = 200 PRIOR INSTRUMENT: 268/501