

PARENT PARCEL:	<u>. </u>

06 - 01351 - X

CHILD PARCEL:_______STARTING POINT: NW CORNER OF SL 26

VACATION ORD 80-06

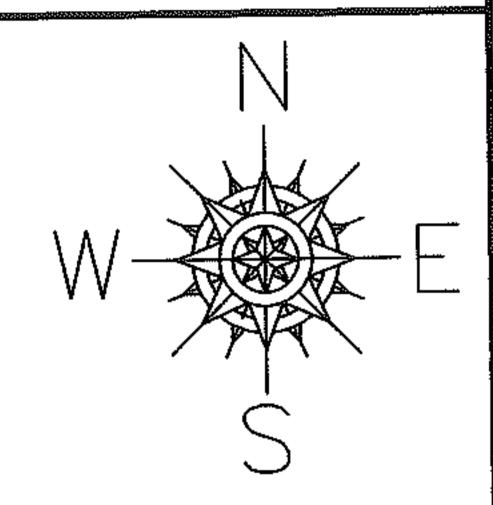

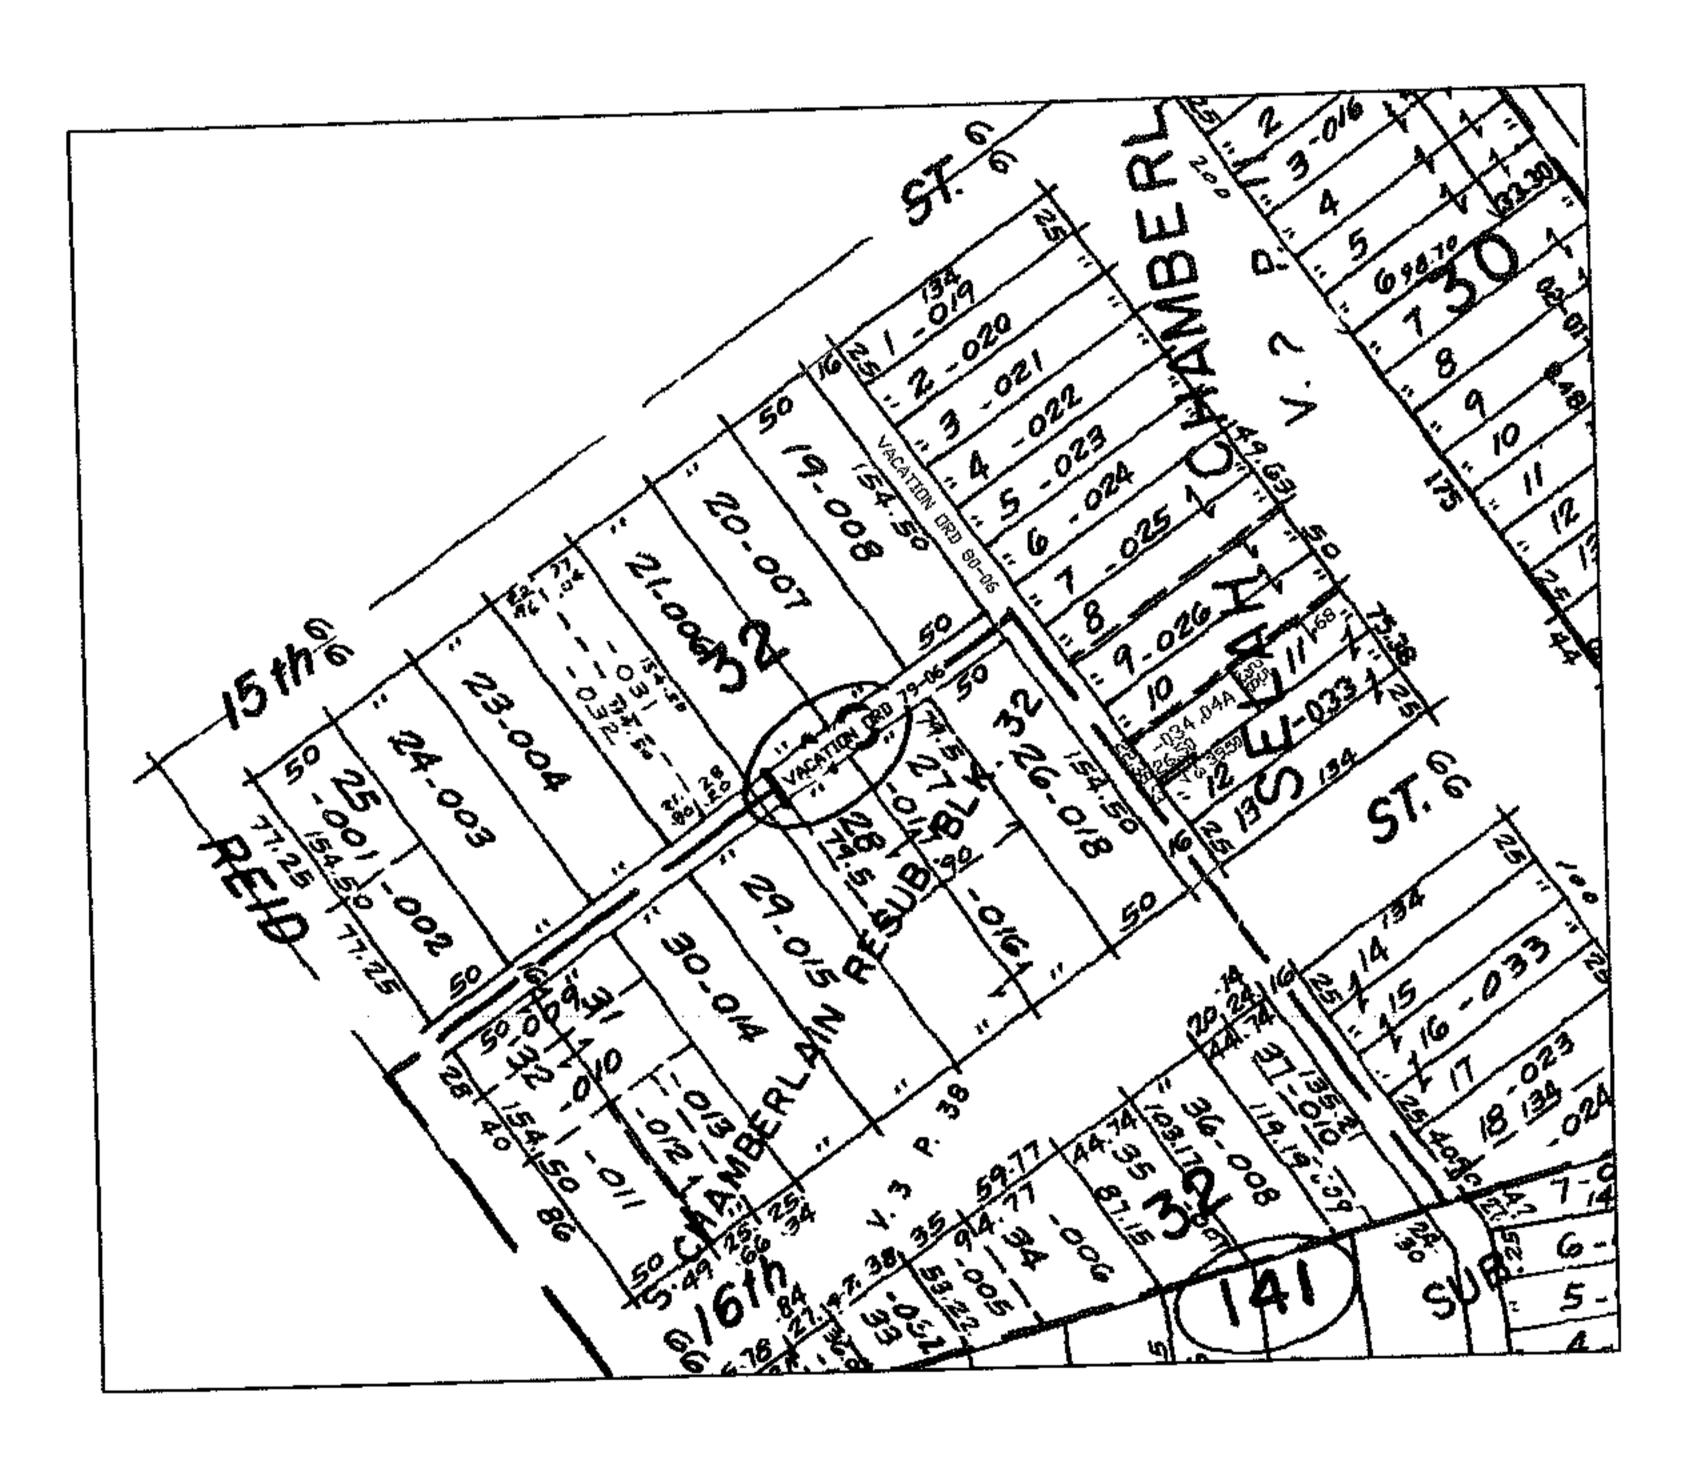

SPLITS/DEEDS PROCESSED
LORAIN COUNTY TAX MAP DEPARTMENT
226 MIDDLE AVE. ELYRIA, OHIO

SURVEYED BY:______

MAP PAGE(S): 02-01-003-F
APPROVED BY: DRH DATE: 6/15/2006

SCALE: 1"= 200 PRIOR INSTRUMENT: