

RASTER




PARENT PARCEL: _____

CHILD PARCEL: _____

STARTING POINT: NW CORNER OF SL 26

06-01352-X

VACATION ORD
79-06

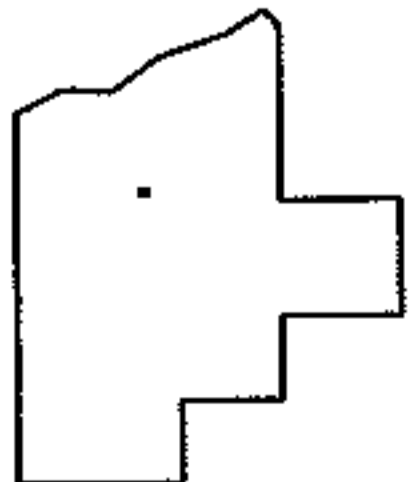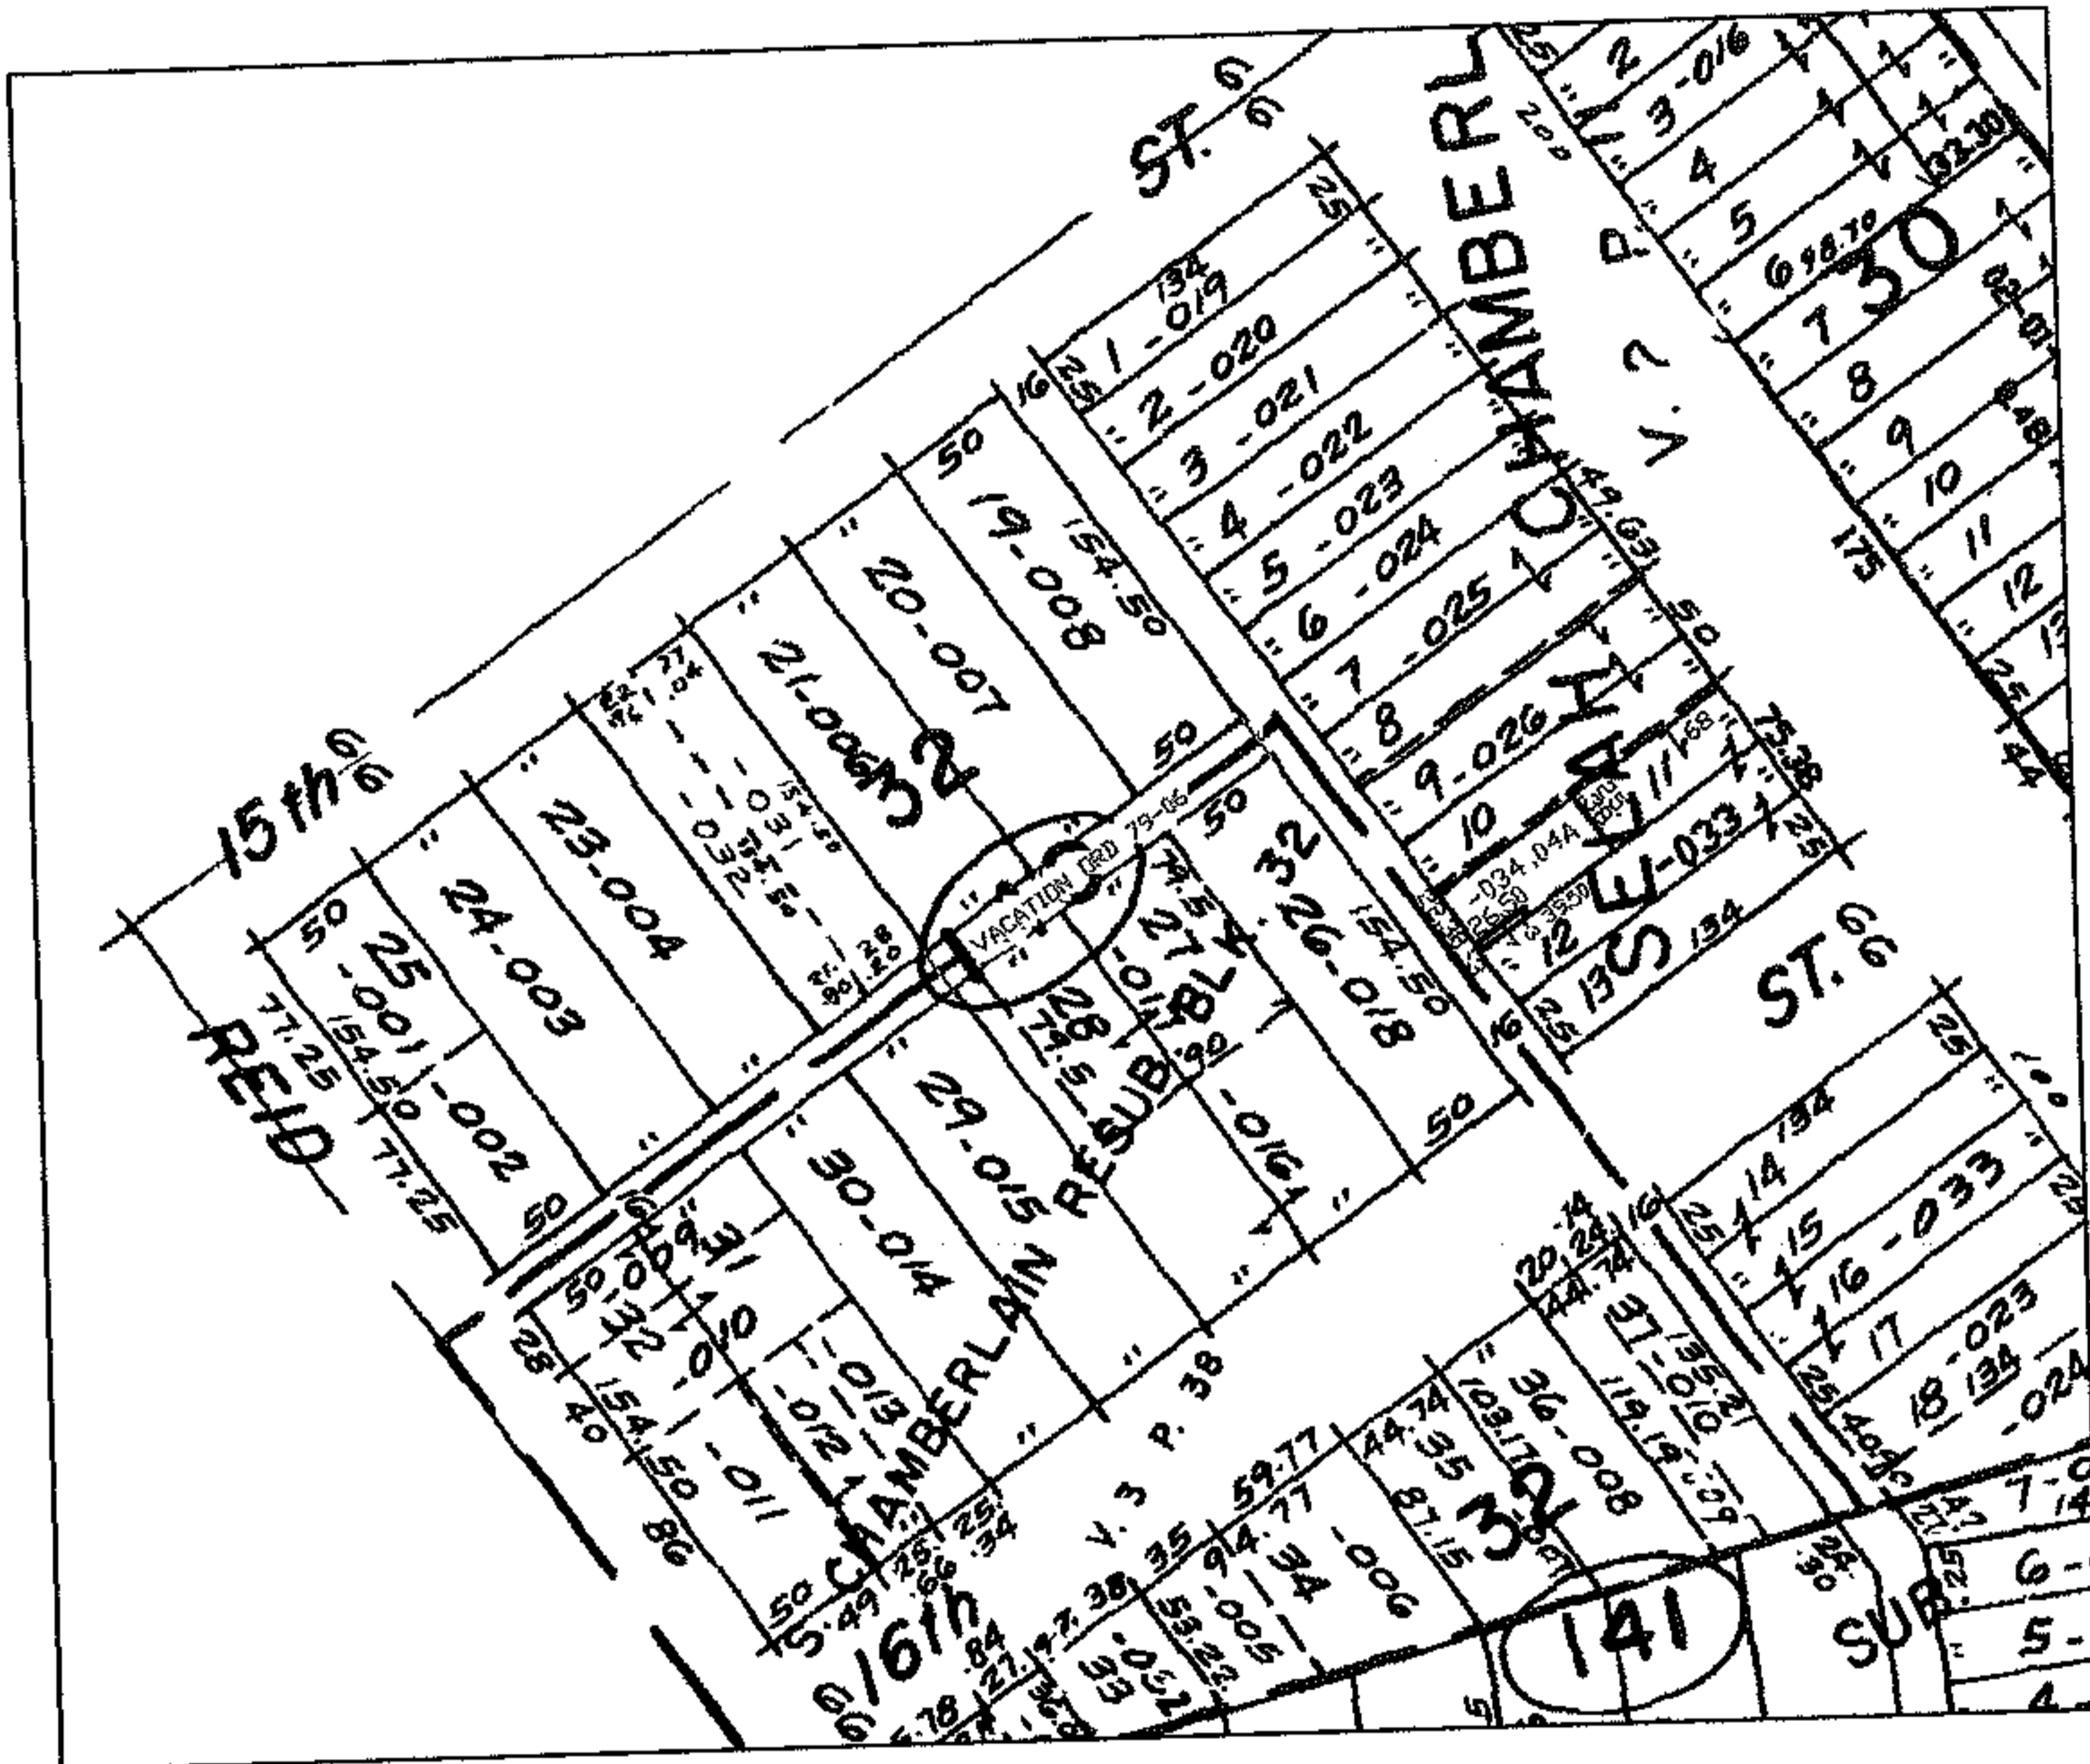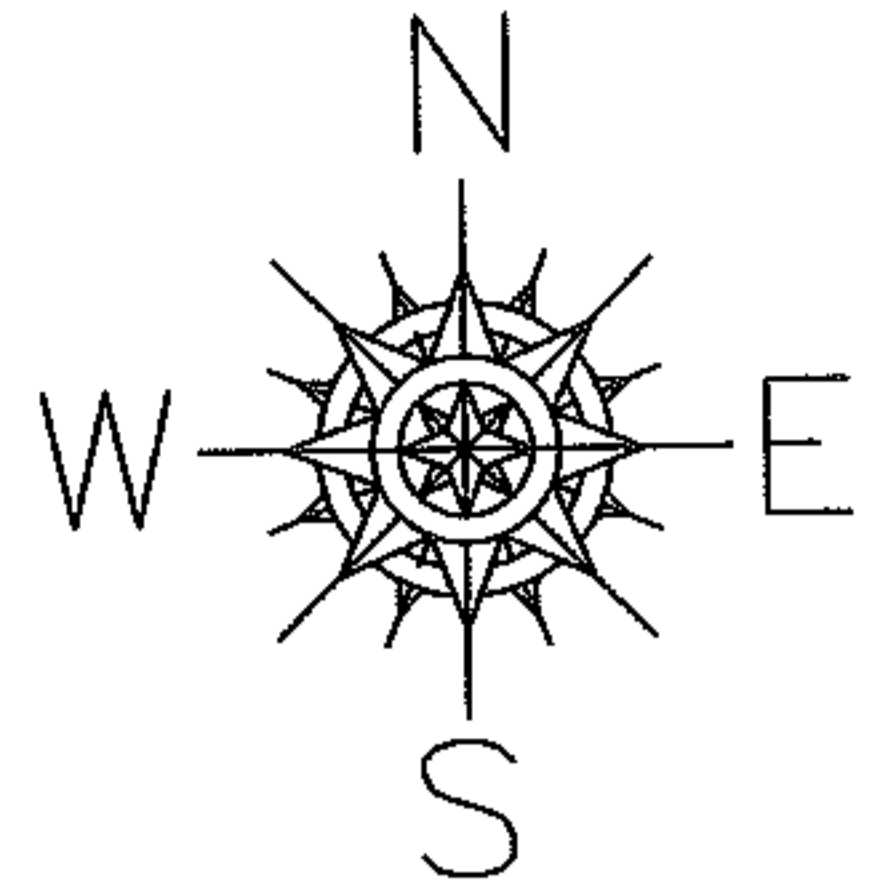

SPLITS/DEEDS PROCESSED
LORAIN COUNTY TAX MAP DEPARTMENT
226 MIDDLE AVE. ELYRIA, OHIO

SURVEYED BY: _____

CLOSURE: _____

MAP PAGE(S): 02-01-003-F

APPROVED BY: DRH DATE: 6/15/2006

SCALE: 1" = 200 PRIOR INSTRUMENT: _____