

PARENT PARCEL: SEE BELOW

CHILD PARCEL: SEE BELOW


STARTING POINT: XXXXXX

NO. 01353-C

PARCEL NUMBER CORRECTION

PV. 84/5-8

- 1) ~~07-00-037-000-025~~
07-00-038-000-307
- 2) ~~07-00-037-000-026~~
07-00-038-000-308
- 3) ~~07-00-037-000-027~~
07-00-038-000-309
- 4) ~~07-00-037-000-028~~
07-00-038-000-310
- 5) ~~07-00-037-000-029~~
07-00-038-000-311
- 6) ~~07-00-037-000-030~~
07-00-038-000-312
- 7) ~~07-00-037-000-052~~
07-00-038-000-313
- 8) ~~07-00-037-000-053~~
07-00-038-000-314
- 9) ~~07-00-037-000-054~~
07-00-038-000-315
- 10) ~~07-00-037-000-055~~
07-00-038-000-316
- 11) ~~07-00-037-000-056~~
07-00-038-000-317
- 12) ~~07-00-037-000-057~~
07-00-038-000-318
- 13) ~~07-00-037-000-068~~
07-00-038-000-319

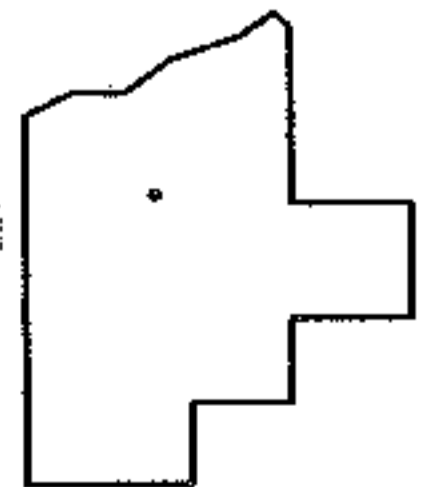

SPLITS/DEEDS PROCESSED

LORAIN COUNTY TAX MAP DEPARTMENT
226 MIDDLE AVE. ELYRIA, OHIO

SURVEYED BY: XXXXXXXXXX

CLOSURE: XXXXXX

MAP PAGE(S): 7-00-037-A & D, -038

APPROVED BY: TJS DATE: 6/19/06

SCALE: 1" = 100' PRIOR INSTRUMENT: DV XXXX/XXX