


PARENT PARCEL: 05-00-011-105-019

CHILD PARCEL: --SAME--

STARTING POINT: INT CL MILAN-ELYRIA RD AND CL OF ANNIS RD

06-01354-C


AC. CORR.  
PER SURVEY  
DANIEL COOK

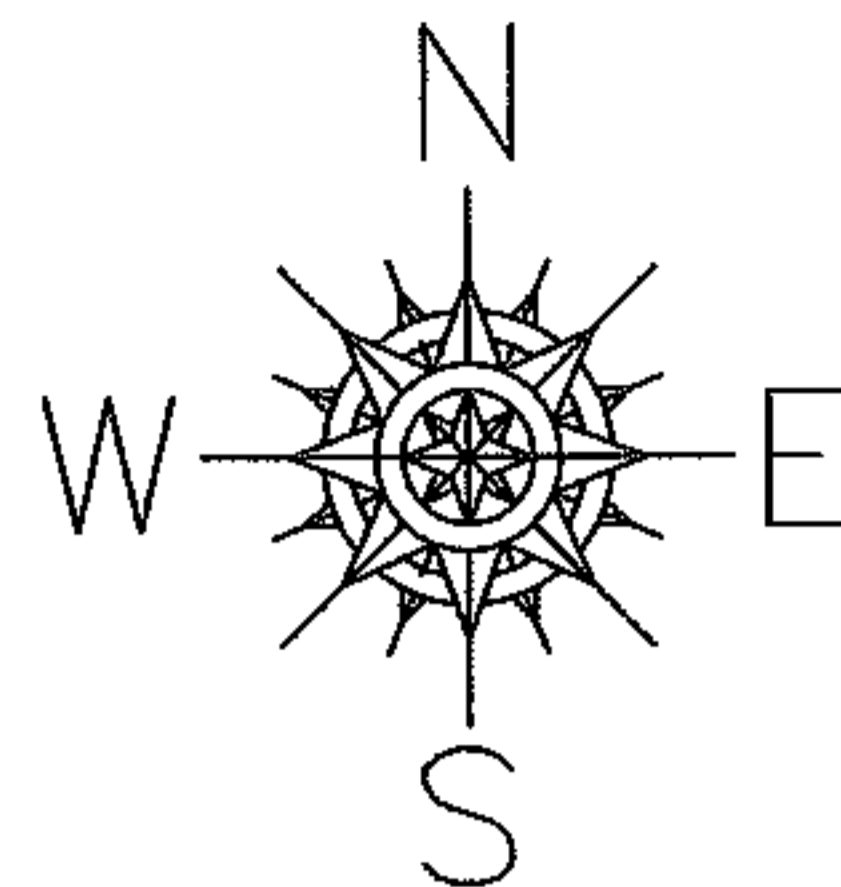

MILAN-ELYRIA RD

336.60

ANNIS RD

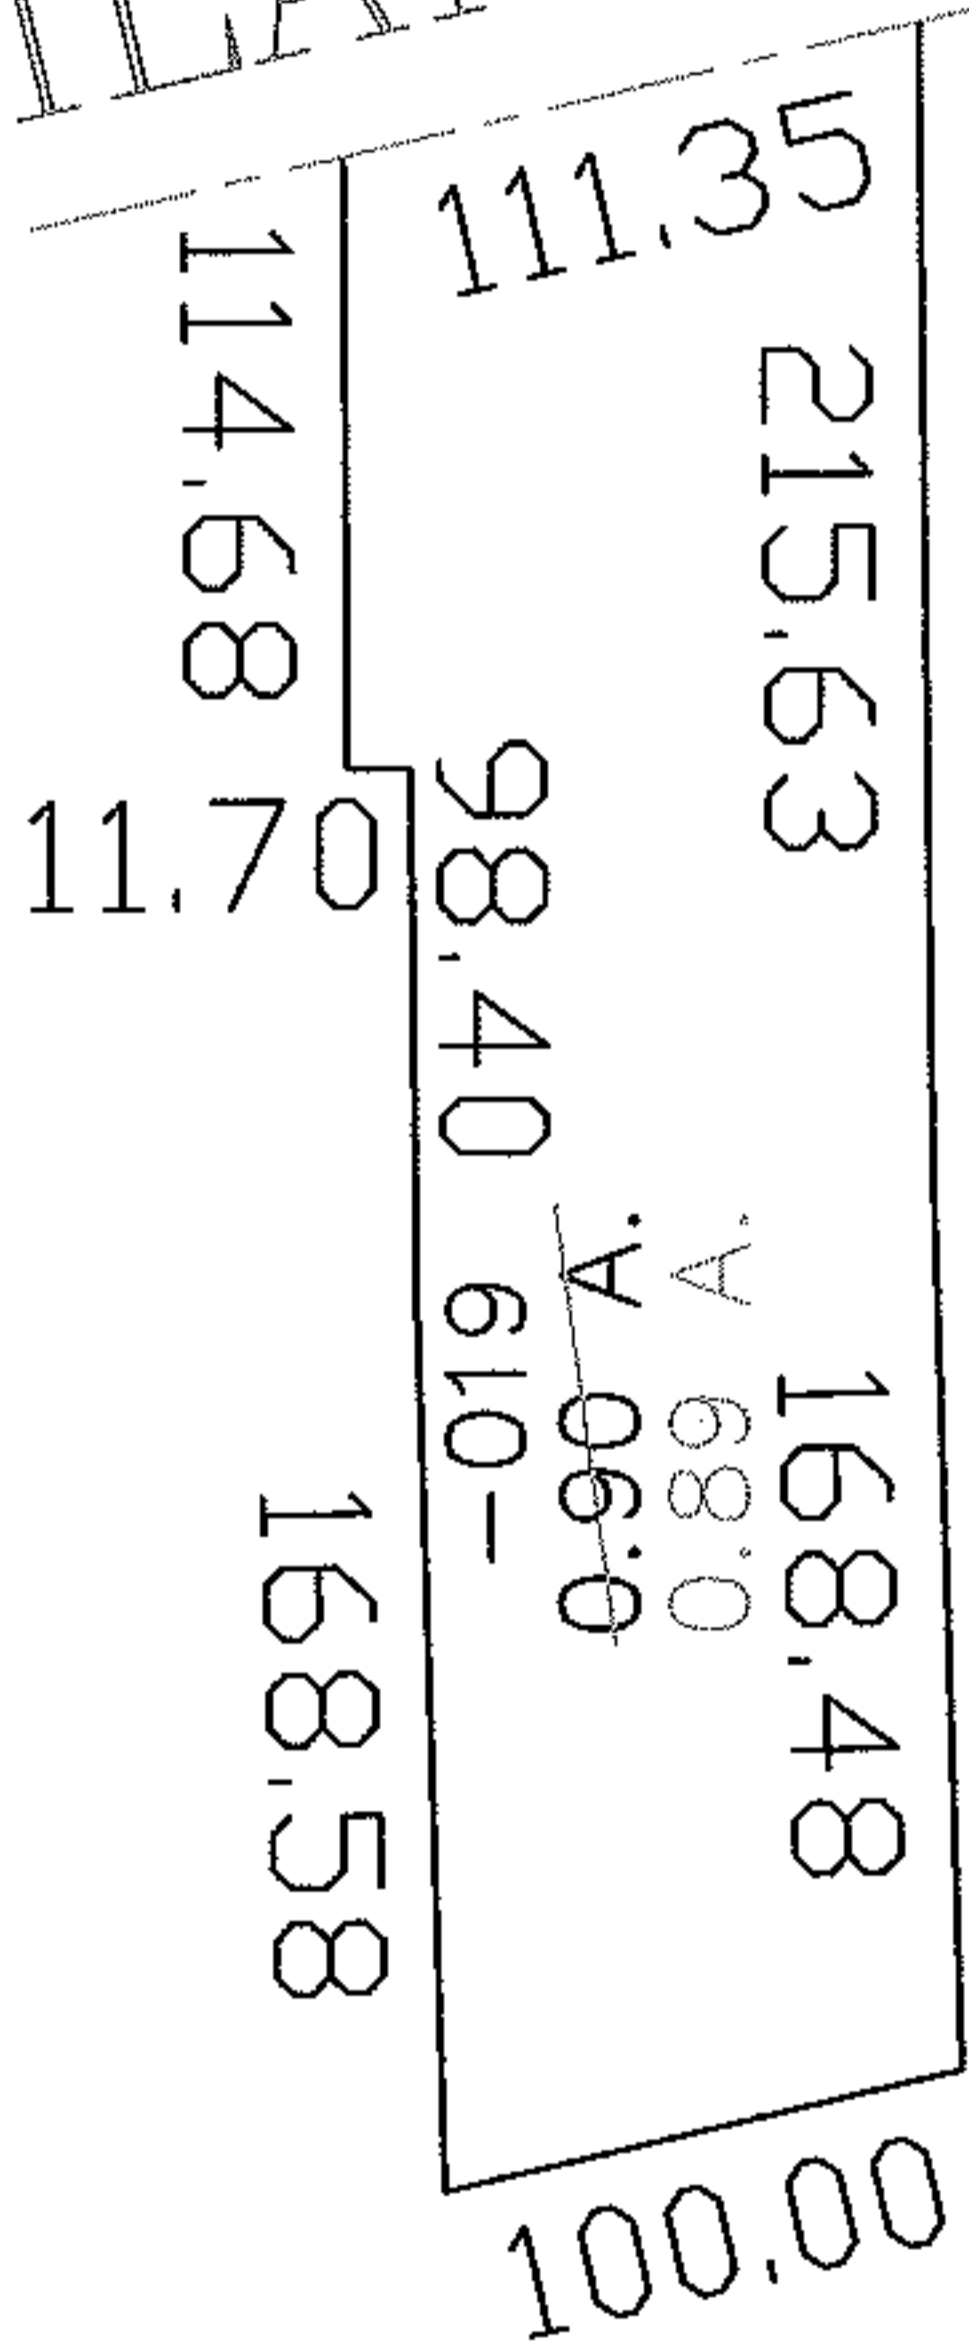

SPLITS/DEEDS PROCESSED

LORAIN COUNTY TAX MAP DEPARTMENT  
226 MIDDLE AVE. ELYRIA, OHIO

SURVEYED BY: DANIEL J. COOK

CLOSURE: 1:10,000

MAP PAGE(S): 05-00-011-B

APPROVED BY: DRH DATE: 6/20/2006

SCALE: 1"=100 PRIOR INSTRUMENT: 20060134546