



PARENT PARCEL: 07-00-011-106-003 & -004

CHILD PARCEL: --NONE--

STARTING POINT:


06-01355-C

DROP FROM DUP.

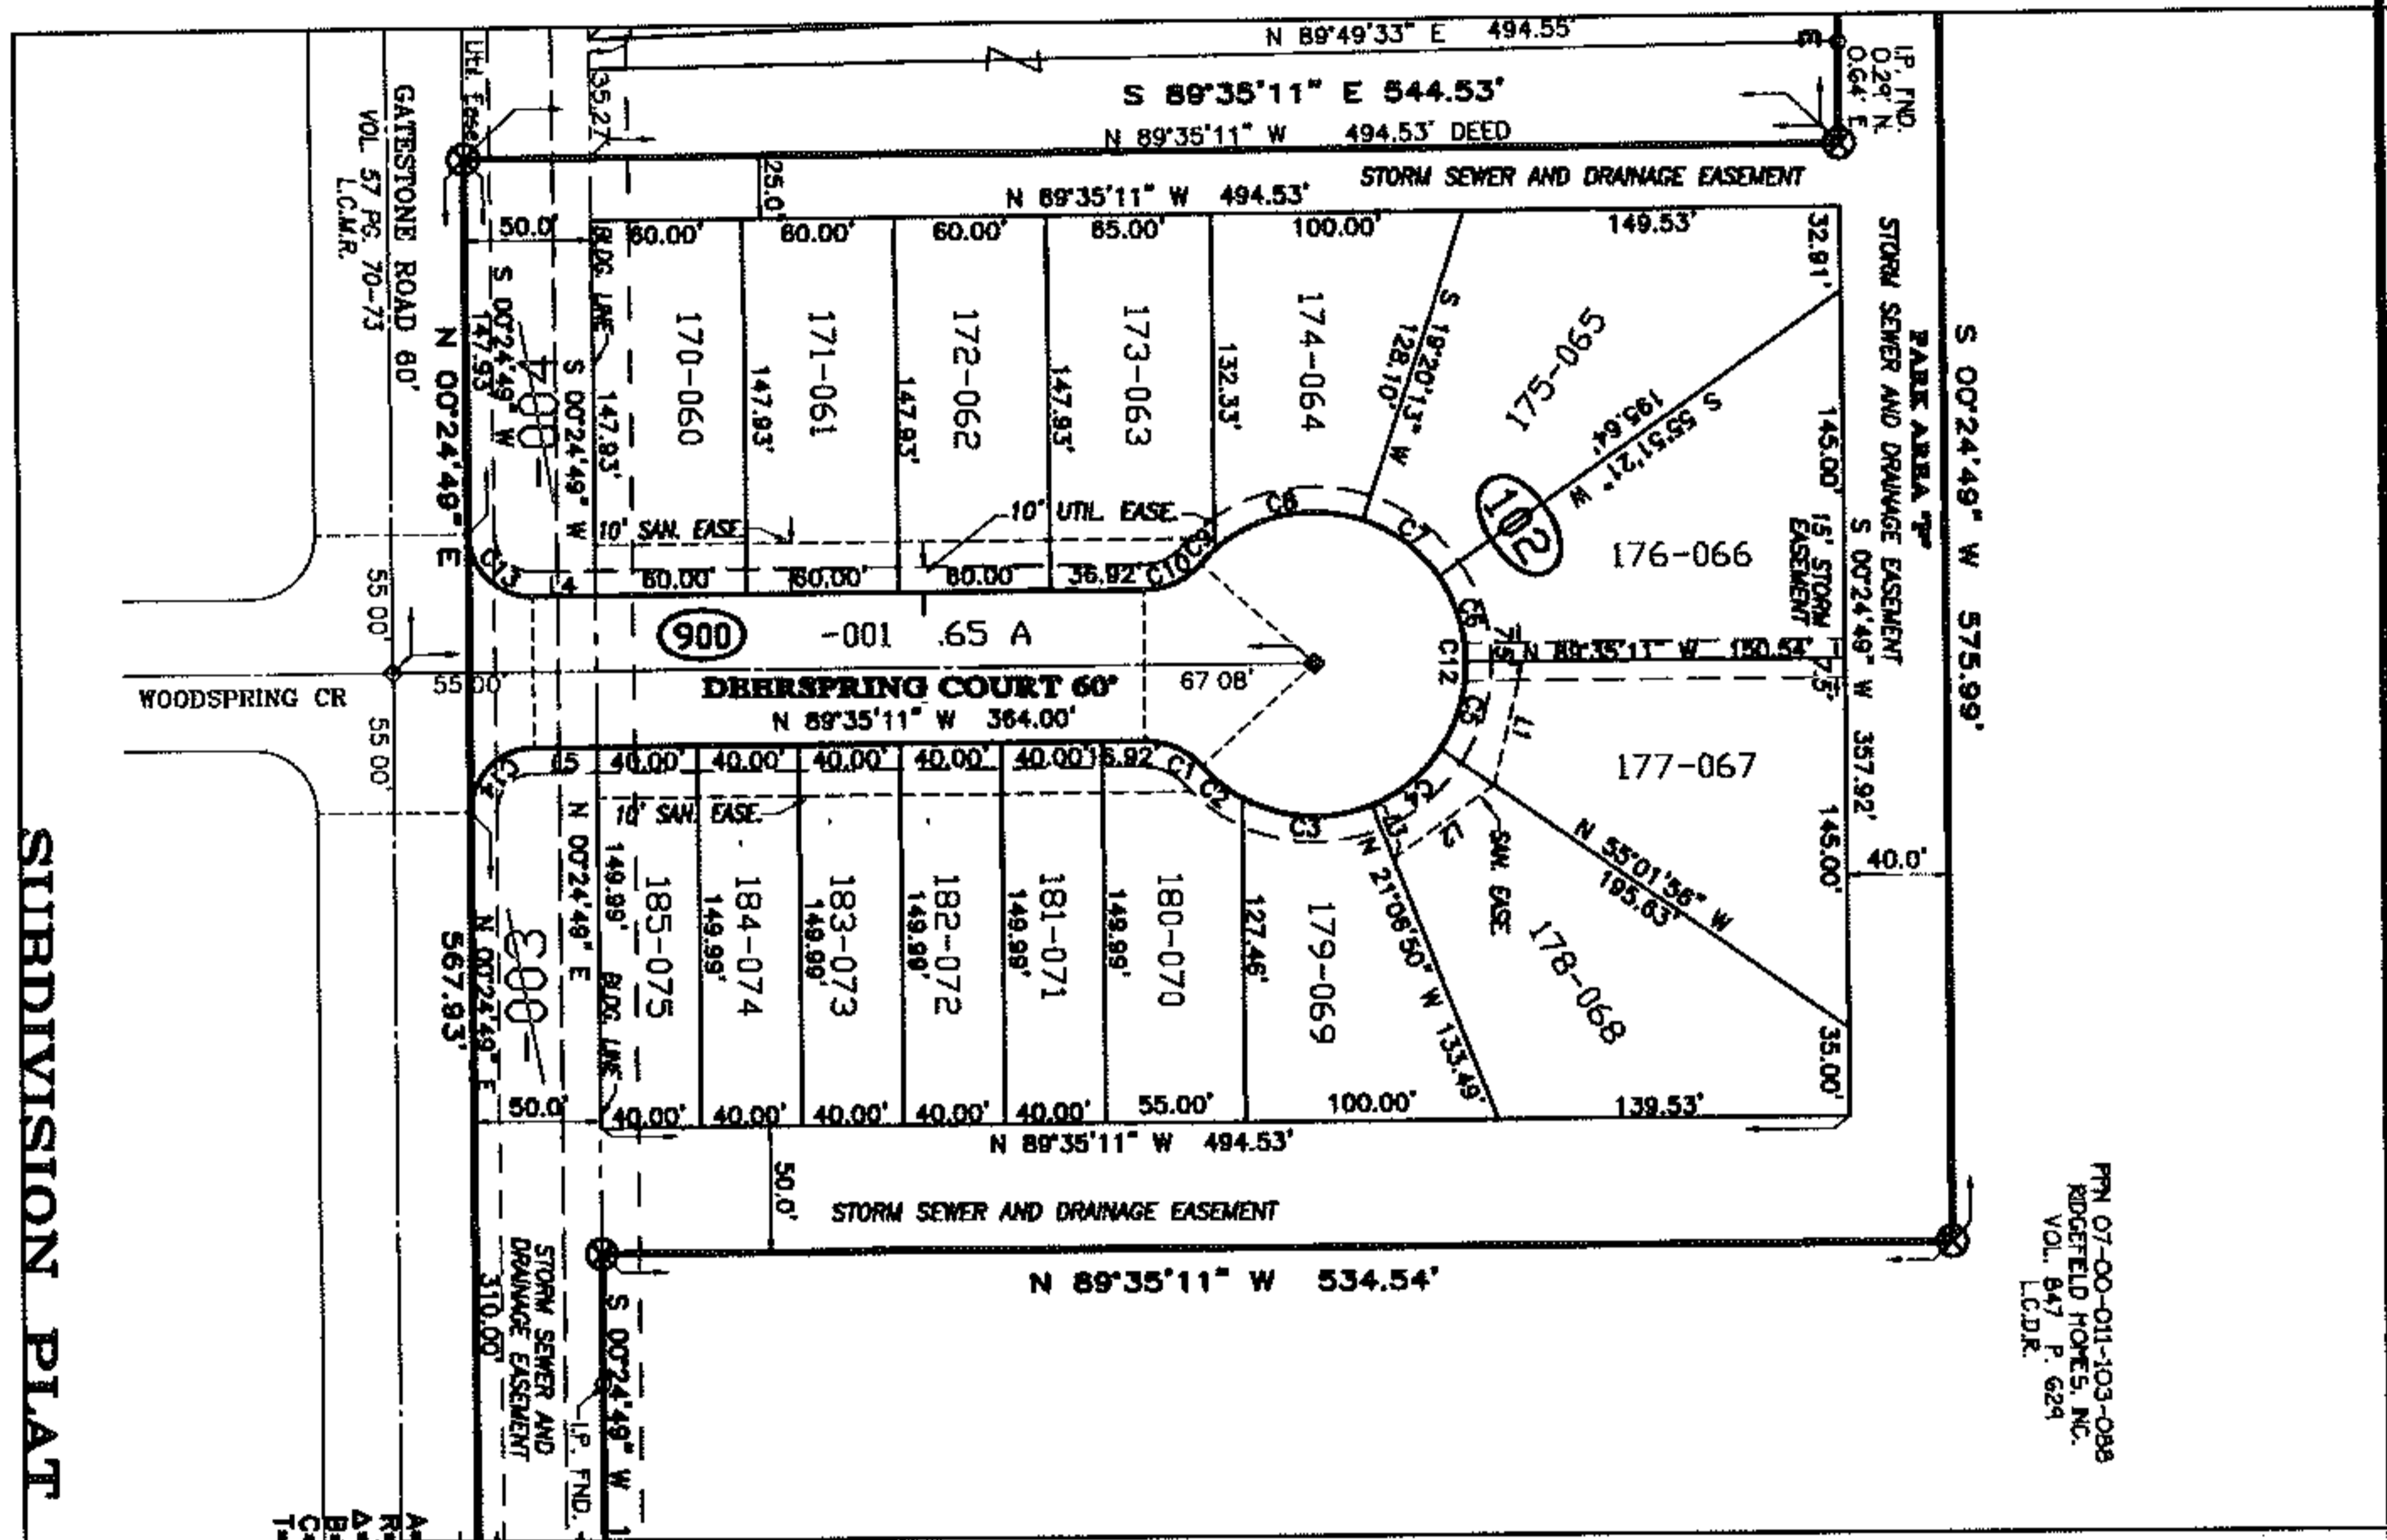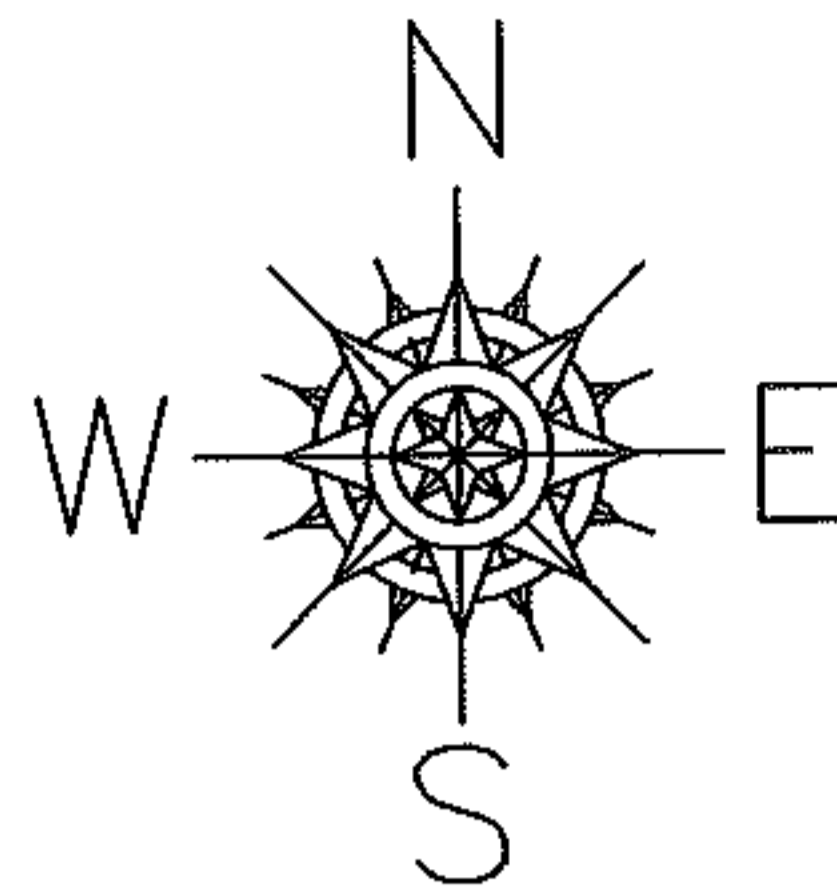

SUBDIVISION PLAT

PPN 07-00-011-103-008  
RIDGEBELD HOMES, INC.  
VOL. 847 P. 629  
L.C.D.R.

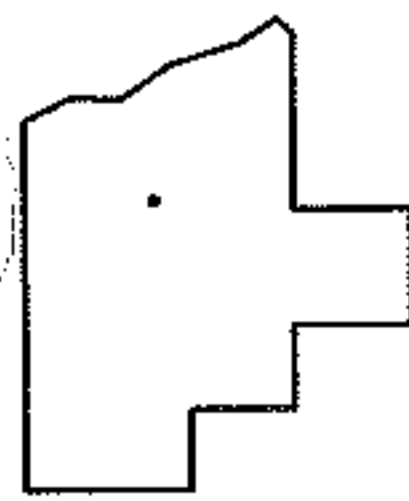

**SPLITS/DEEDS PROCESSED**  
LORAIN COUNTY TAX MAP DEPARTMENT  
226 MIDDLE AVE. ELYRIA, OHIO

SURVEYED BY: N/A  
CLOSURE: N/A  
MAP PAGE(S): 07-00-011-A  
APPROVED BY: DRH DATE: 6/20/2006  
SCALE: 1" = 400' PRIOR INSTRUMENT: