
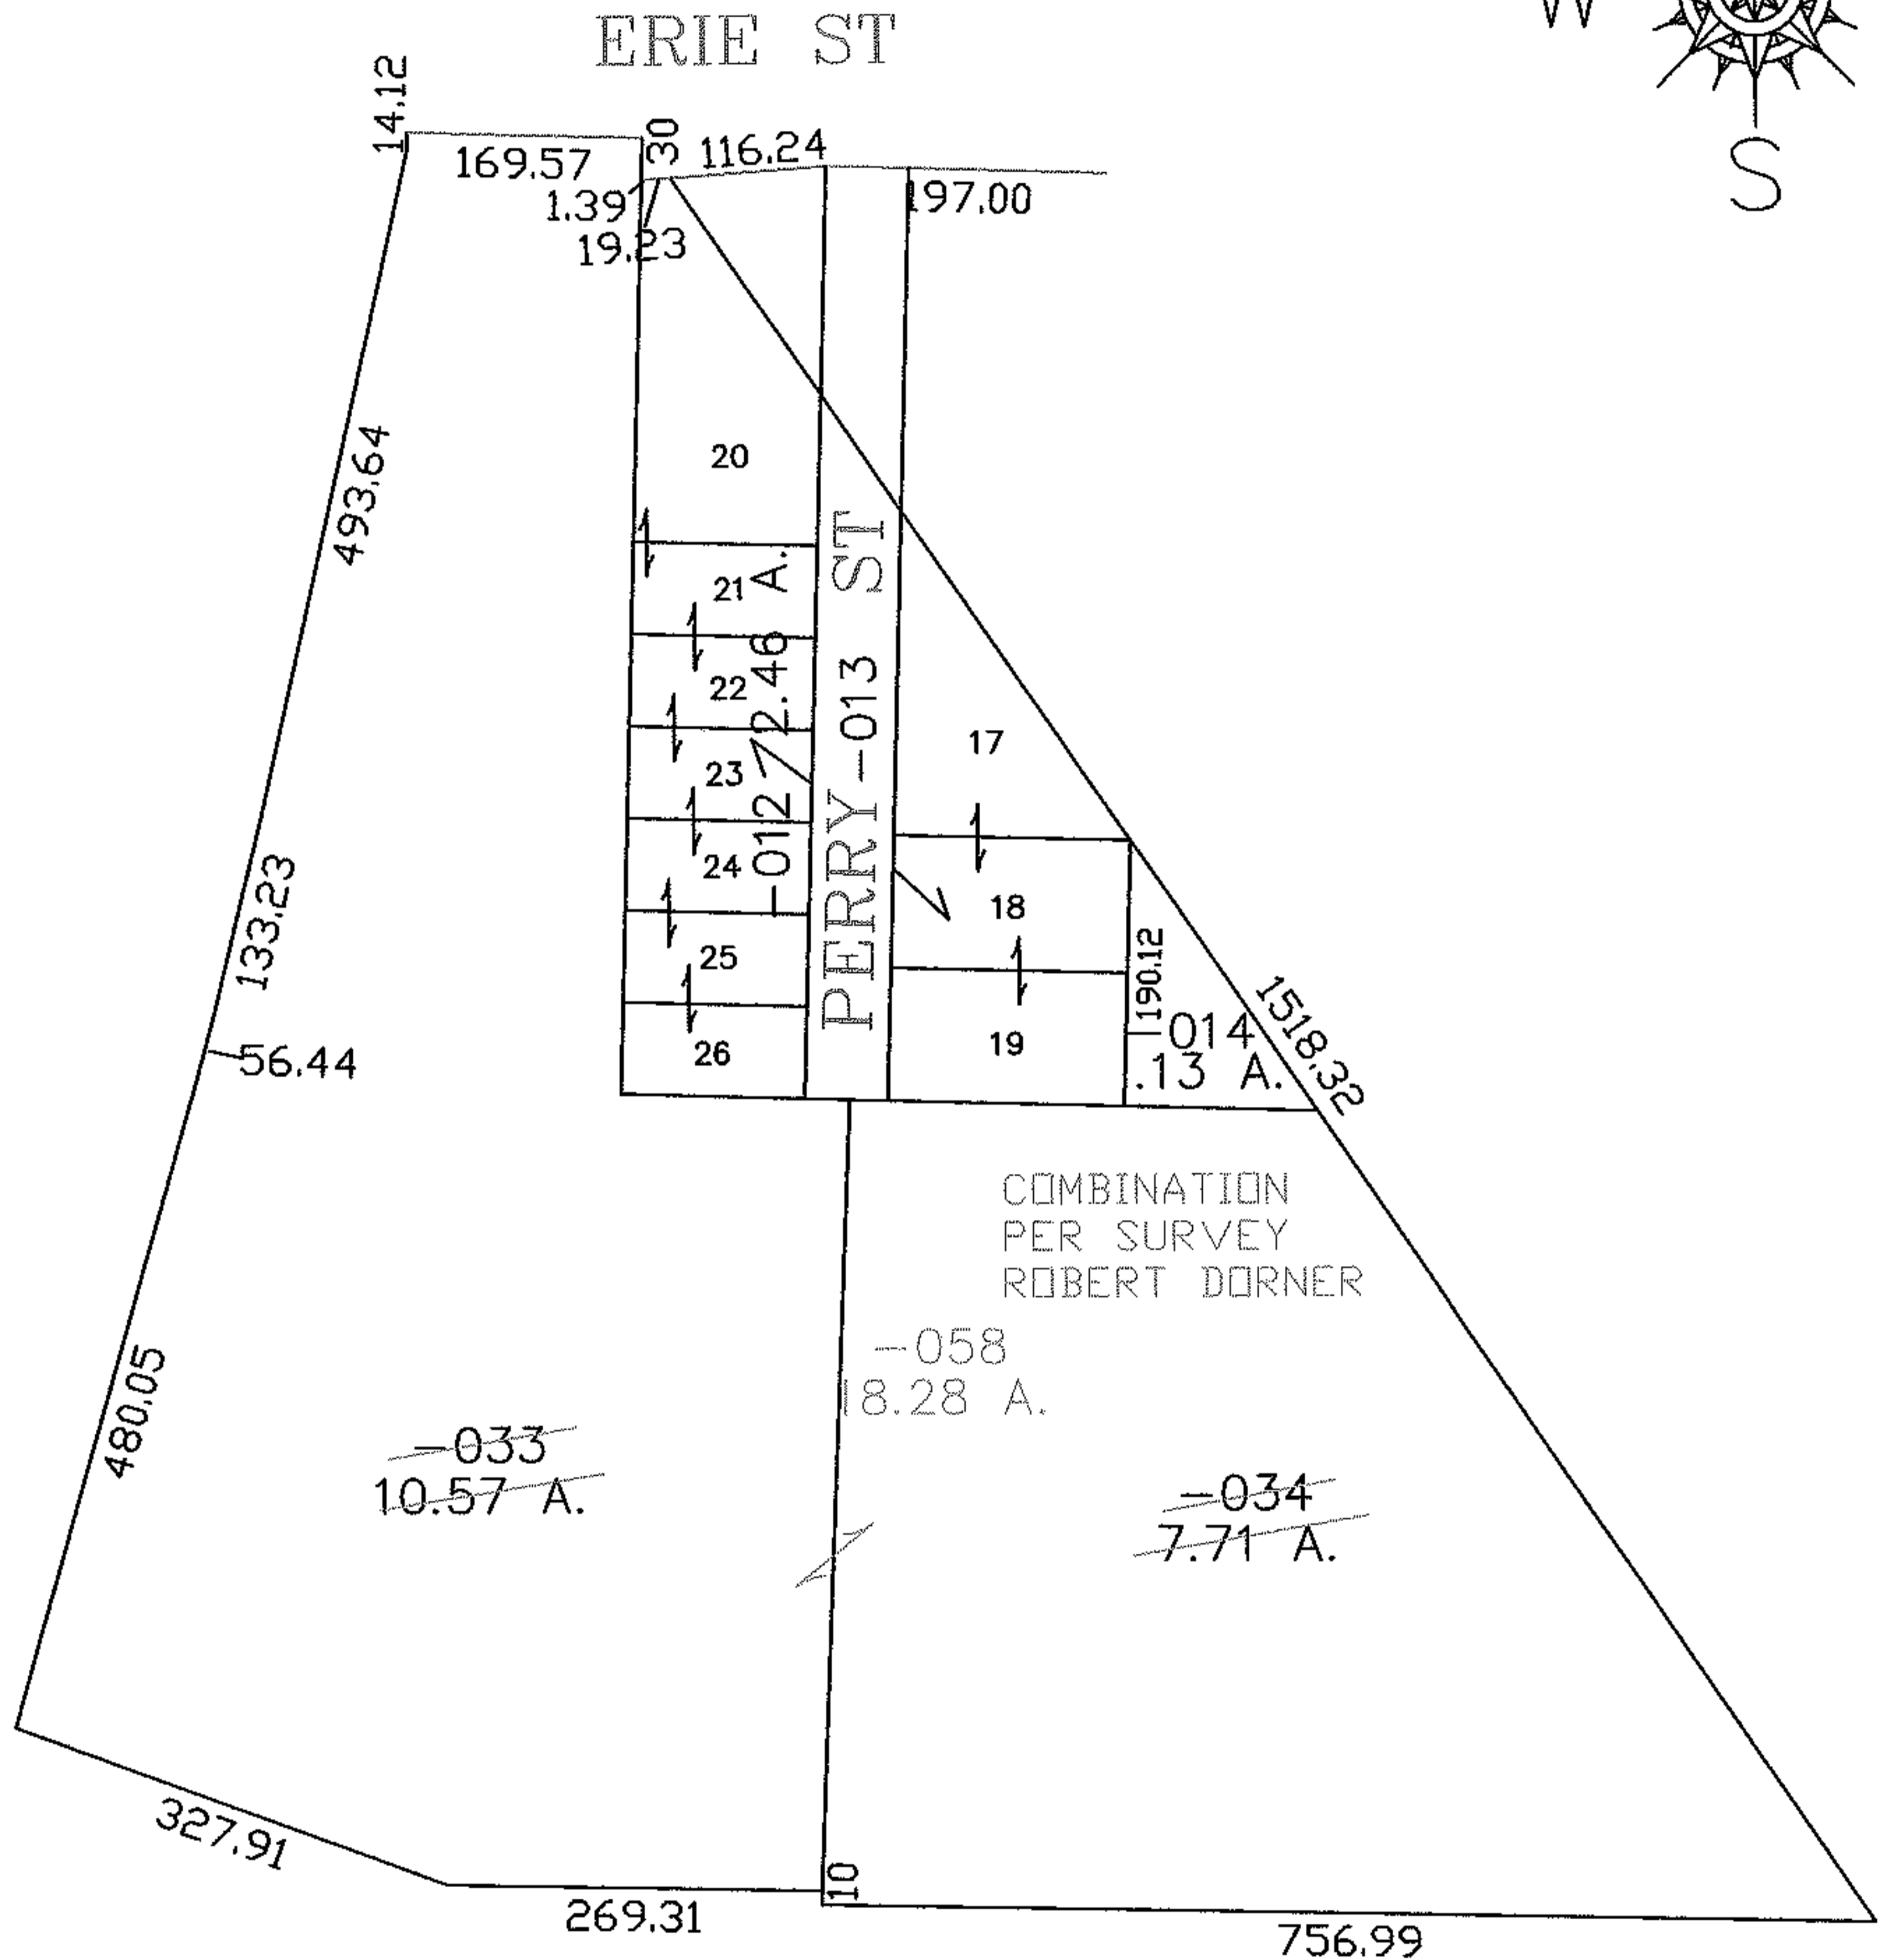


PARENT PARCEL: 18-00-027-112-033 & -034


CHILD PARCEL: 18-00-027-112-058

STARTING POINT:

06-01359-D

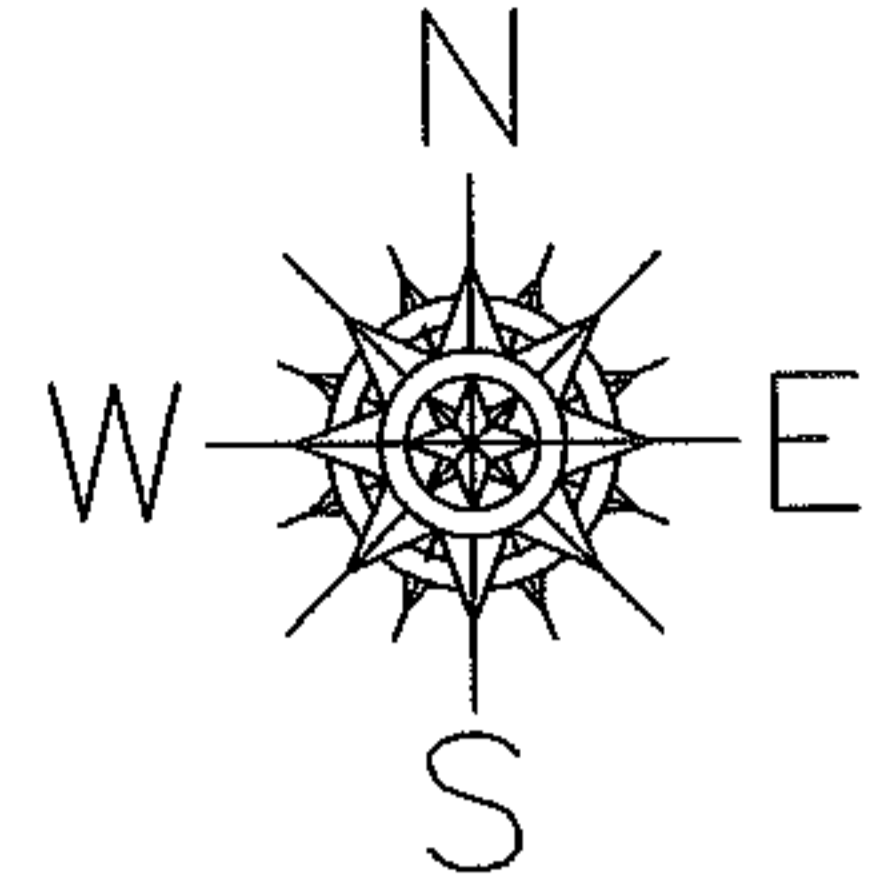

PRIOR INSTRUMENT: 970484709-1245

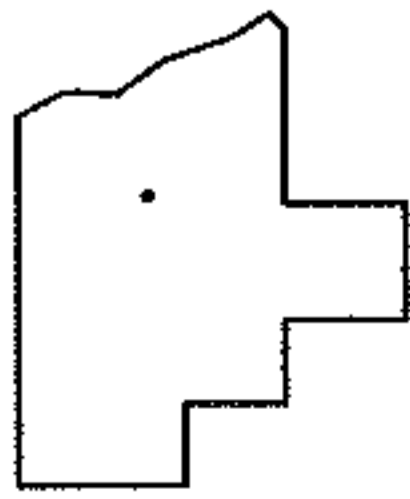

SPLITS/DEEDS PROCESSED
LORAIN COUNTY TAX MAP DEPARTMENT
 226 MIDDLE AVE. ELYRIA, OHIO

SURVEYED BY: ROBERT DORNER
 CLOSURE: 1:10,000
 MAP PAGE(S): 18-00-027-D
 APPROVED BY: DRH DATE: 7/24/2006
 SCALE: 1" = 200'