




PARENT PARCEL: 03-00-095-107-011

CHILD PARCEL: --SAME--

STARTING POINT: SL 896

06-01360-C

DUPLICATE CHANGE
MAP
CORRECT

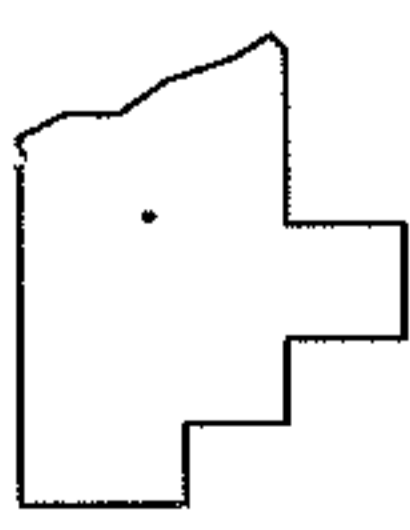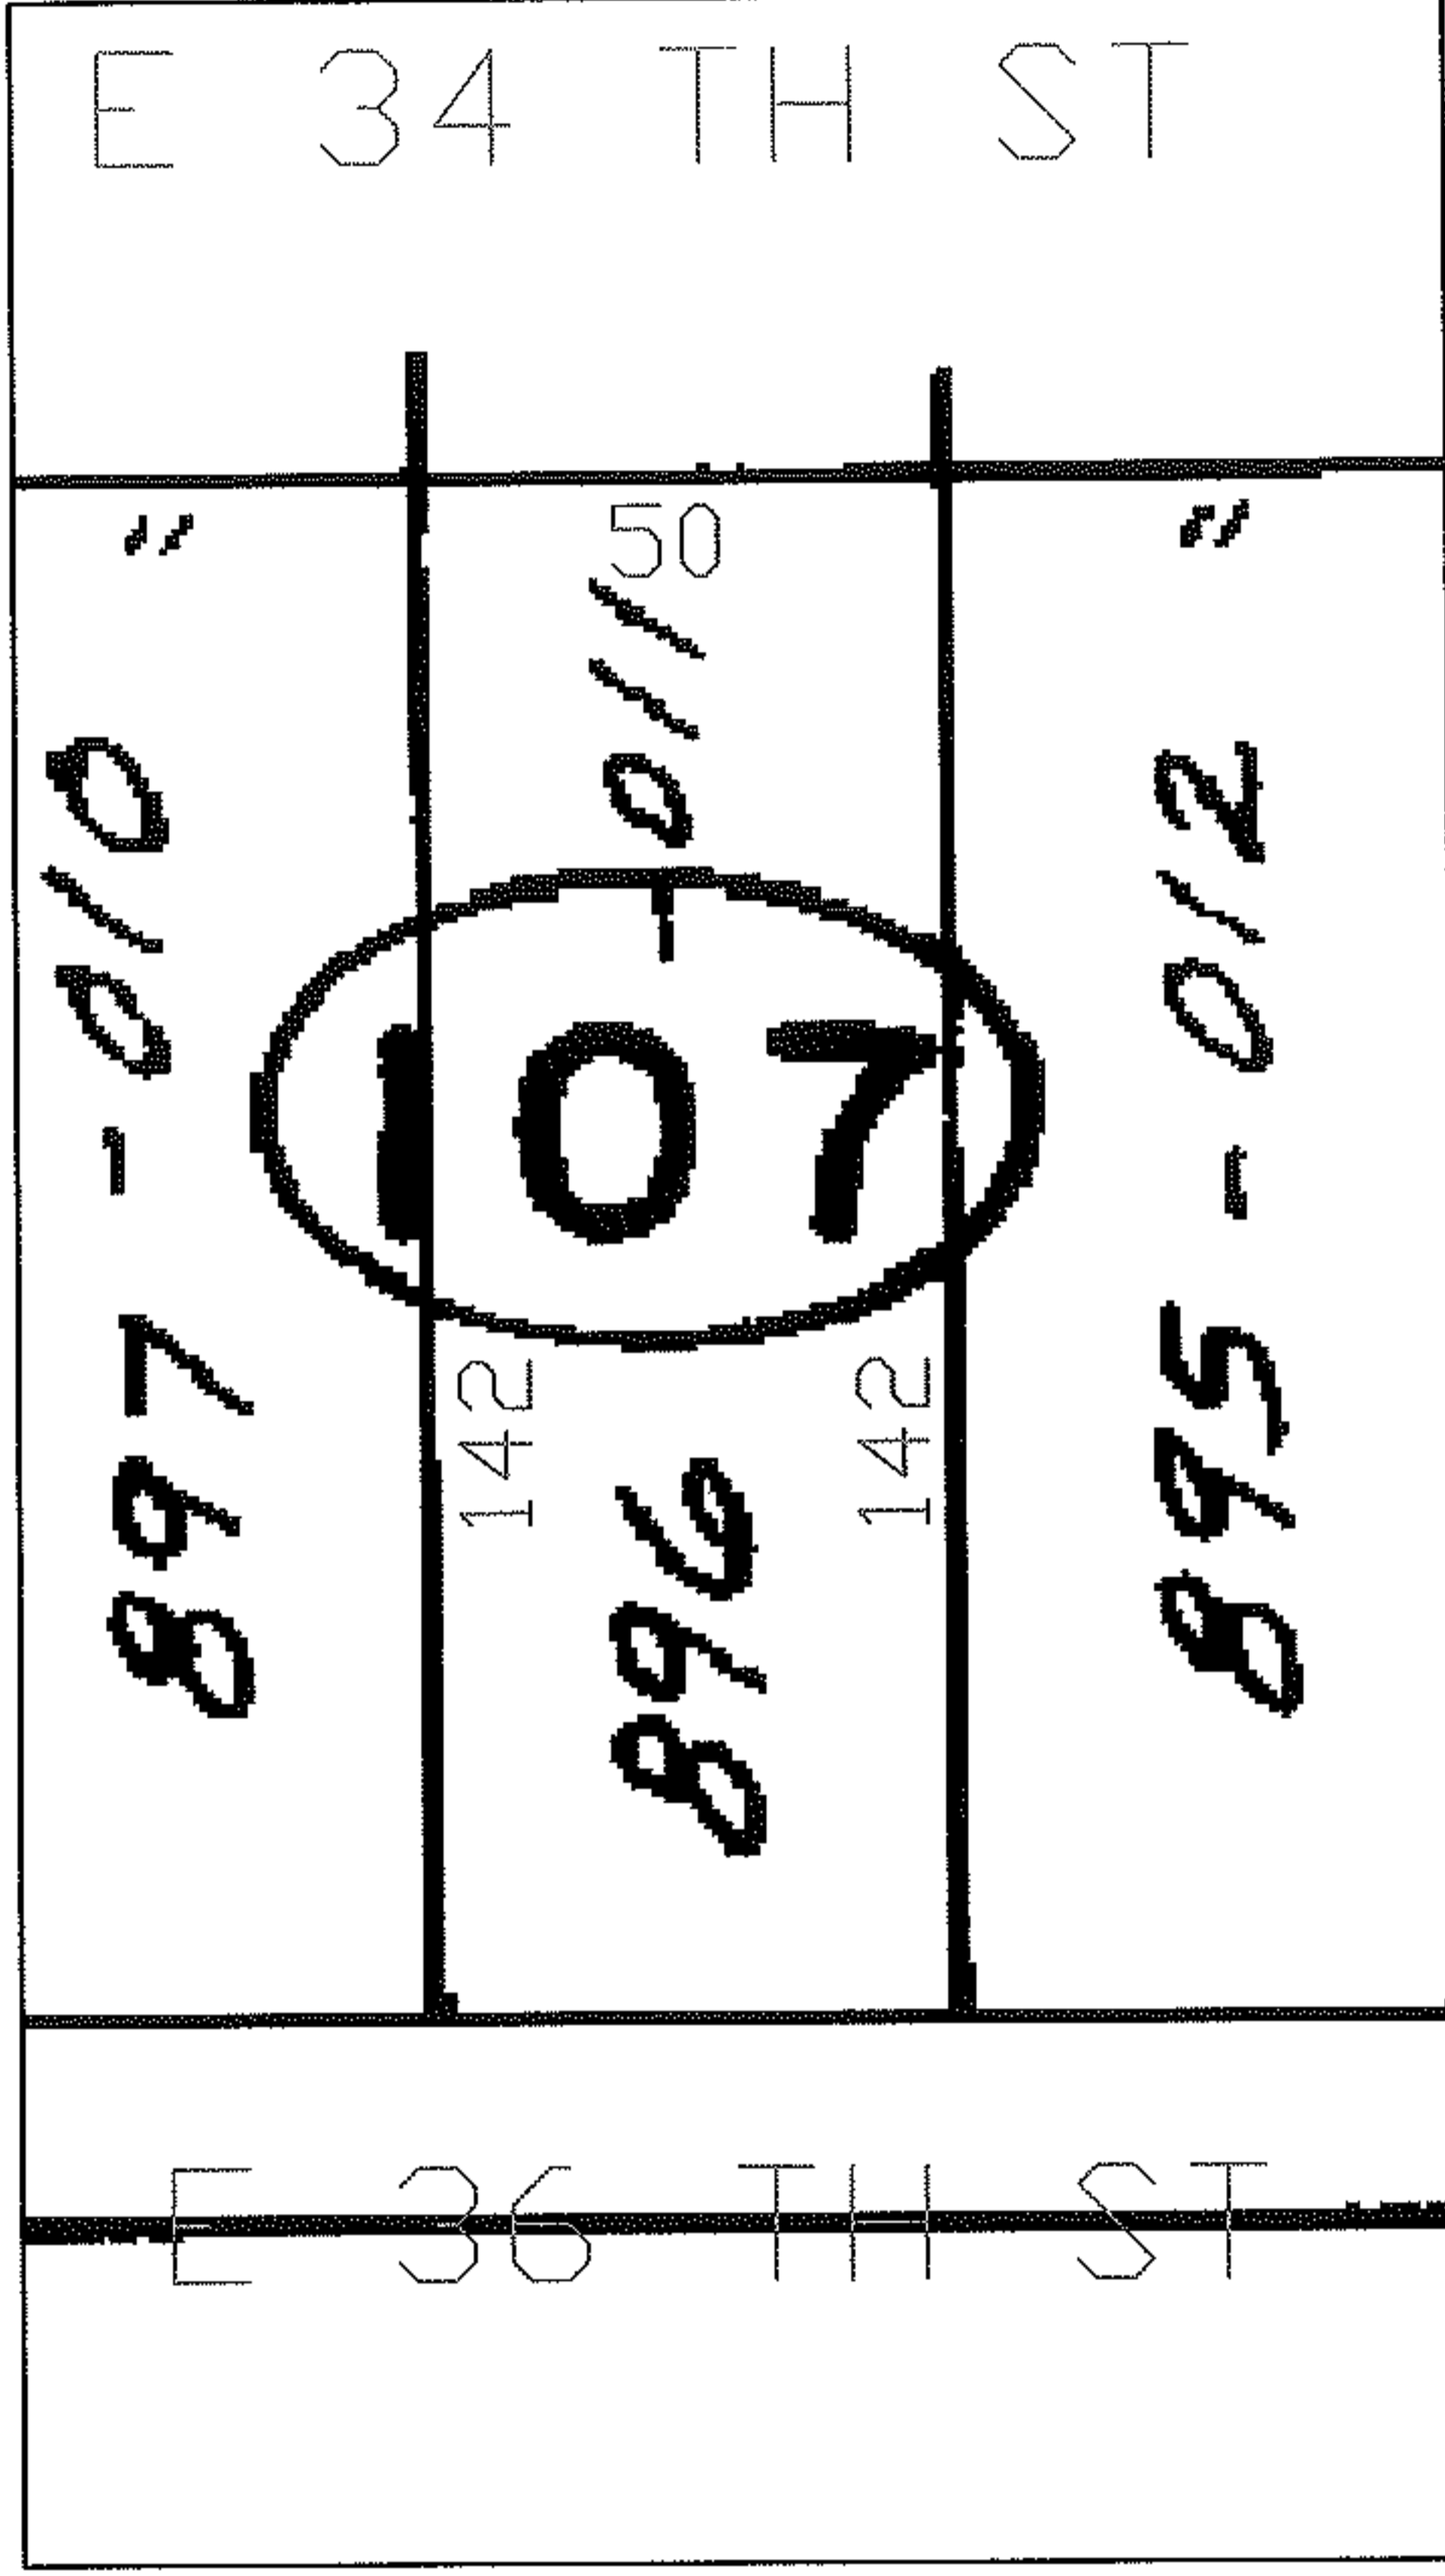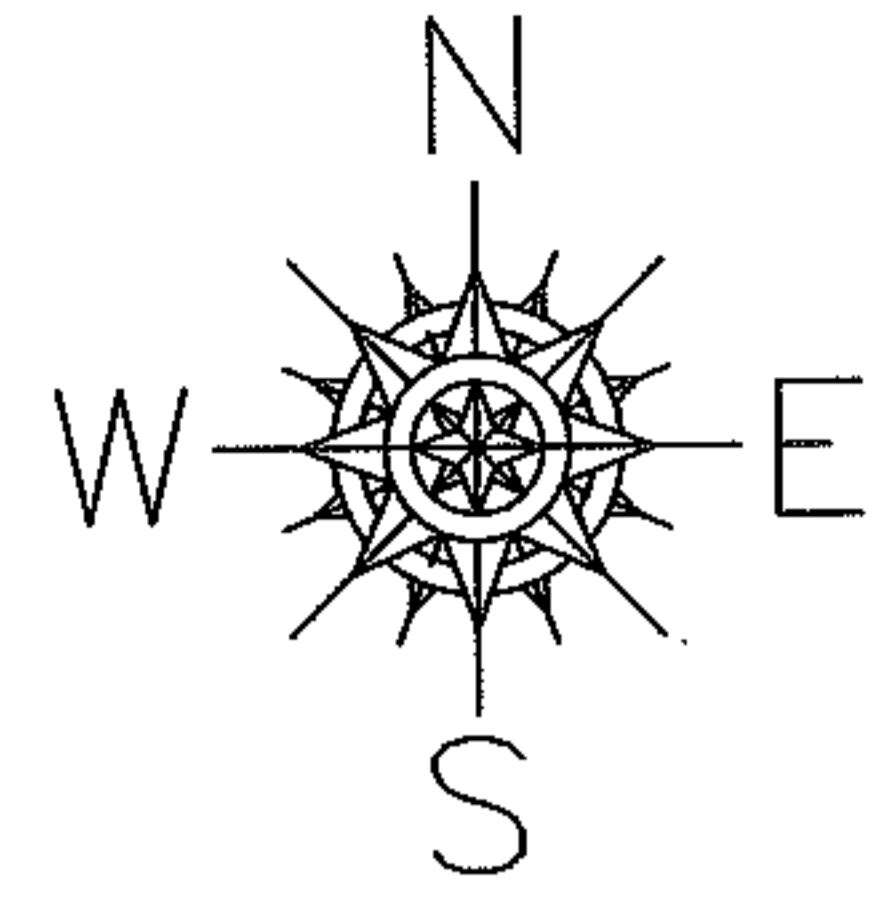

SPLITS/DEEDS PROCESSED
LORAIN COUNTY TAX MAP DEPARTMENT
226 MIDDLE AVE. ELYRIA, OHIO

SURVEYED BY:	N/A
CLOSURE:	N/A
MAP PAGE(S):	03-00-095-A
APPROVED BY:	DRH
DATE:	6/27/2006
SCALE:	1" = 400
PRIOR INSTRUMENT:	DV 706/433