


RASTER

PARENT PARCEL: 12-00-045-000-023, 12-00-036-000-048


CHILD PARCEL: XX-XX-XXX-XXX-XXX

STARTING POINT: S.W. CORNER OF O.L. 36

06-01368-C

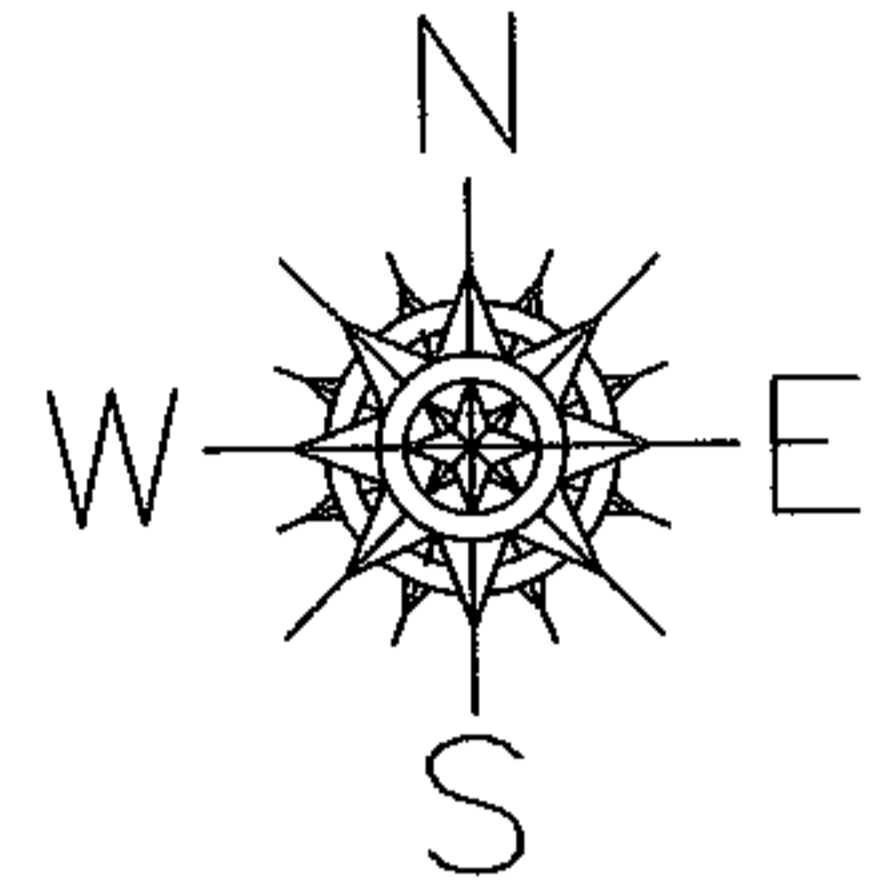

# ACREAGE CORRECTION

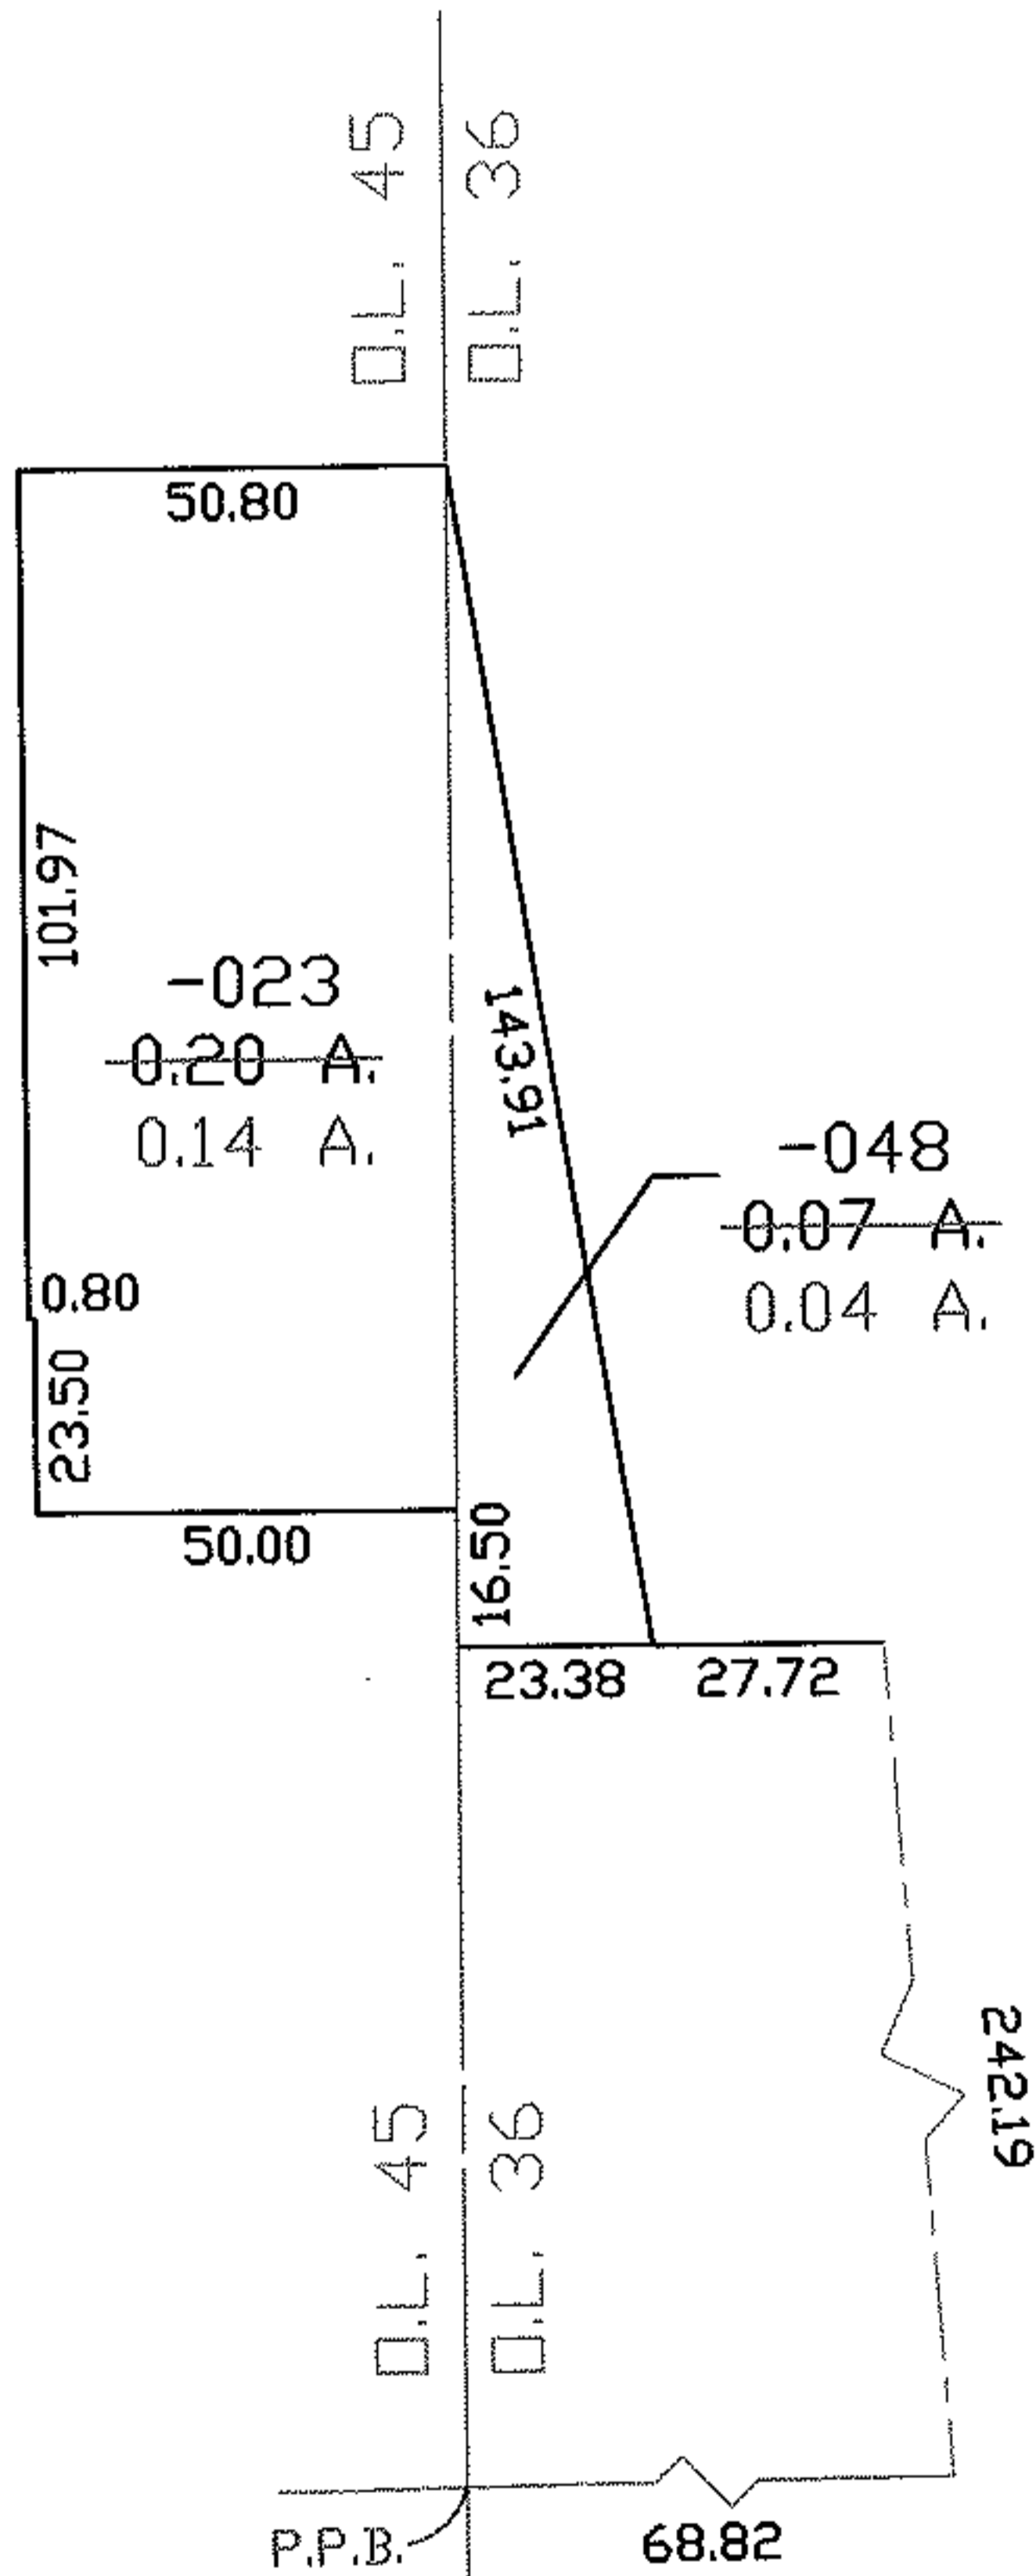

12-00-045-000-023

~~0.20~~ A.

0.14 A.


12-00-036-000-048

~~0.07~~ A.

0.04 A.

CORR. PER SURV.

MARK A. YEAGER

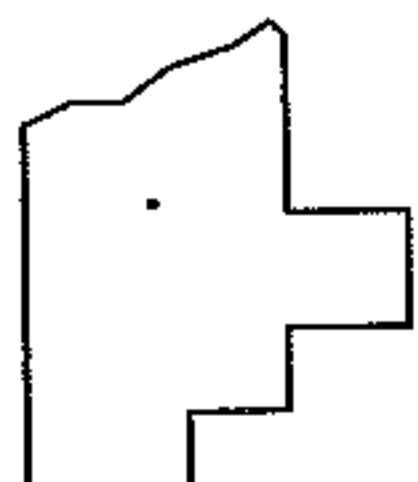

## SPLITS/DEEDS PROCESSED

LORAIN COUNTY TAX MAP DEPARTMENT  
226 MIDDLE AVE. ELYRIA, OHIO

SURVEYED BY: MARK A. YEAGER

CLOSURE: 0.02 : 10.000

MAP PAGE(S): 12-00-045-B, 12-00-036-A

APPROVED BY: TJS DATE: 7/12/06

SCALE: 1" = 100 PRIOR INSTRUMENT: 19990600038