

MASTER



PARENT PARCEL: 06-23-012-105-037

06-01383-D

CHILD PARCEL: --SAME--

STARTING POINT: INT MAPLEWOOD RD AND S.R. 57

ADD TO DUP

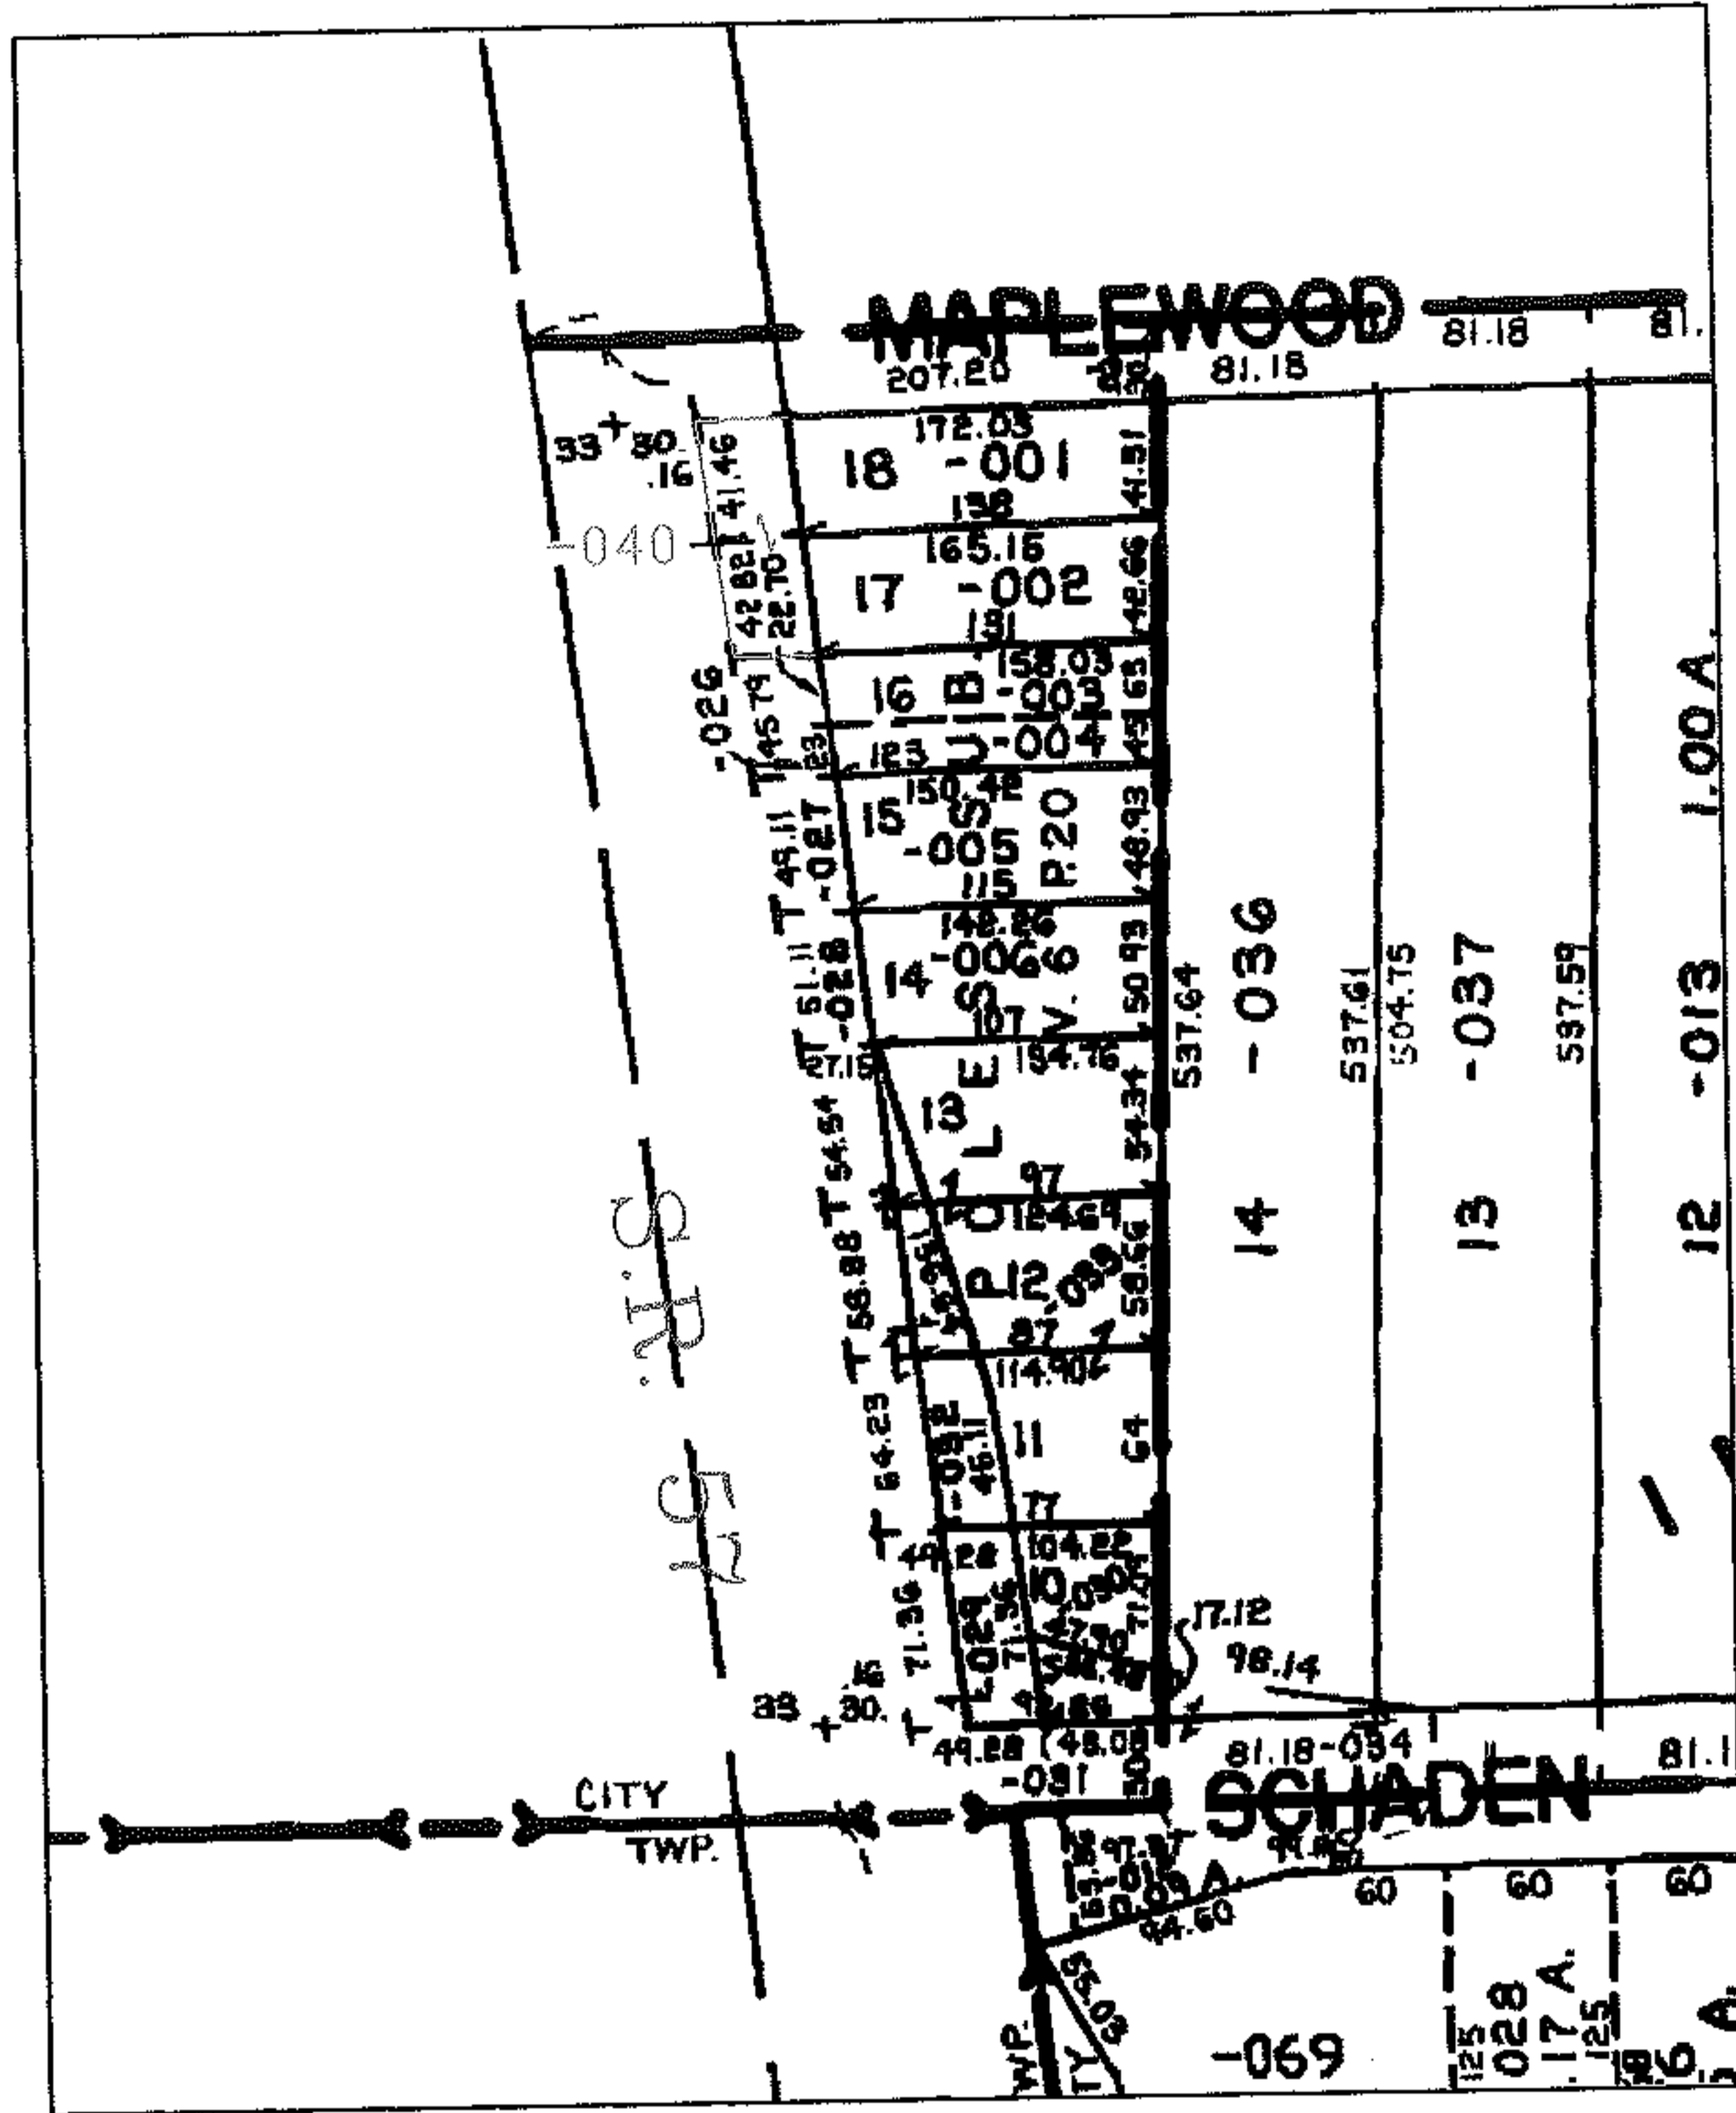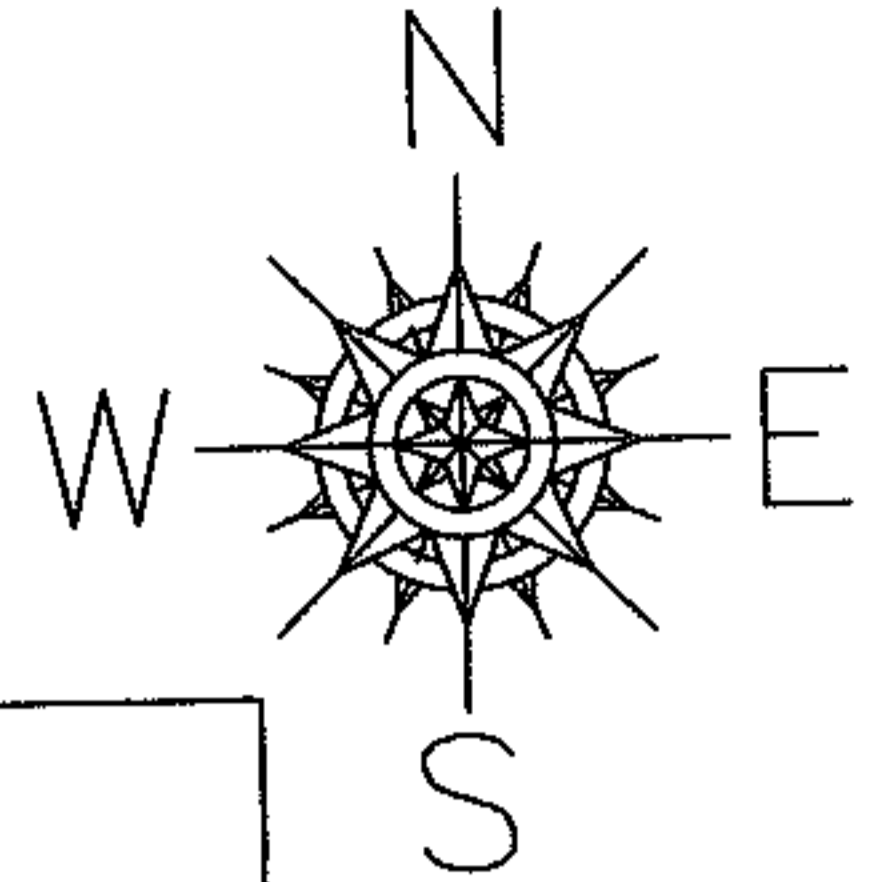

SPLITS/DEEDS PROCESSED
LORAIN COUNTY TAX MAP DEPARTMENT
226 MIDDLE AVE. ELYRIA, OHIO

SURVEYED BY: N/A
CLOSURE: N/A
MAP PAGE(S): 06-28
APPROVED BY: DRH DATE: 12/19/2006
SCALE: 1" = 200' PRIOR INSTRUMENT: