



PARENT PARCEL: --ADD TO DUPLICATE-- & 06-25-016-101-009

06-01384-D

CHILD PARCEL: 06-25-016-101-009 & 044

STARTING POINT: NE CORNER OF LOT 2 IN MEADOWBROOK ALLOTMENT

ADD TO DUPLICATE
& FRONTAGE CORR
PER DEED

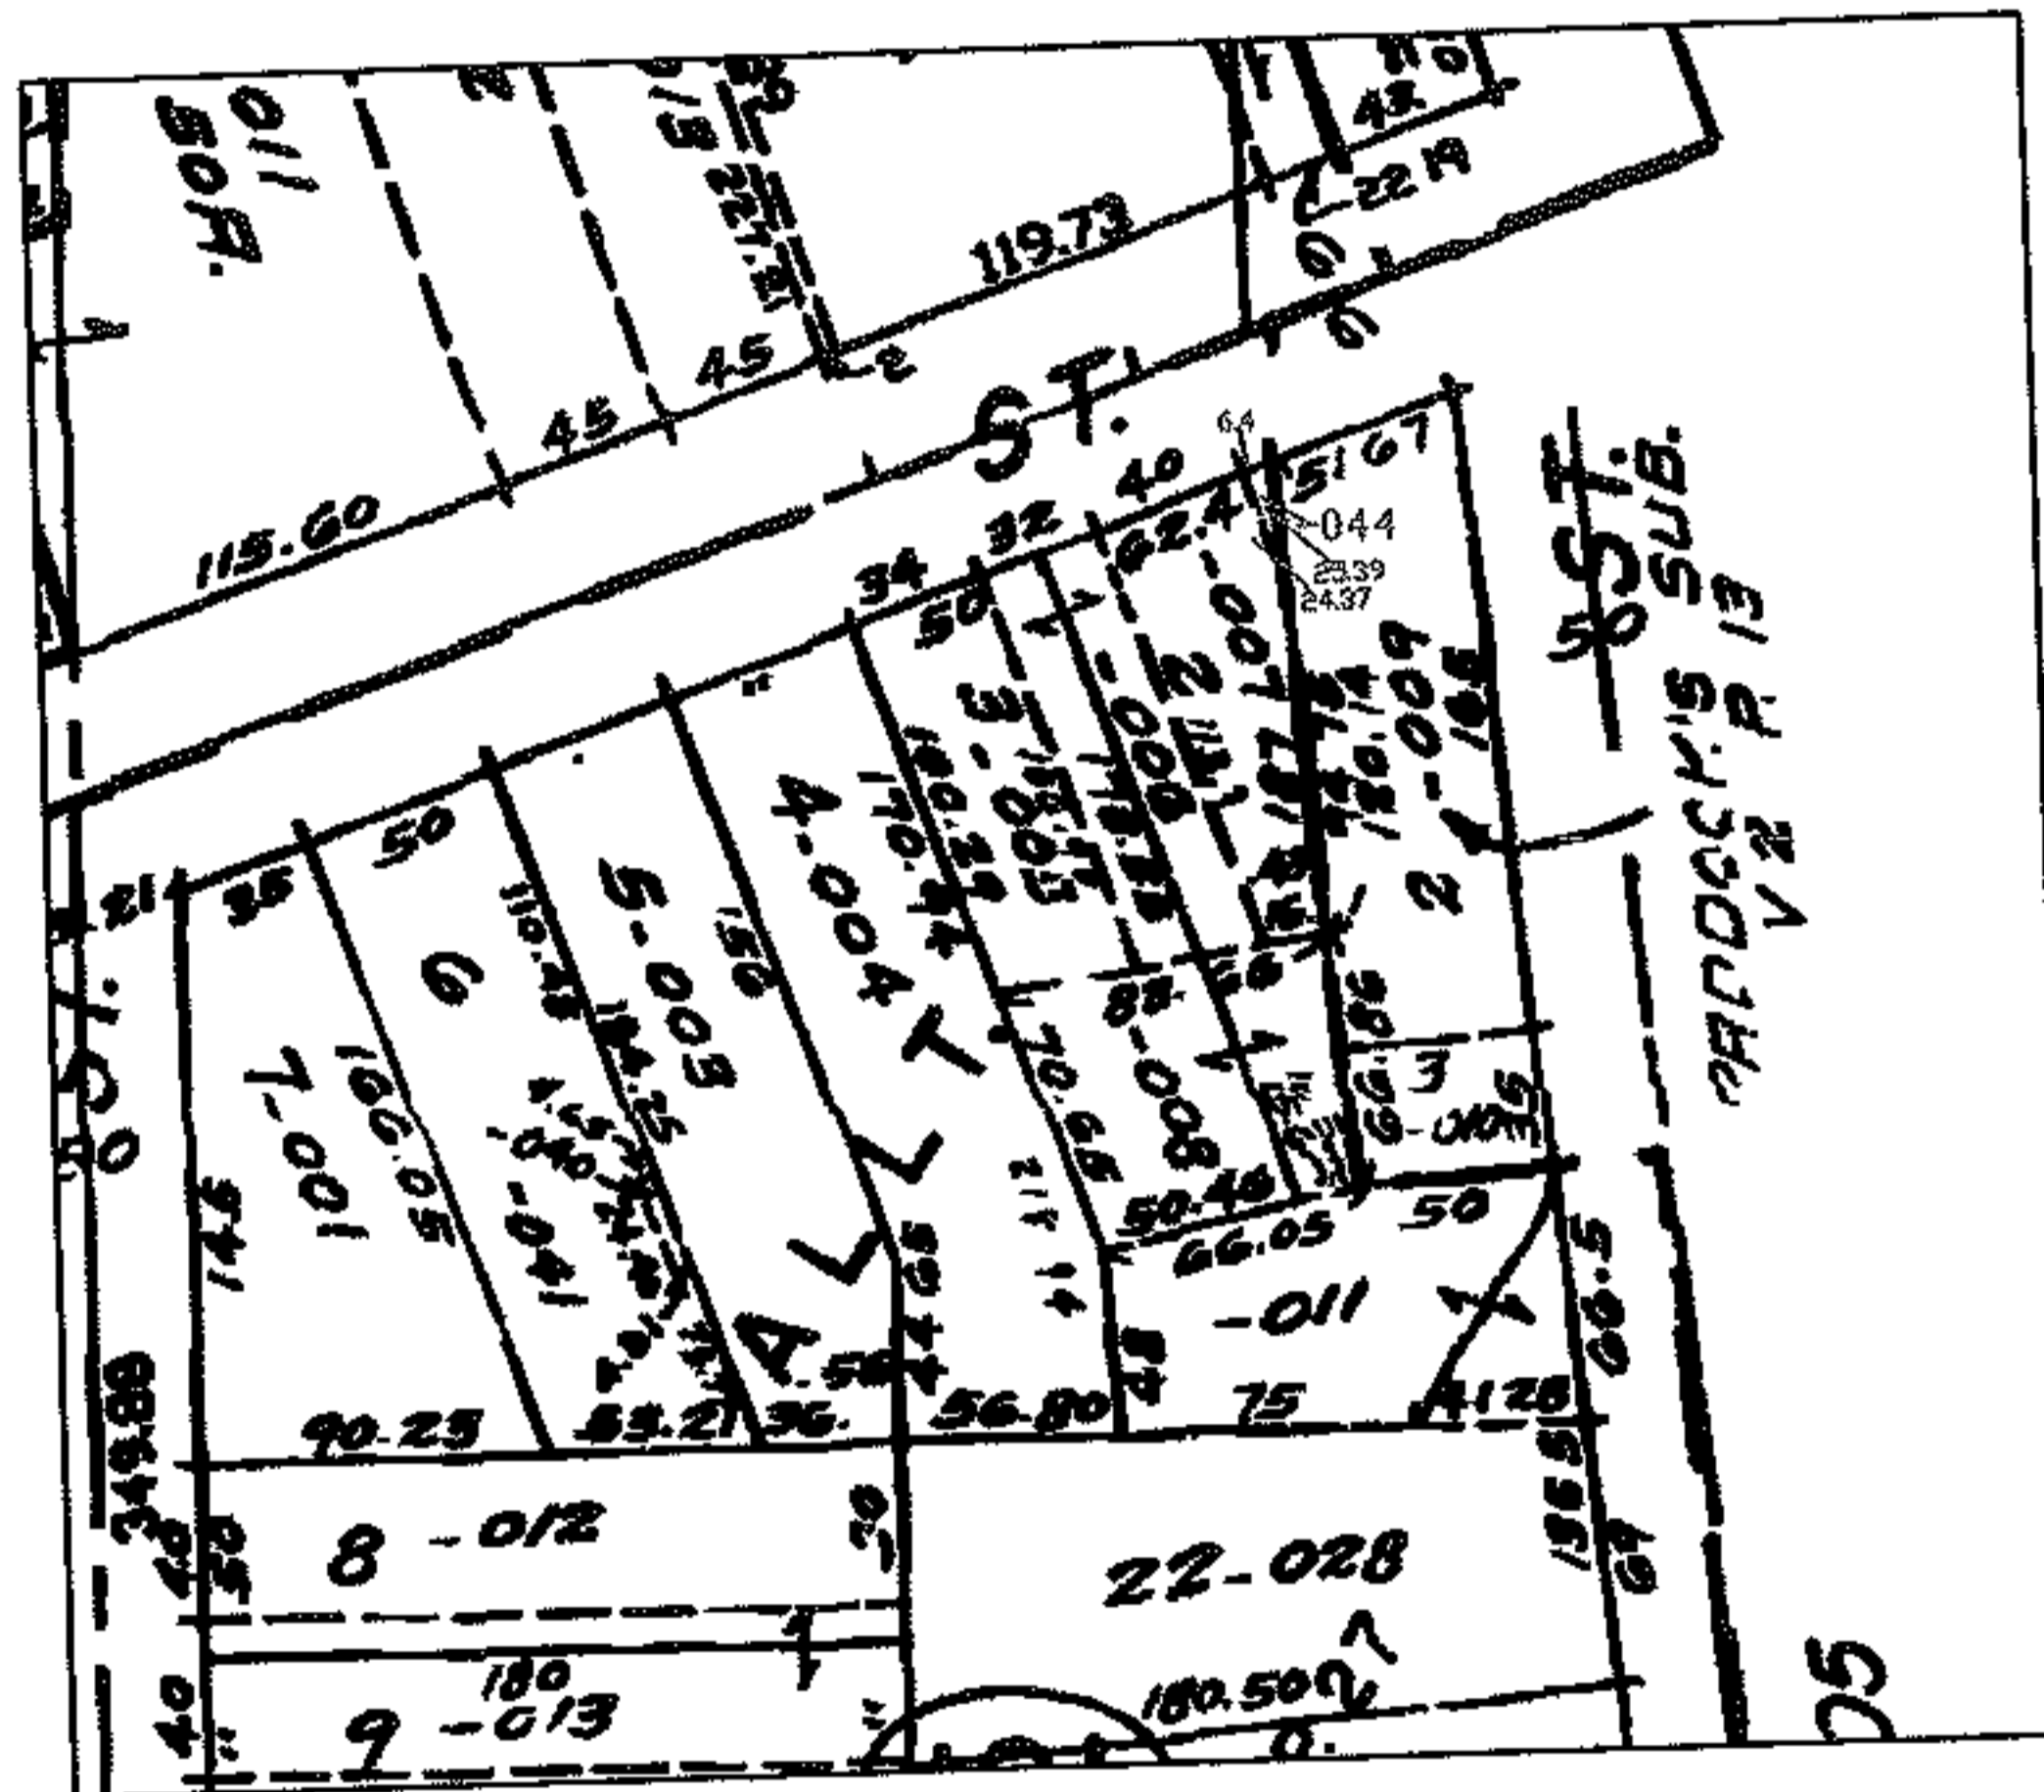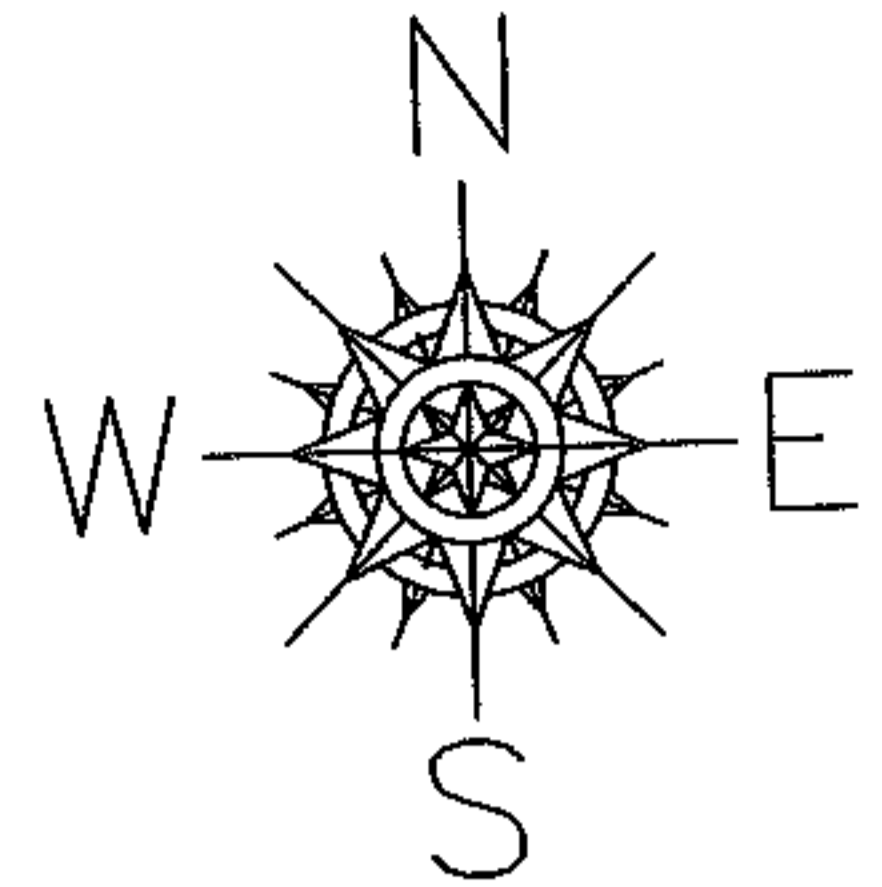

SPLITS/DEEDS PROCESSED

LORAIN COUNTY TAX MAP DEPARTMENT
226 MIDDLE AVE. ELYRIA, OHIO

SURVEYED BY: N/A

CLOSURE: N/A

MAP PAGE(S): 06-104

APPROVED BY: DRH DATE: 8/7/2006

SCALE: 1" = 200 PRIOR INSTRUMENT: OR 1250/511