


RASTER

PARENT PARCEL: 07-00-009-122-001



06-01392-C

CHILD PARCEL: --SAME--

STARTING POINT:

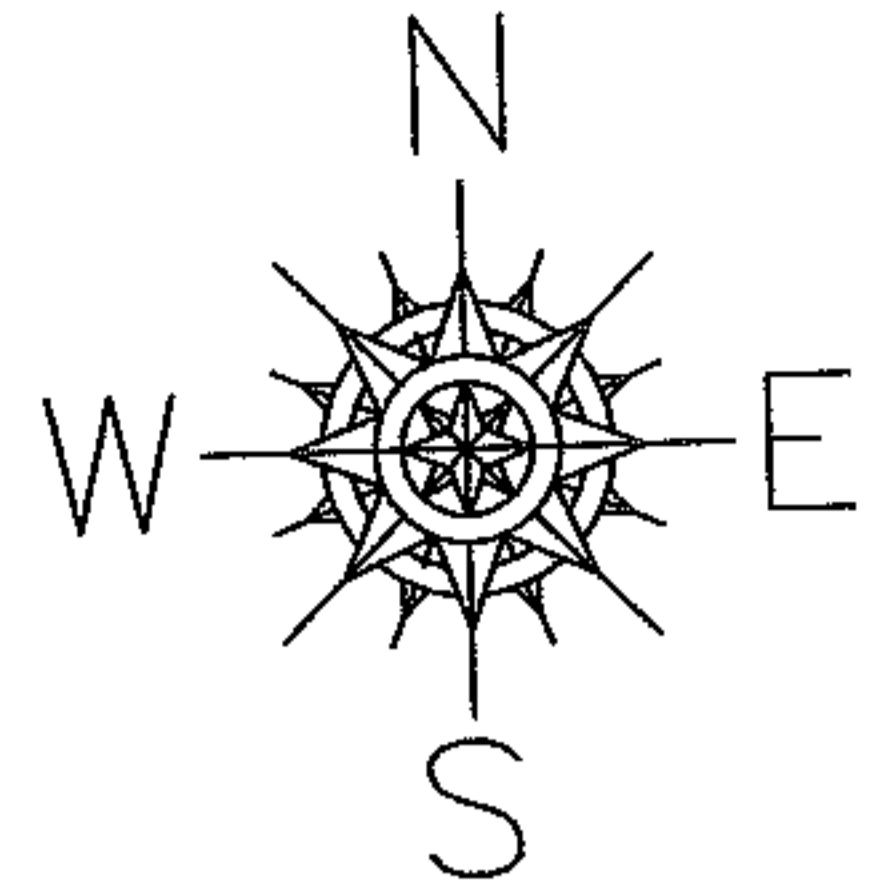

MAP CORRECTION ONLY

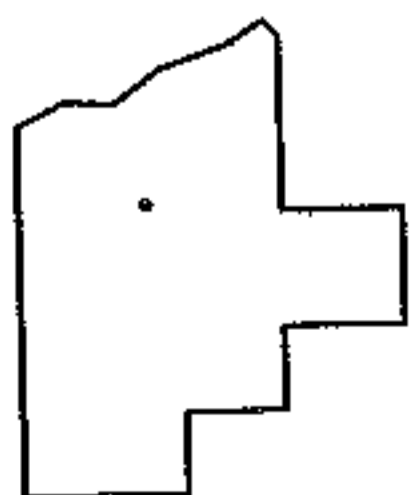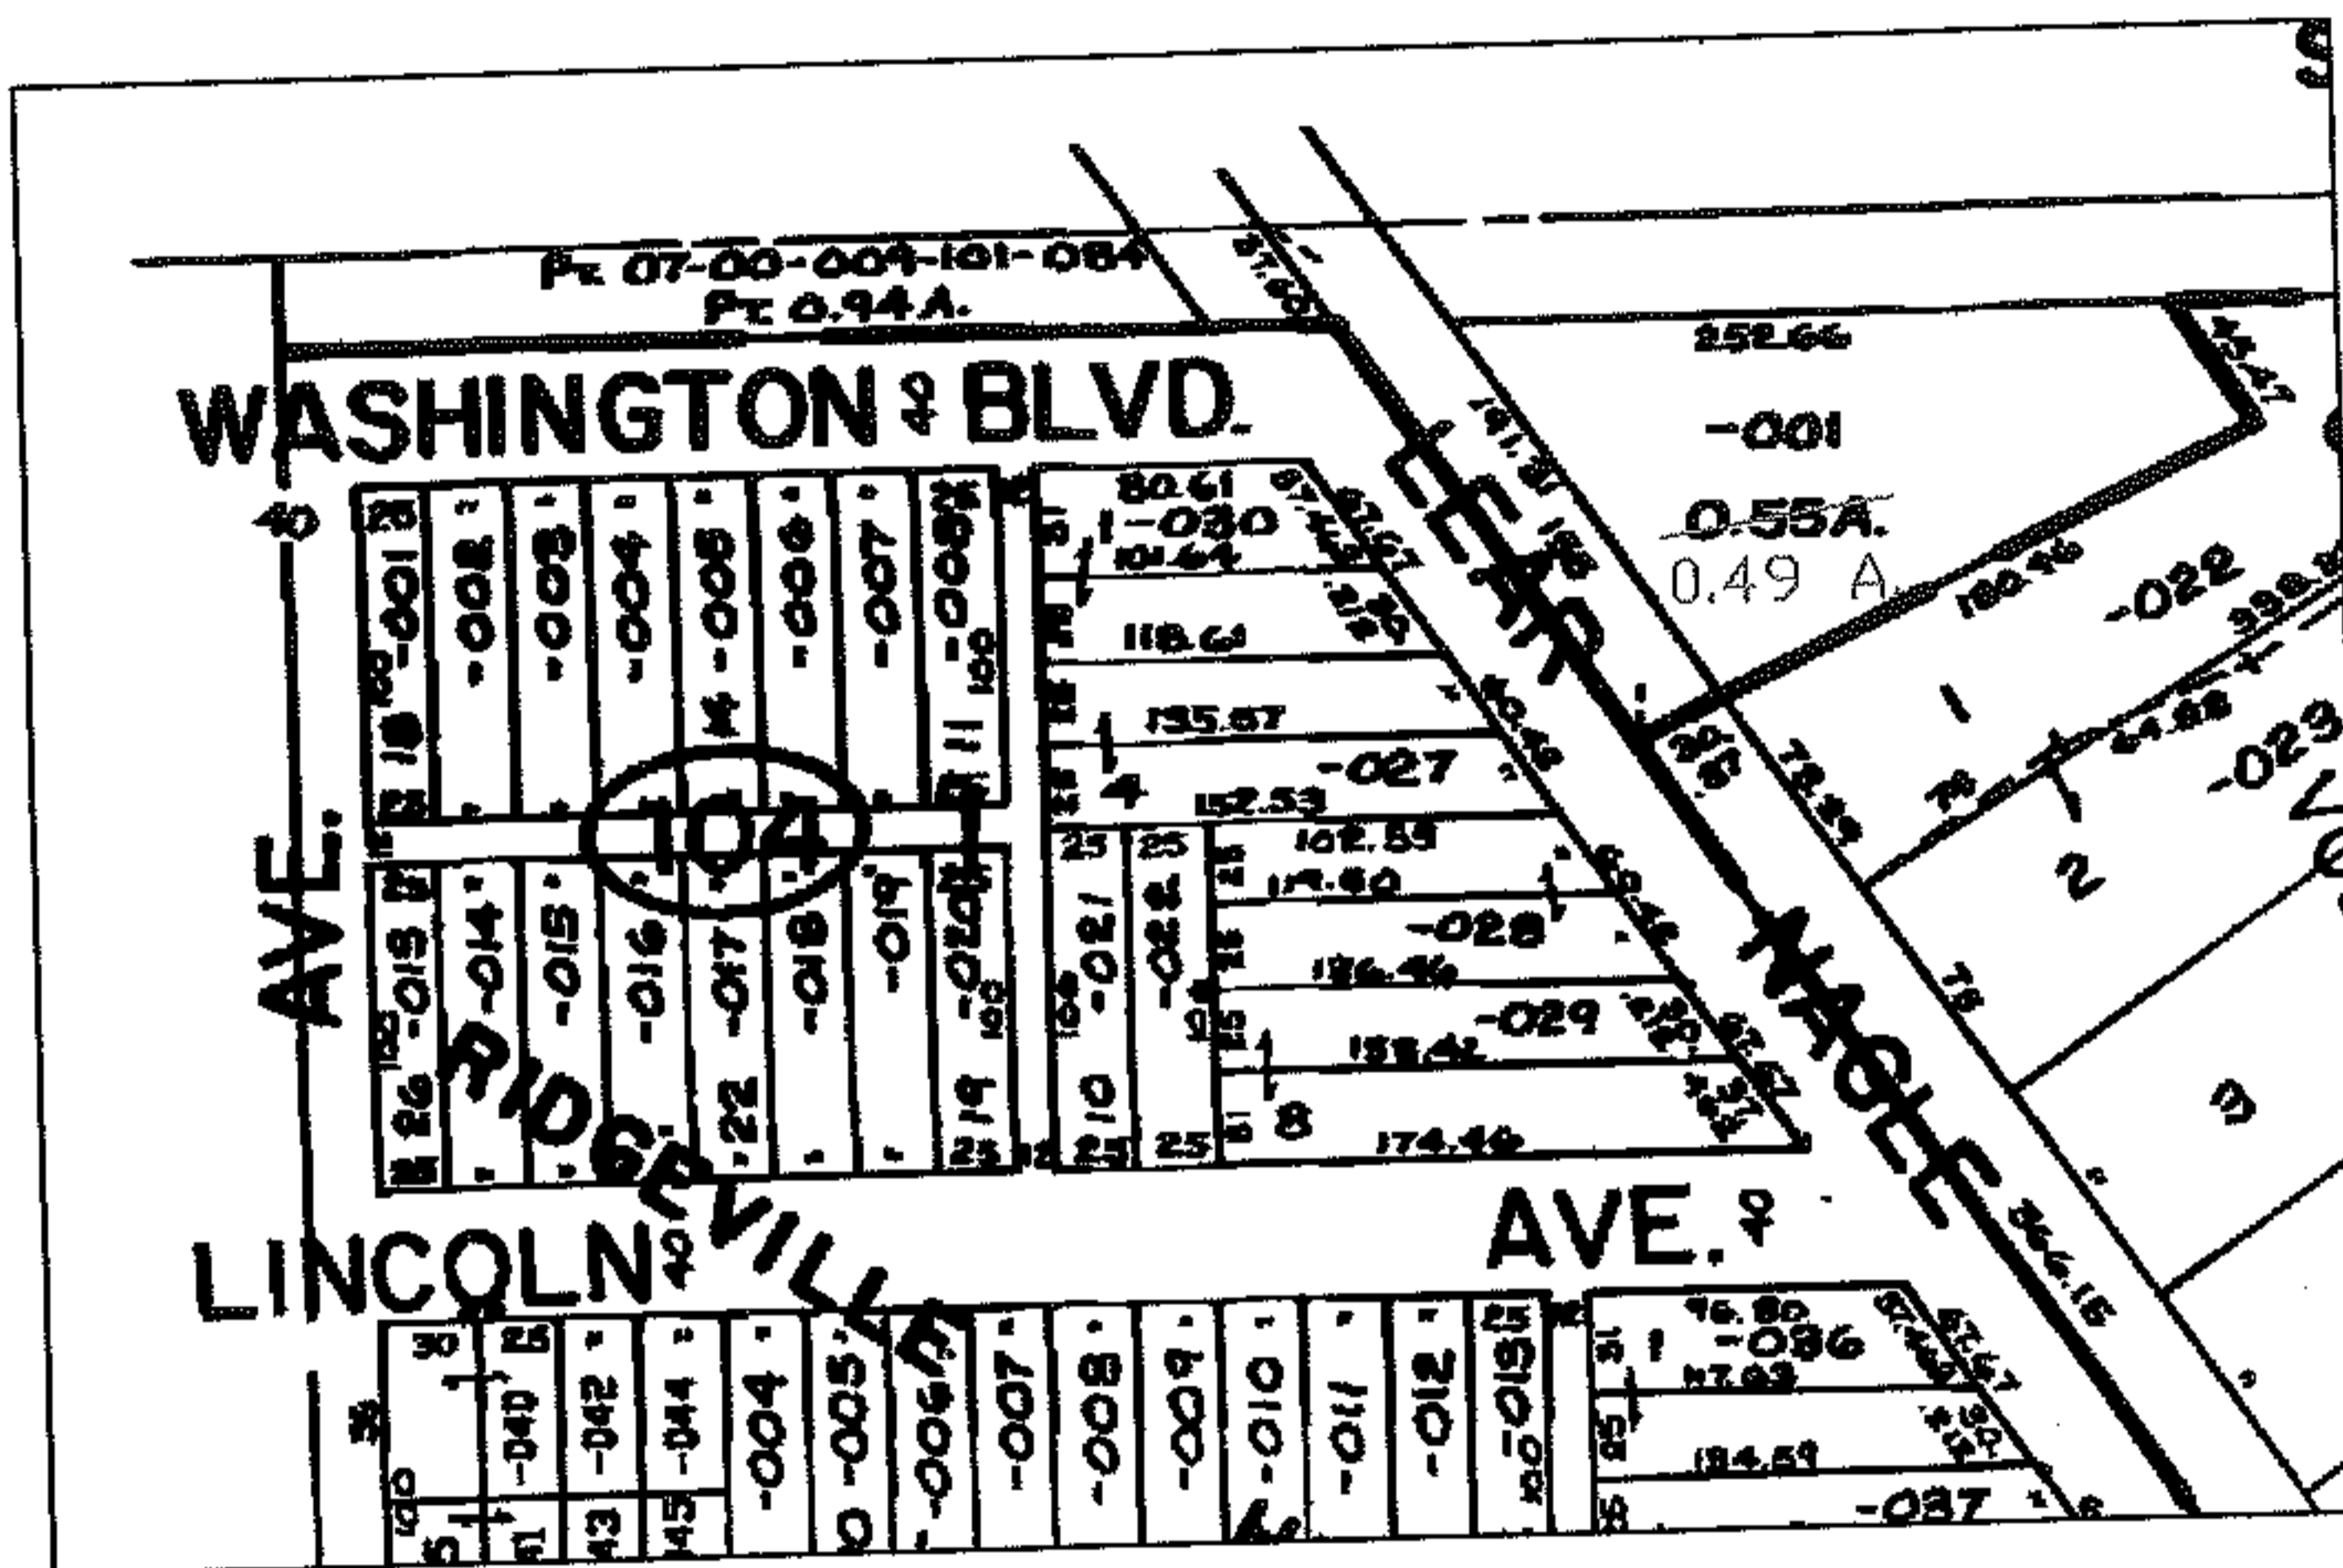

SPLITS/DEEDS PROCESSED
LORAIN COUNTY TAX MAP DEPARTMENT
226 MIDDLE AVE. ELYRIA, OHIO

SURVEYED BY: N/A
CLOSURE: N/A
MAP PAGE(S): 07-00-009-B
APPROVED BY: DRH DATE: 8/25/2006
SCALE: 1" = 200 PRIOR INSTRUMENT: 20030935348