

RASTER




PARENT PARCEL: 21-05-005-000-004, -005

06-01395-C

CHILD PARCEL: --SAME--

STARTING POINT: CENTERLINE OF ASHLAND-OBERLIN RD. & BURSLEY RD.

AC. CORRS.  
PER SURVEY  
THOMAS SIMON

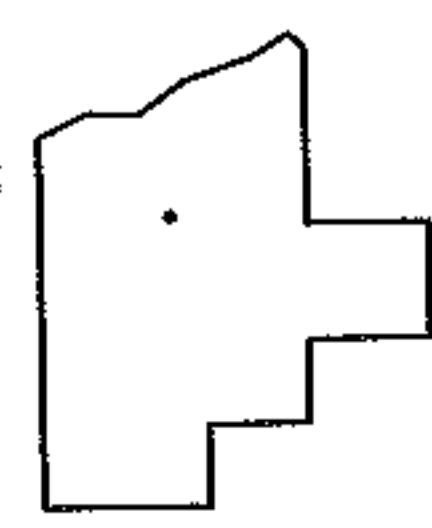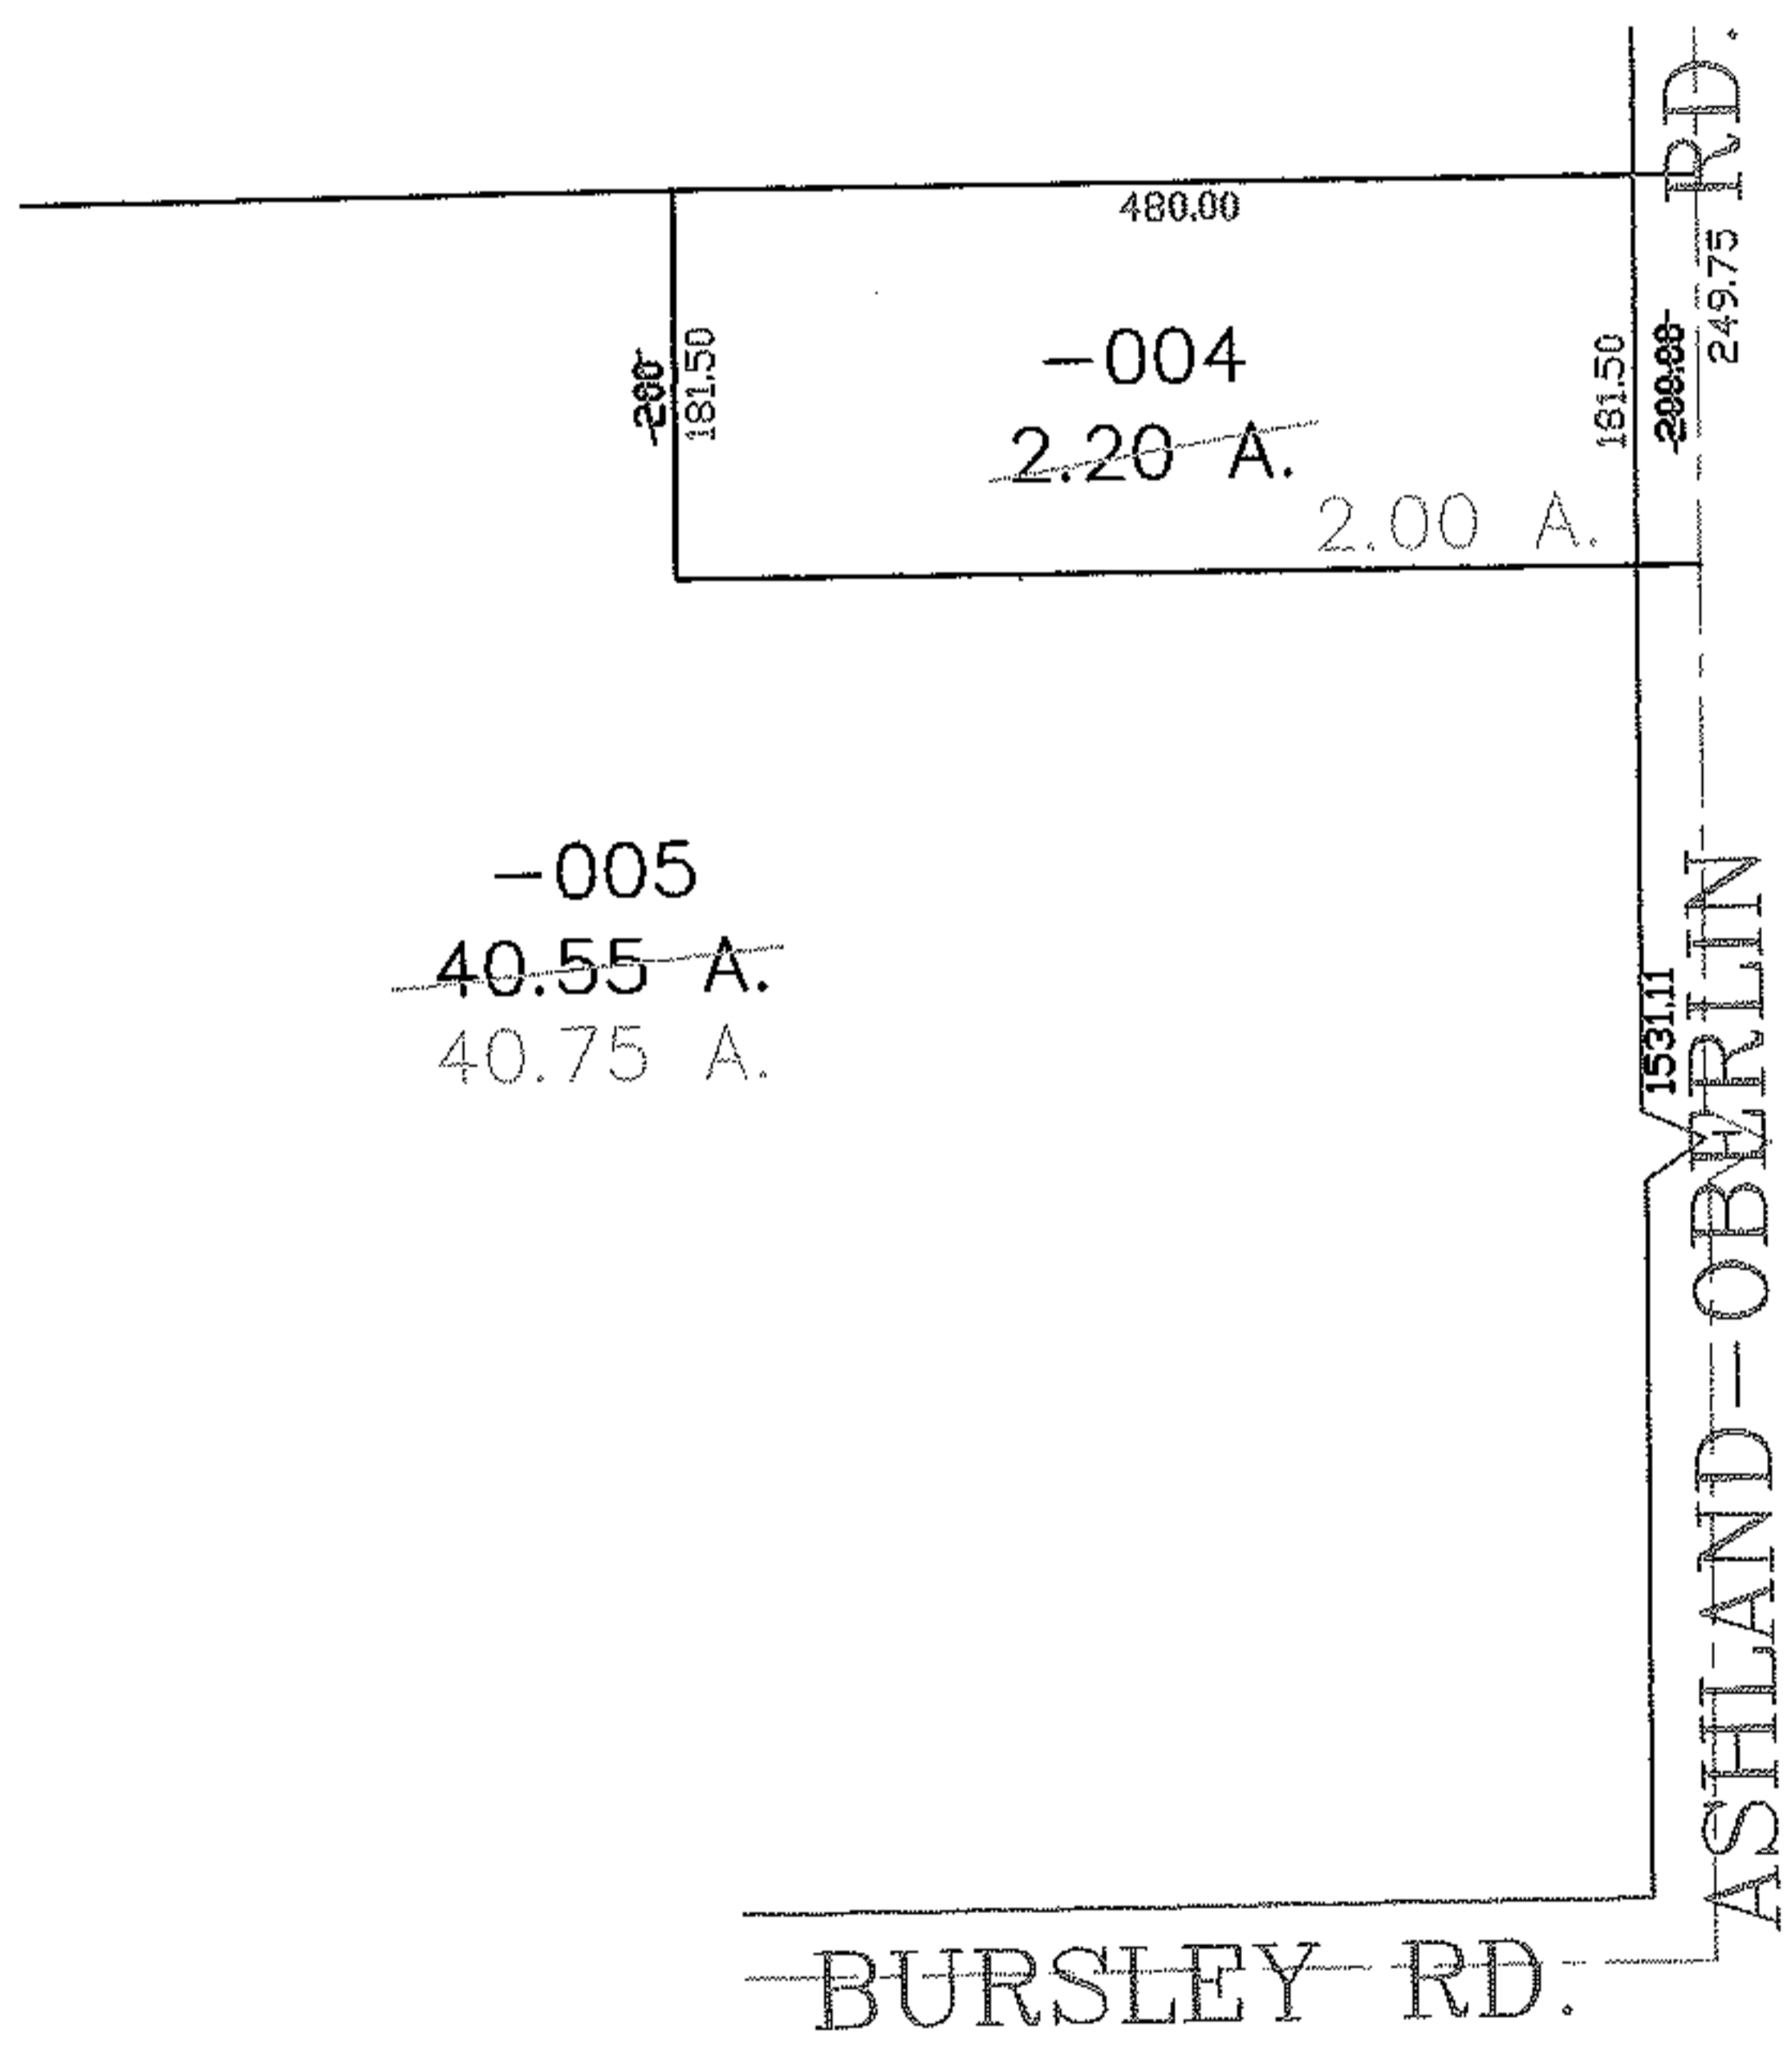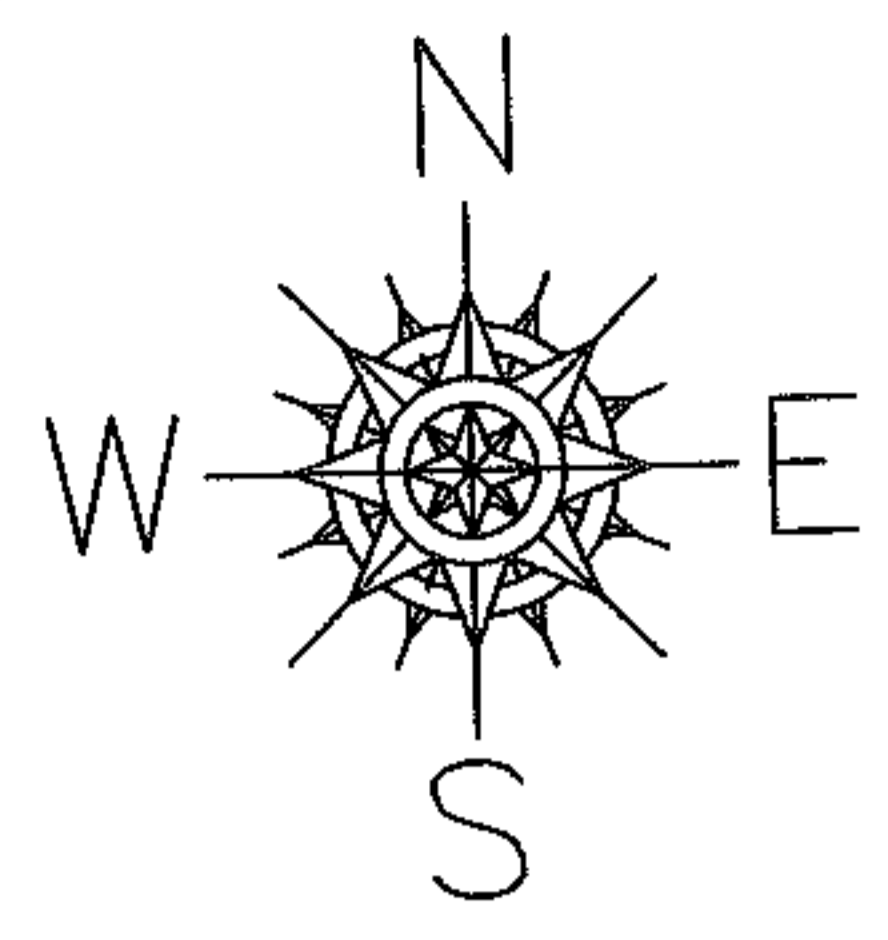

**SPLITS/DEEDS PROCESSED**  
LORAIN COUNTY TAX MAP DEPARTMENT  
226 MIDDLE AVE. ELYRIA, OHIO

SURVEYED BY: THOMAS A. SIMON  
 CLOSURE: 0.00 : 10,000  
 MAP PAGE(S): 21-B  
 APPROVED BY: DRH DATE: 8/30/2006  
 SCALE: 1" = 200' PRIOR INSTRUMENT: OR 1024/139