


RASTER

06-01396-C

PARENT PARCEL: 11-00-090-000-072
CHILD PARCEL: 11-00-088-000-070
STARTING POINT:

BUTTERNUT RIDGE RD

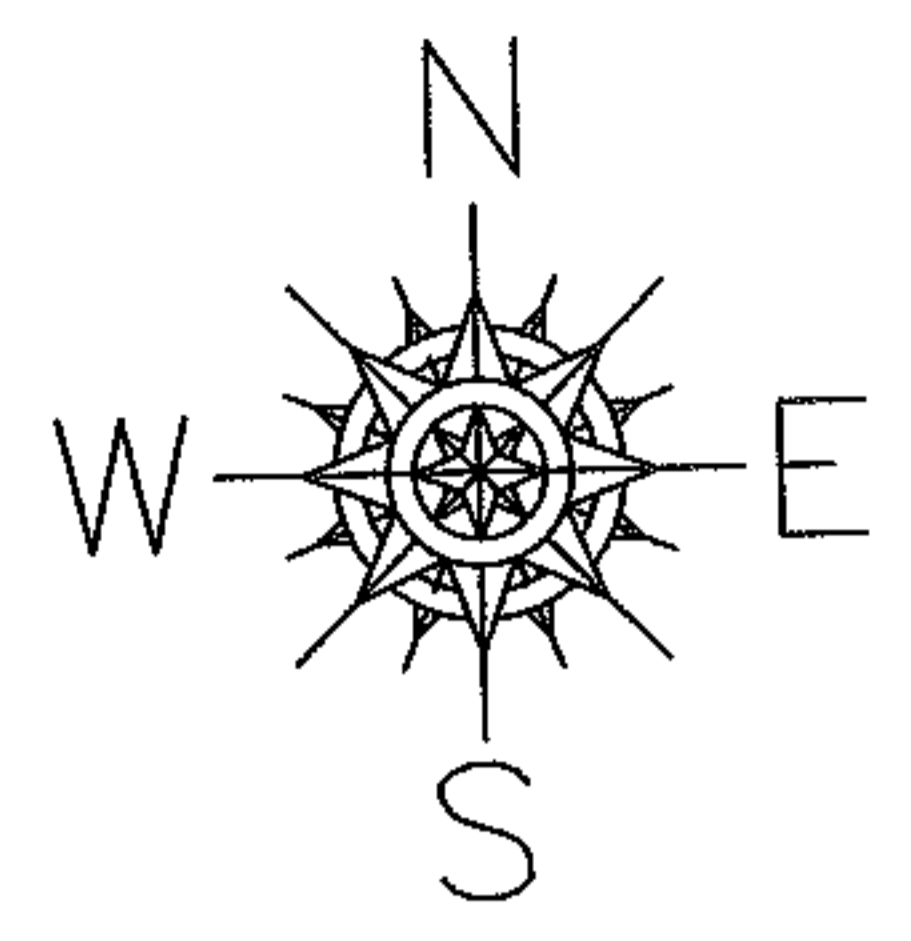

DROP FROM DUP
11-00-090-000-072
ADD TO DUP
11-00-088-000-070

D.L. 89
D.L. 88

10.07

CORRECTING
06-01340-C
PARCEL ADDED
IN WRONG D.L.

~~0.77~~
A. ~~0.72~~

0.99
A. 0.70

413.60

339.90

135.62

SPLITS/DEEDS PROCESSED

LORAIN COUNTY TAX MAP DEPARTMENT
226 MIDDLE AVE. ELYRIA, OHIO

SURVEYED BY: STUART W. SAYLER
CLOSURE: 1:10,000
MAP PAGE(S): 11-00-088-A
APPROVED BY: DRH DATE: 8/30/2006
SCALE: 1"=100 PRIOR INSTRUMENT: 20000703966

