

MASTER




PARENT PARCEL: 11-00-083-000-008

CHILD PARCEL: 11-00-083-000-008 & -028

STARTING POINT: INT CL COUNTRY PL AND S DURKEE RD

06-01399-D

AC. CORR.
AND ADD TO DUP
PER DEEDS

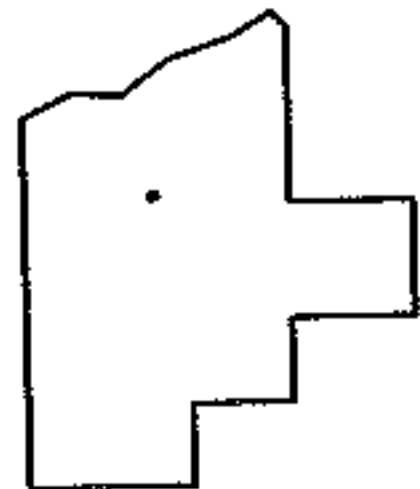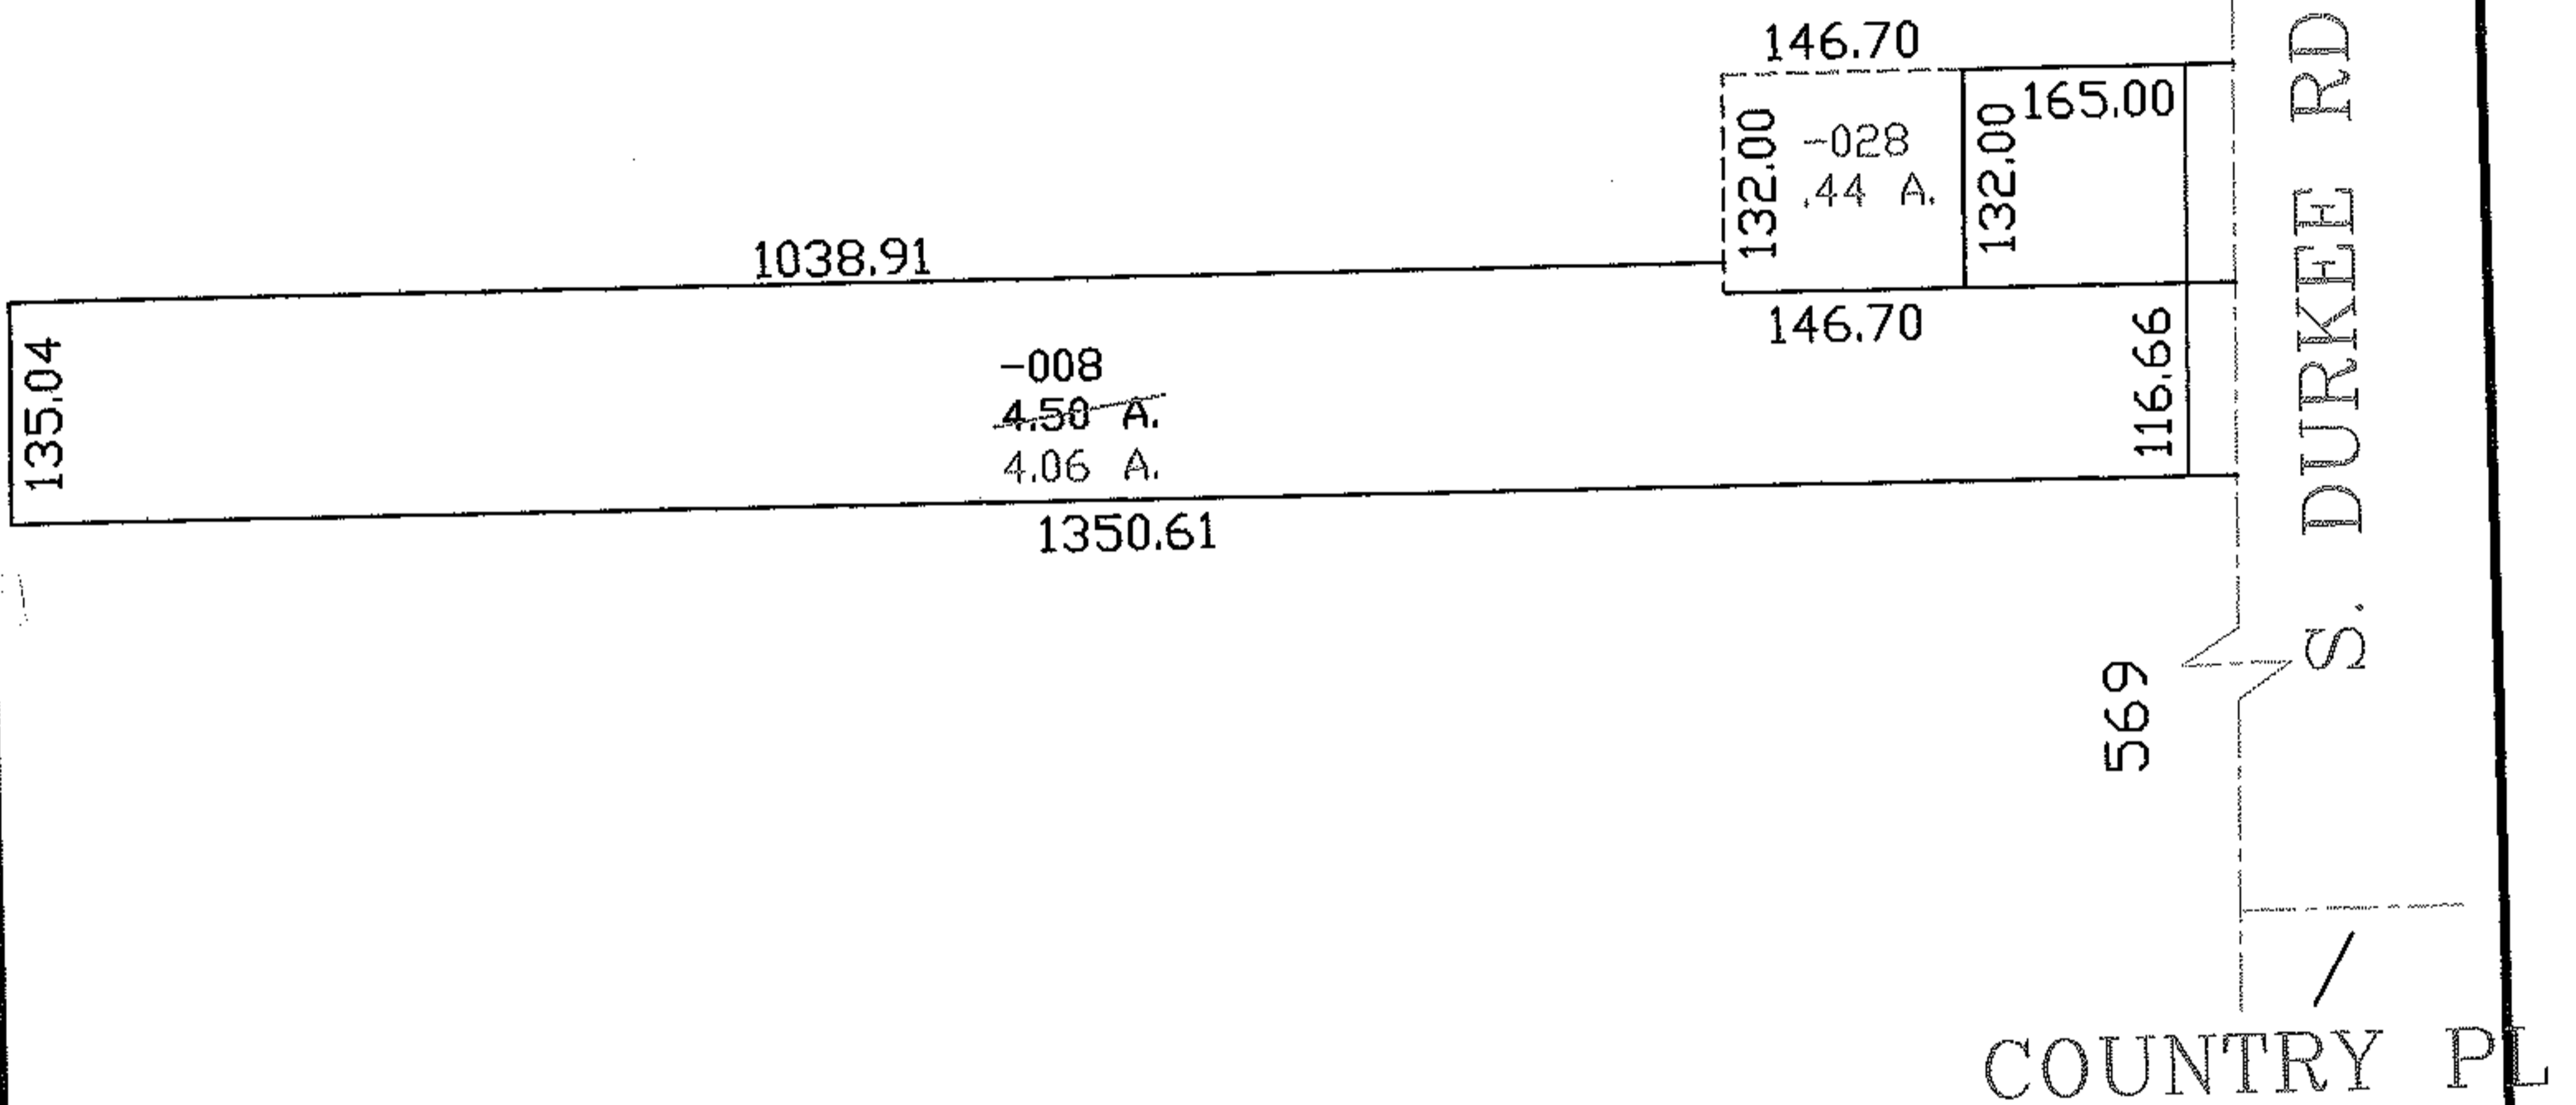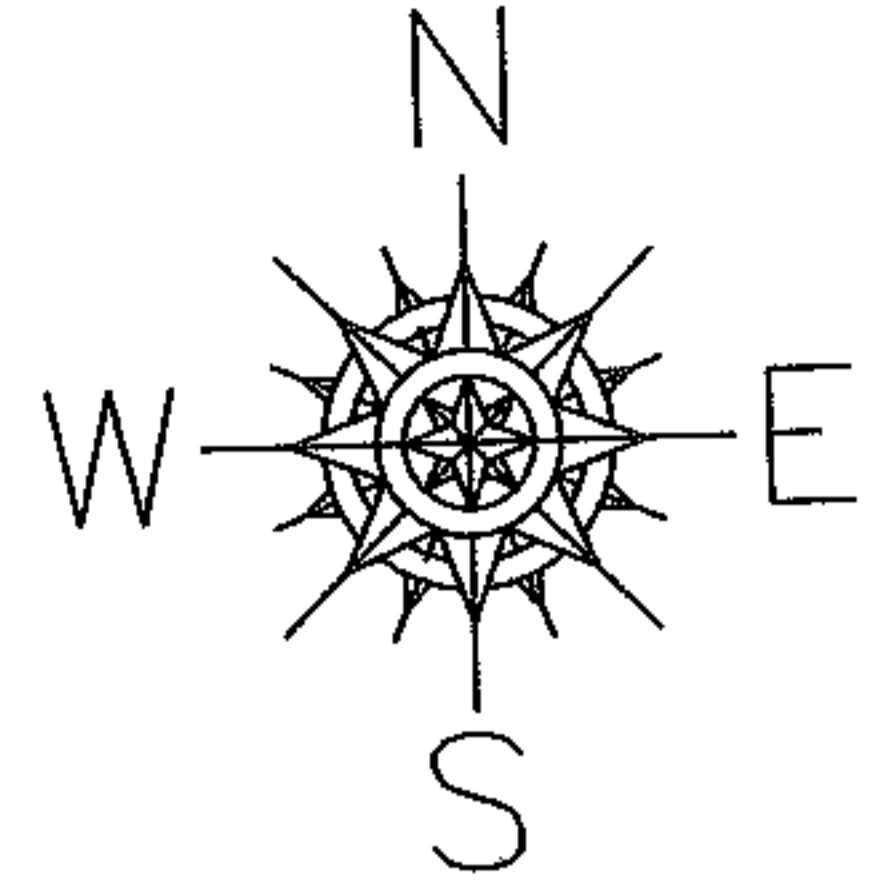

SPLITS/DEEDS PROCESSED
LORAIN COUNTY TAX MAP DEPARTMENT
226 MIDDLE AVE. ELYRIA, OHIO

SURVEYED BY: N/A
CLOSURE: N/A
MAP PAGE(S): 11-E SOUTH
APPROVED BY: DRH DATE: 9/13/2006
SCALE: 1" = 200' PRIOR INSTRUMENT: 20020839589