

RASTER



PARENT PARCEL: --ADD TO DUP--

06-01402-V

CHILD PARCEL: 07-00-009-104-031, 07-00-009-107-046

STARTING POINT: INT ROW OF NAGLE AND LINCOLN AVE

ADD TO DUP
PER ORD
3236-97

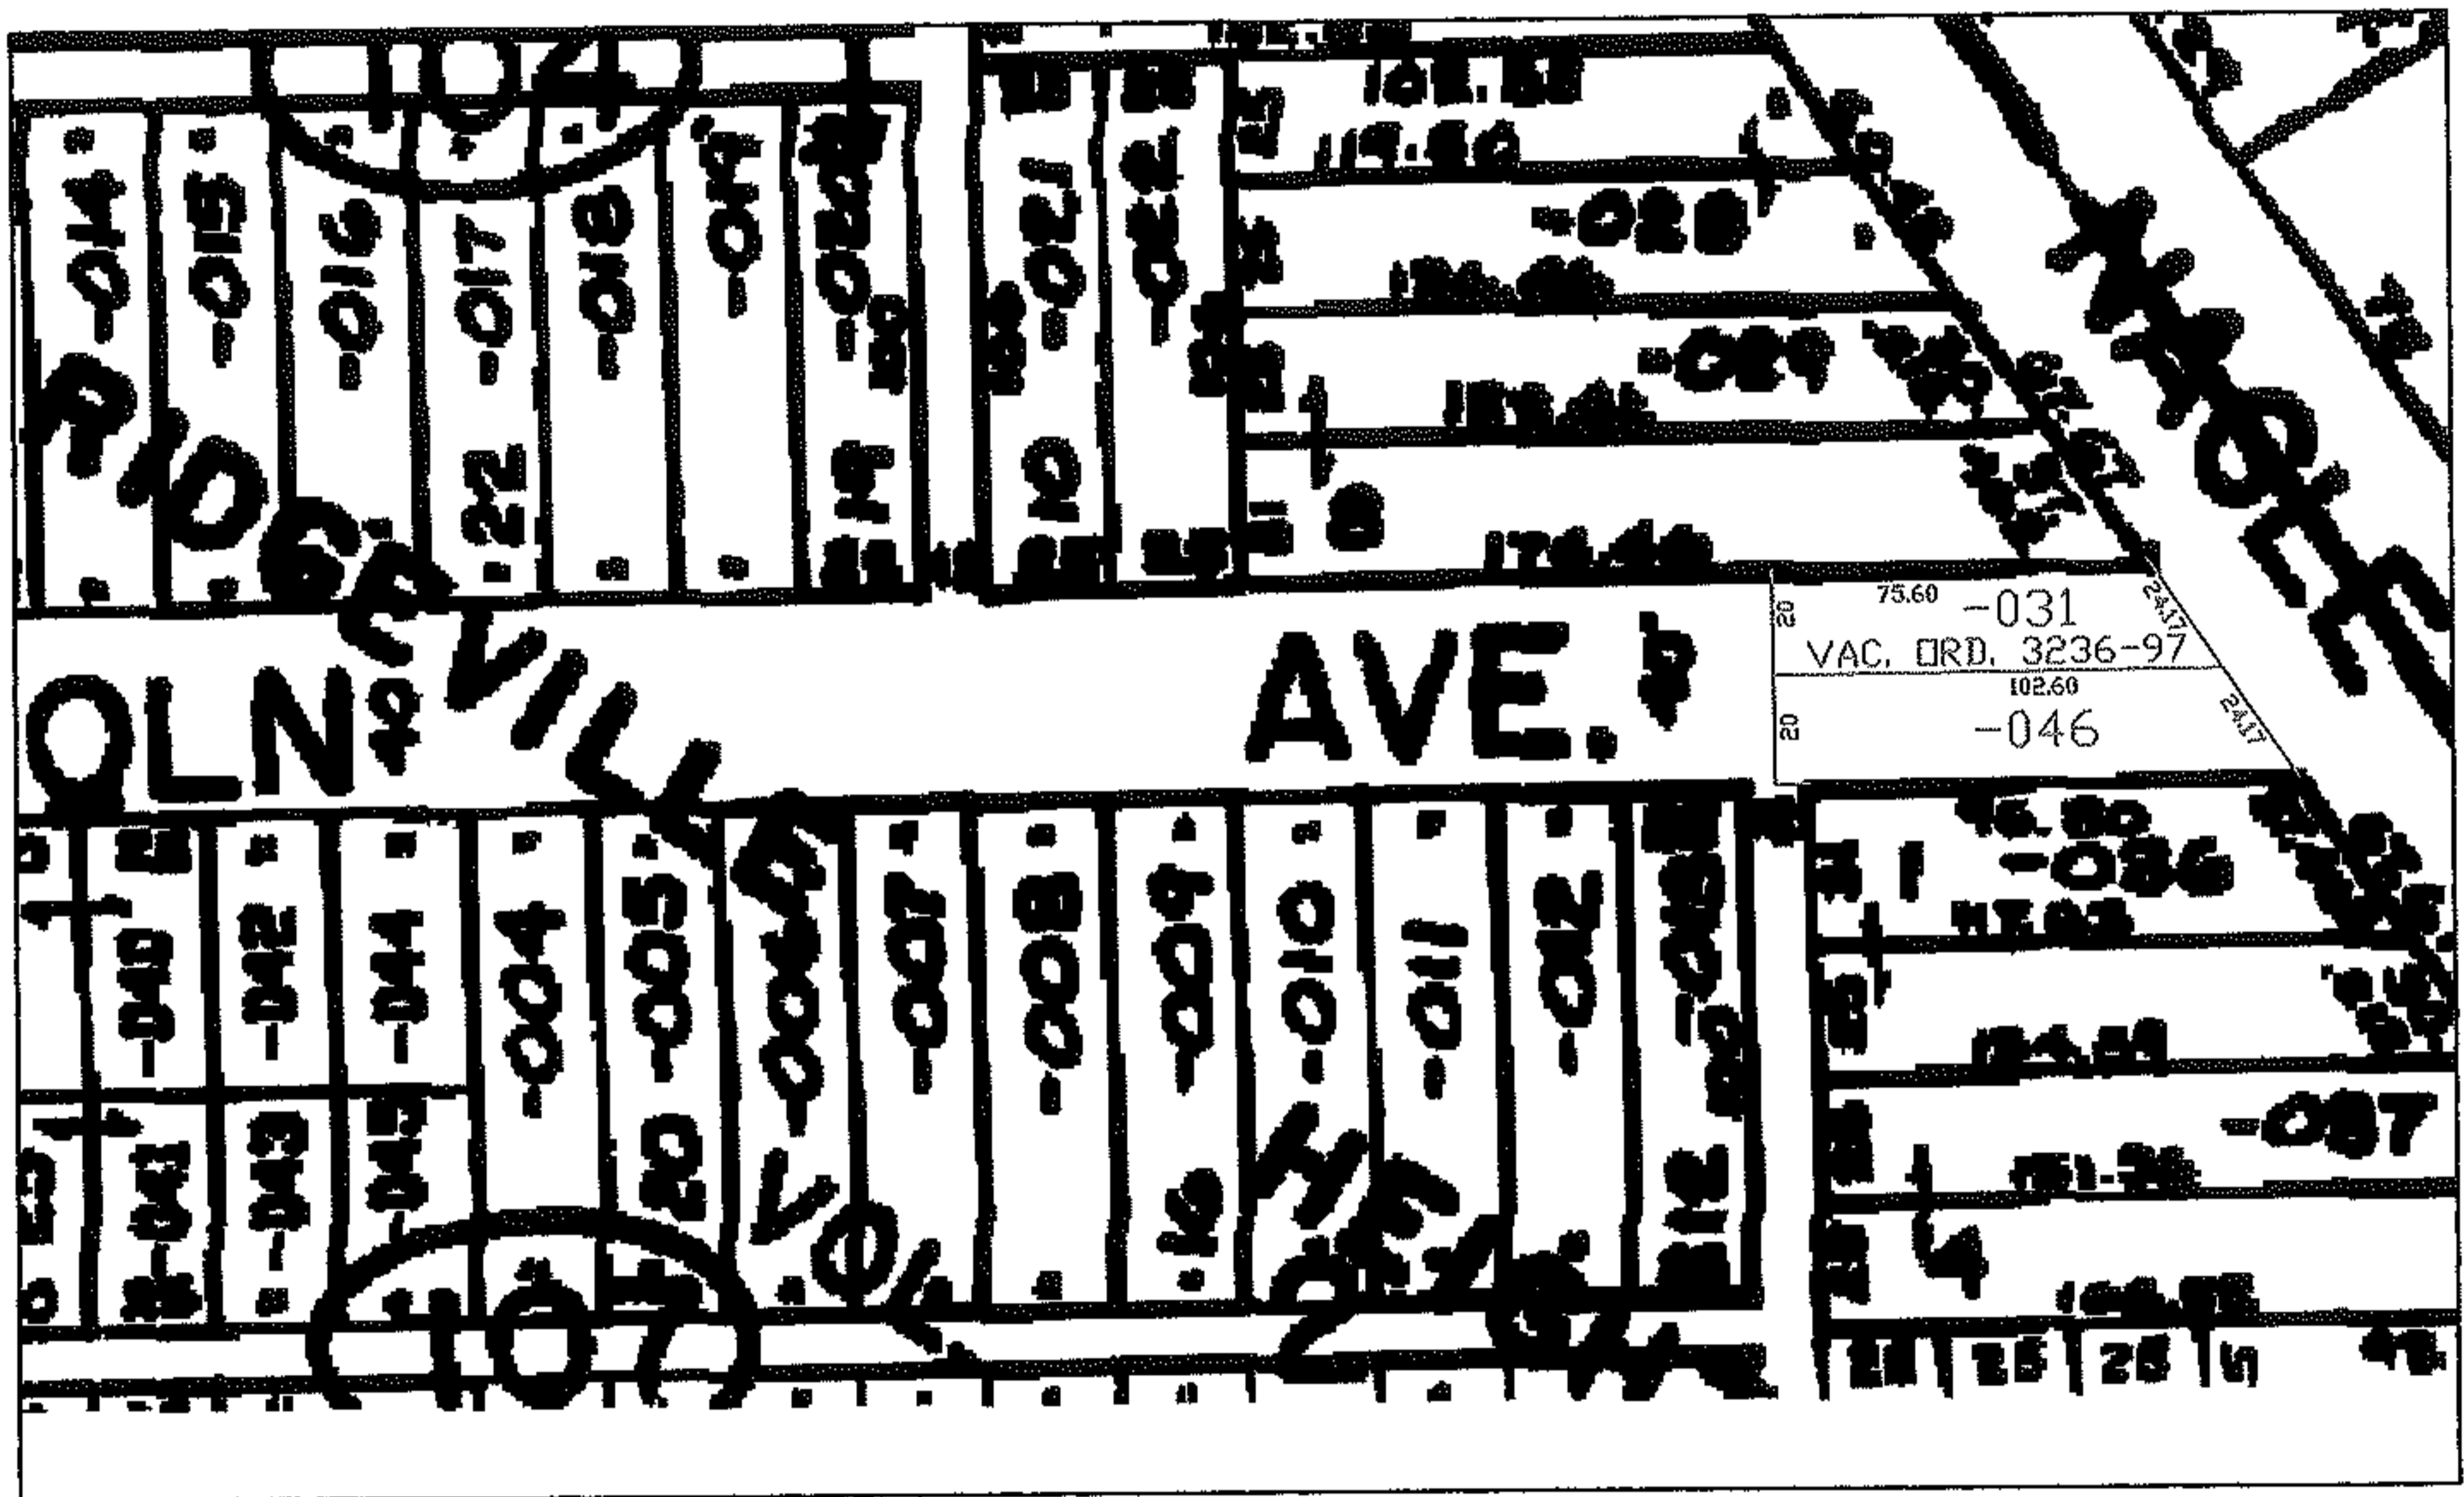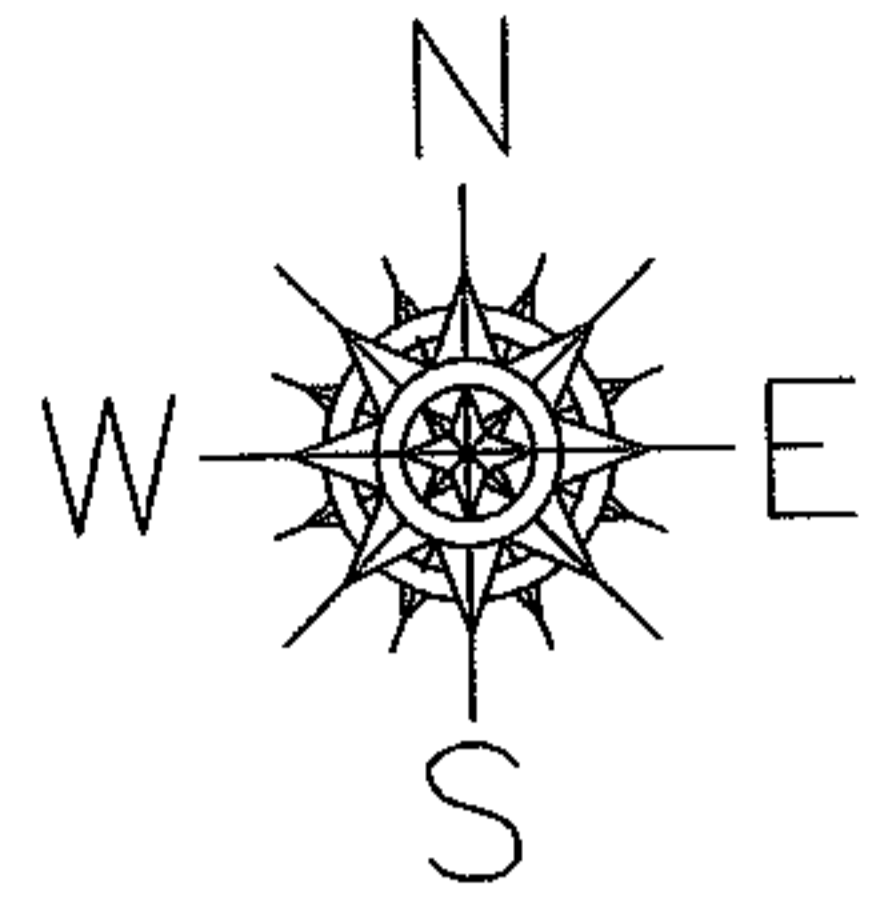

75.60 -031
VAC. ORD. 3236-97
102.60
20 -046
20

SPLITS/DEEDS PROCESSED

LORAIN COUNTY TAX MAP DEPARTMENT
226 MIDDLE AVE. ELYRIA, OHIO

SURVEYED BY: N/A

CLOSURE: N/A

MAP PAGE(S): 07-00-009-B

APPROVED BY: DRH DATE: 2/27/2007

SCALE: 1" = 100' PRIOR INSTRUMENT: ord 3236-97