


PARENT PARCEL: 07-00-033-000-099, & -100
CHILD PARCEL: 07-00-033-000-203 THRU -208
STARTING POINT: XXXXXX

NO. 06-01409-U

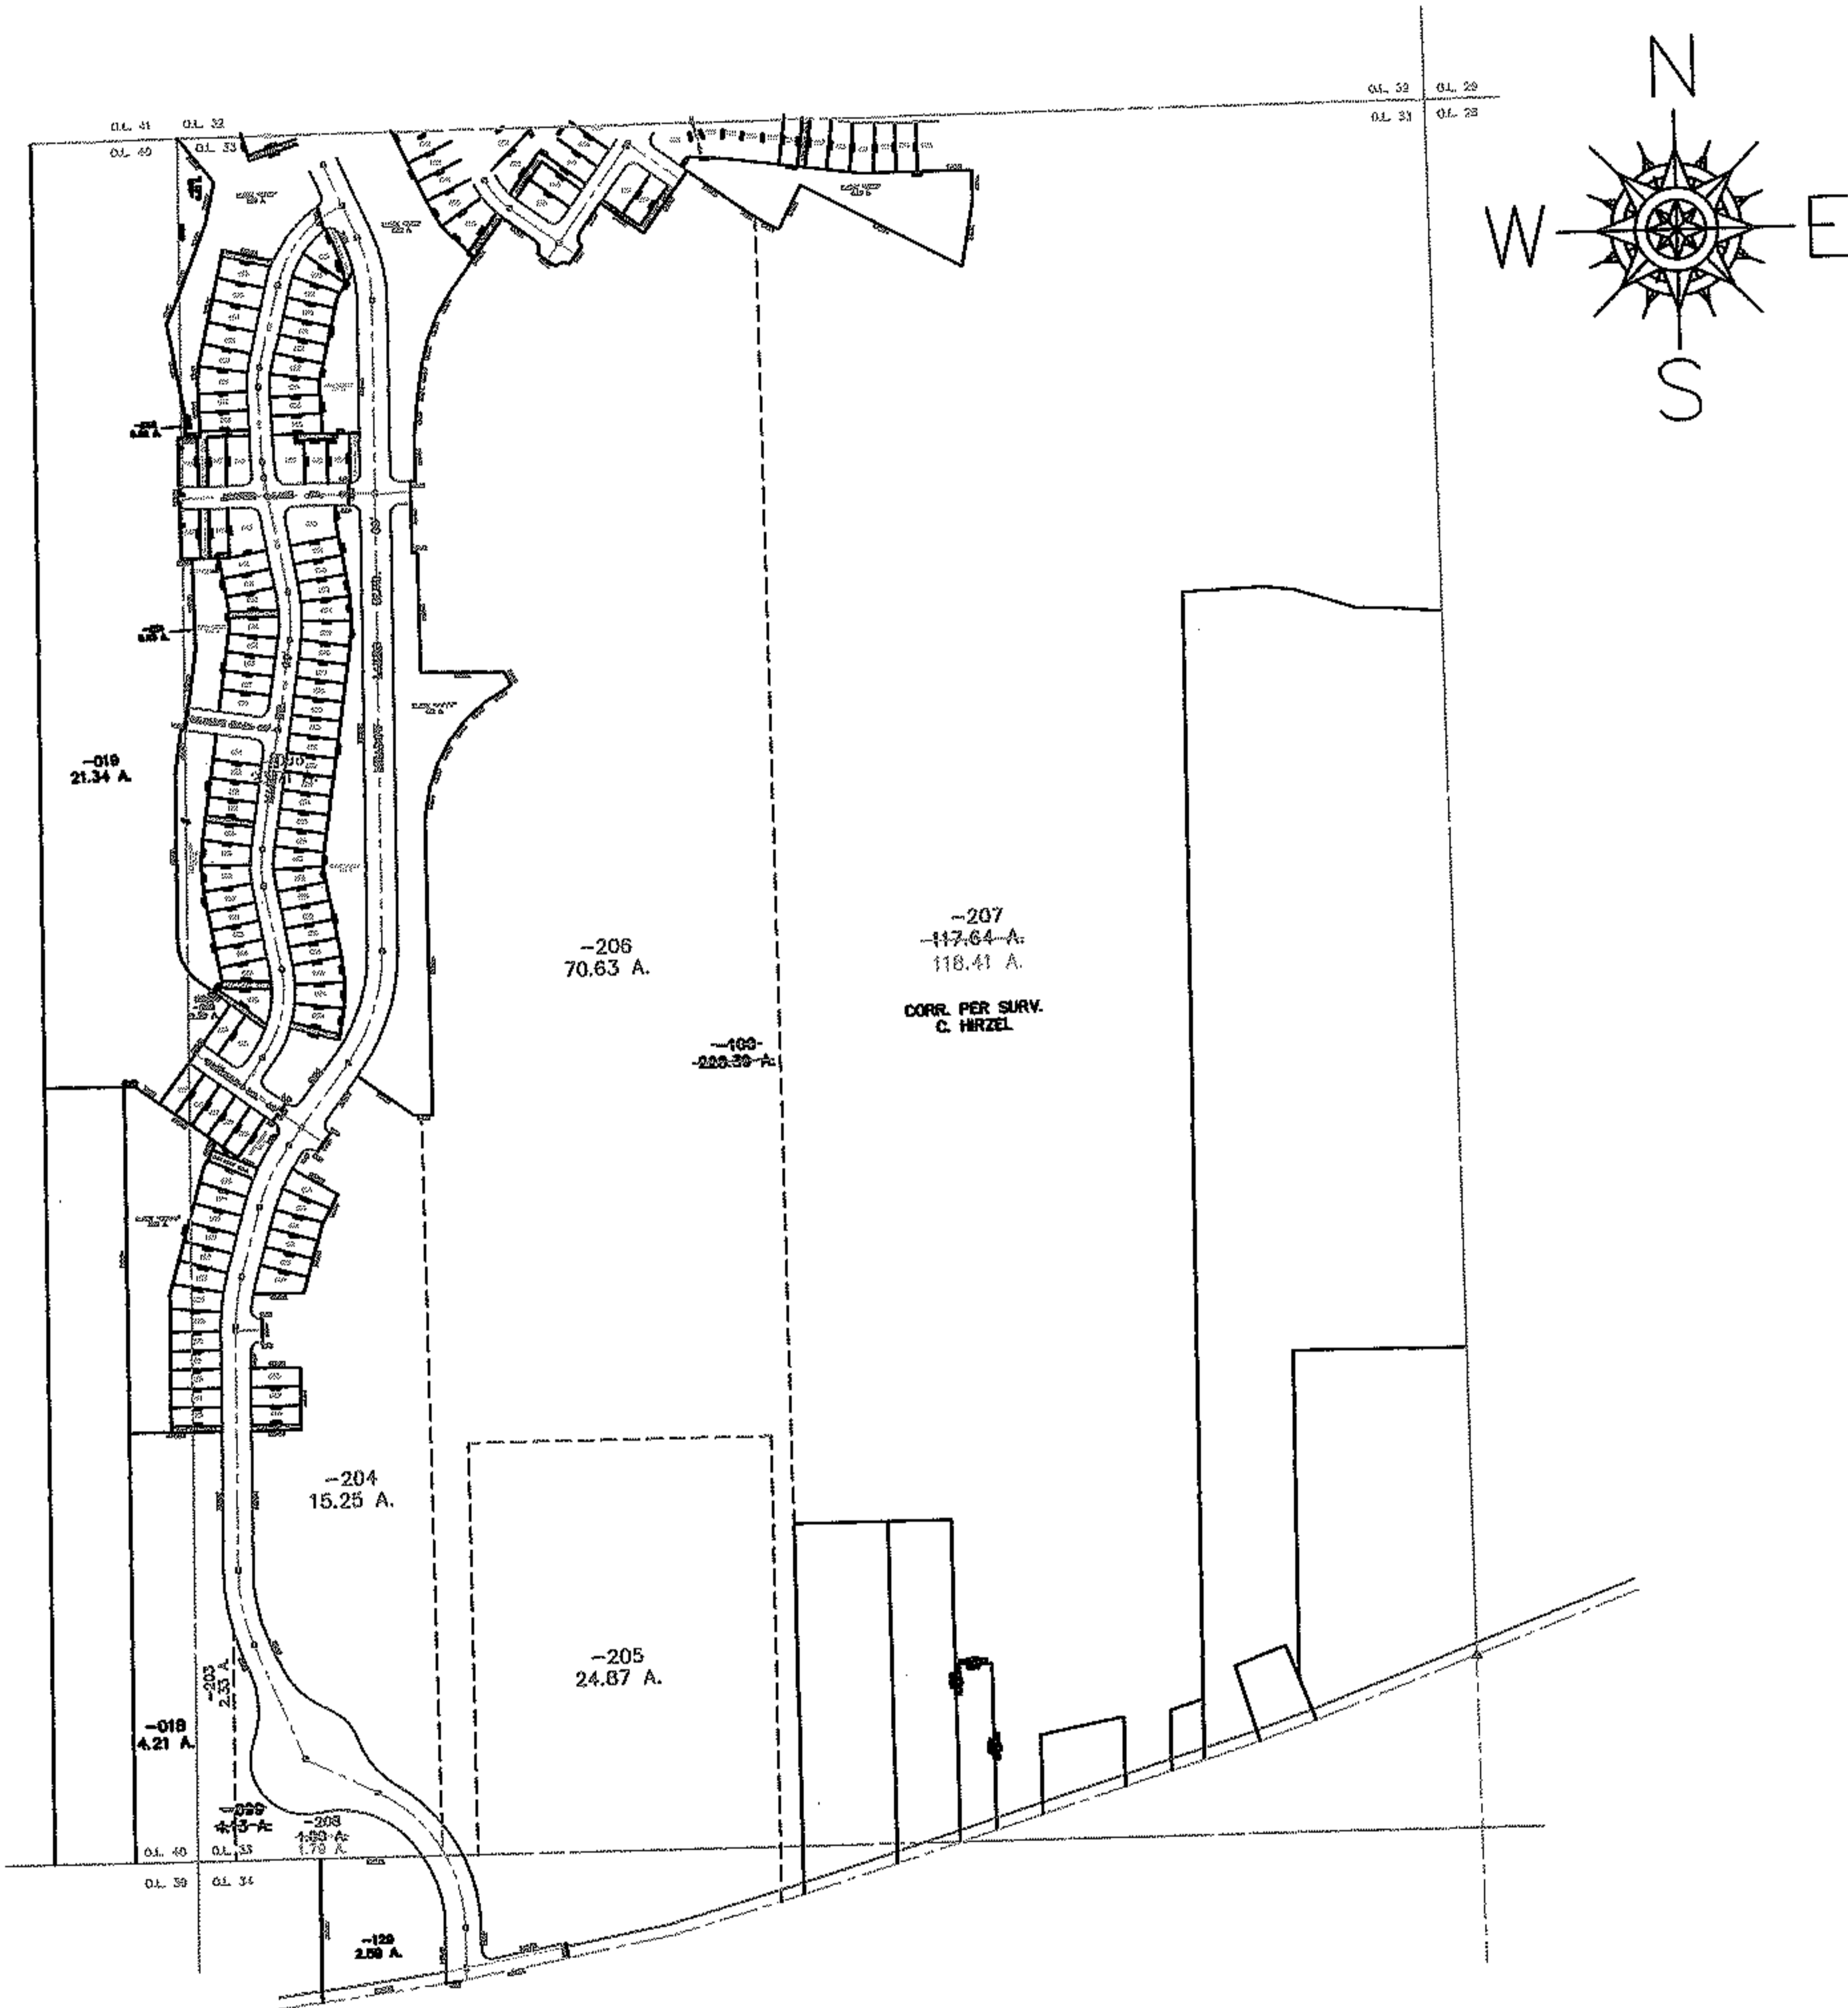

SPLITS/DEEDS PROCESSED

LORAIN COUNTY TAX MAP DEPARTMENT
226 MIDDLE AVE. ELYRIA, OHIO

SURVEYED BY: CHRIS HIRZEL
CLOSURE: 0.01 : 10,000
MAP PAGE(S): 07-00-033-C
APPROVED BY: TJS DATE: 11/8/06
SCALE: 1" = 100 PRIOR INSTRUMENT: PV 88/77