

RASTER




PARENT PARCEL: 18-00-029-000-023

CHILD PARCEL: --NONE--

STARTING POINT: C.L. S.R. 58 AND NORTH LINE OF WELLINGTON VILLAGE

06-01412-C

DROP FROM DUPLICATE

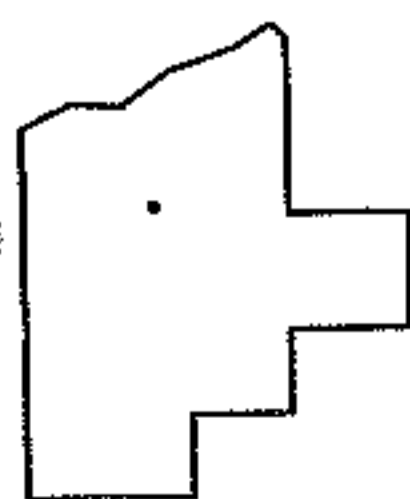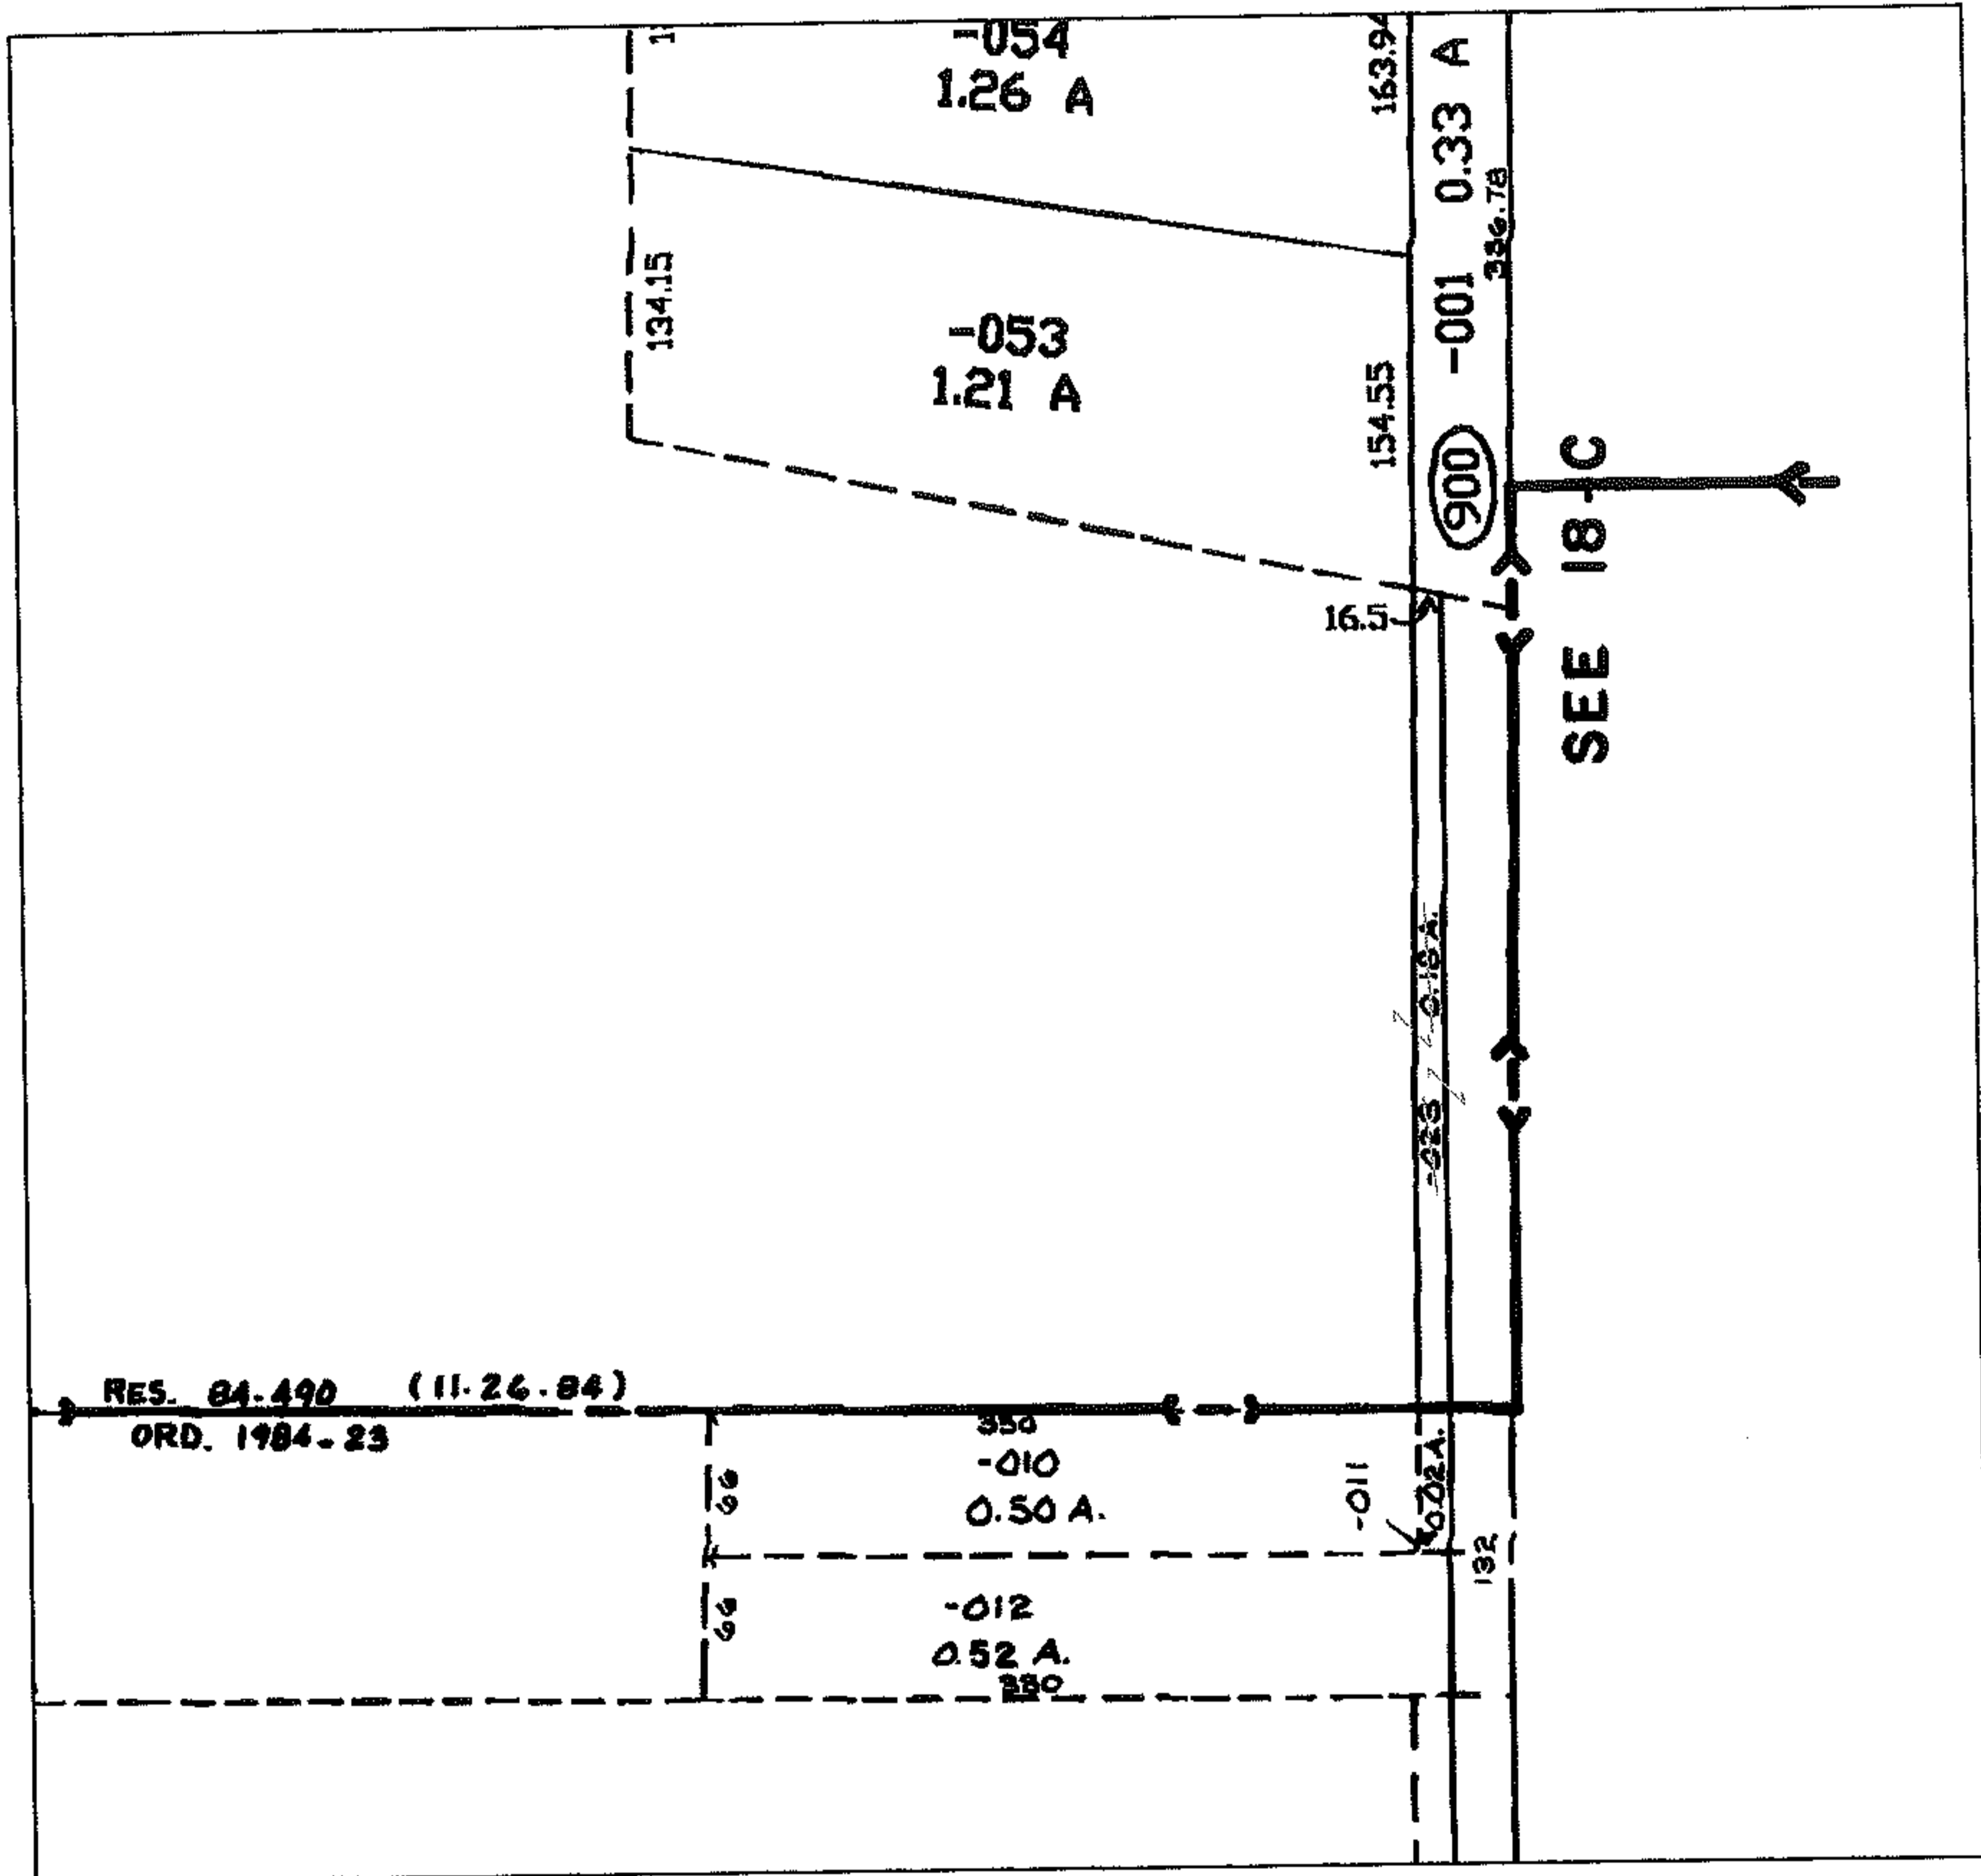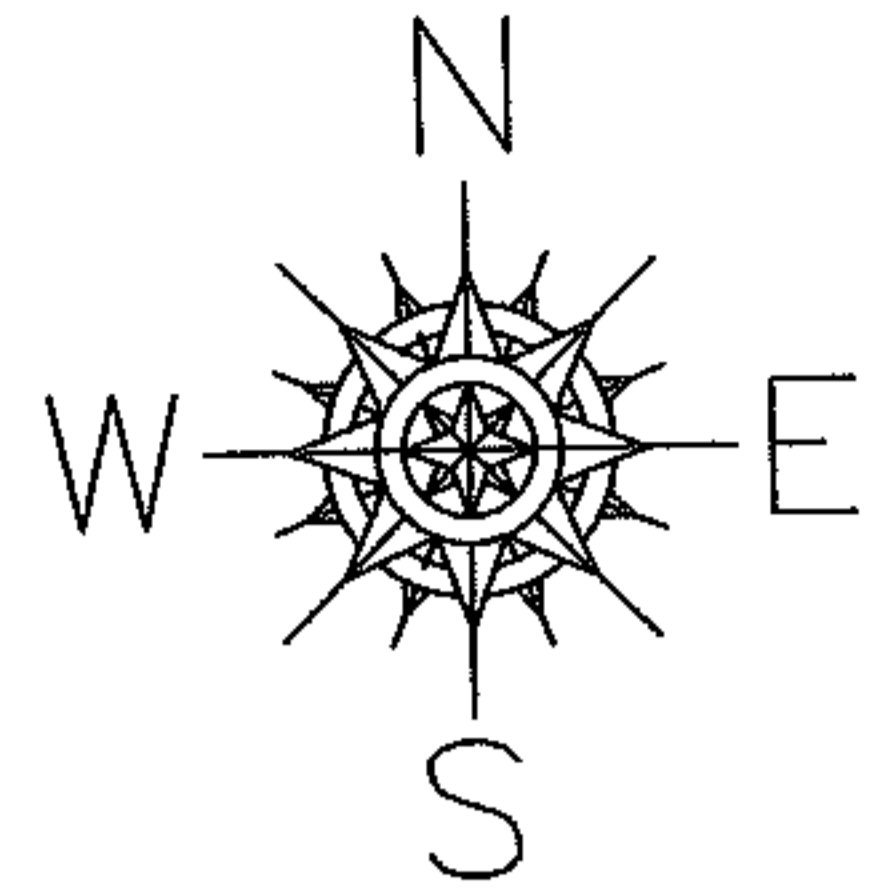

SPLITS/DEEDS PROCESSED
 LORAIN COUNTY TAX MAP DEPARTMENT
 226 MIDDLE AVE. ELYRIA, OHIO

SURVEYED BY: N/A
 CLOSURE: N/A
 MAP PAGE(S): 18-00-029-D
 APPROVED BY: DRH DATE: 12/19/2006
 SCALE: 1" = 200' PRIOR INSTRUMENT: