



PARENT PARCEL: 07-00-033-000-013

CHILD PARCEL: --SAME--

STARTING POINT: REMAINDER "D" FROM MEADOW LAKES SUB NO 8

06-01413-C

CERTIFICATE OF CORRECTION

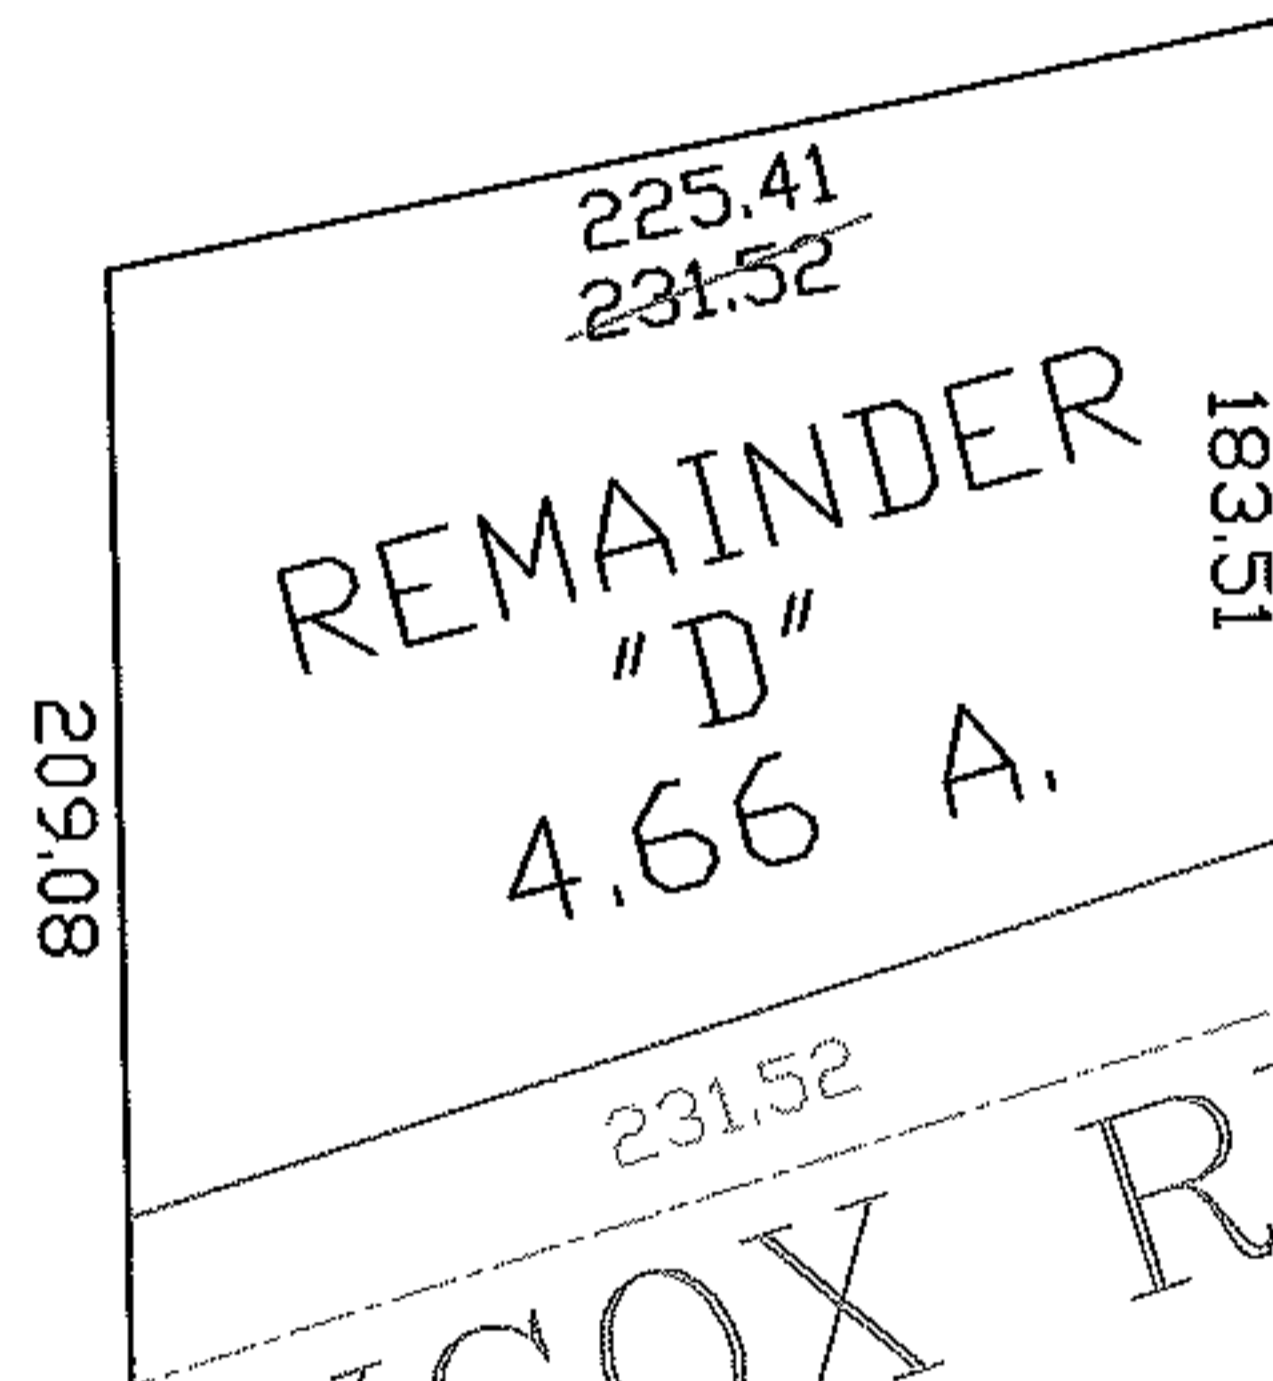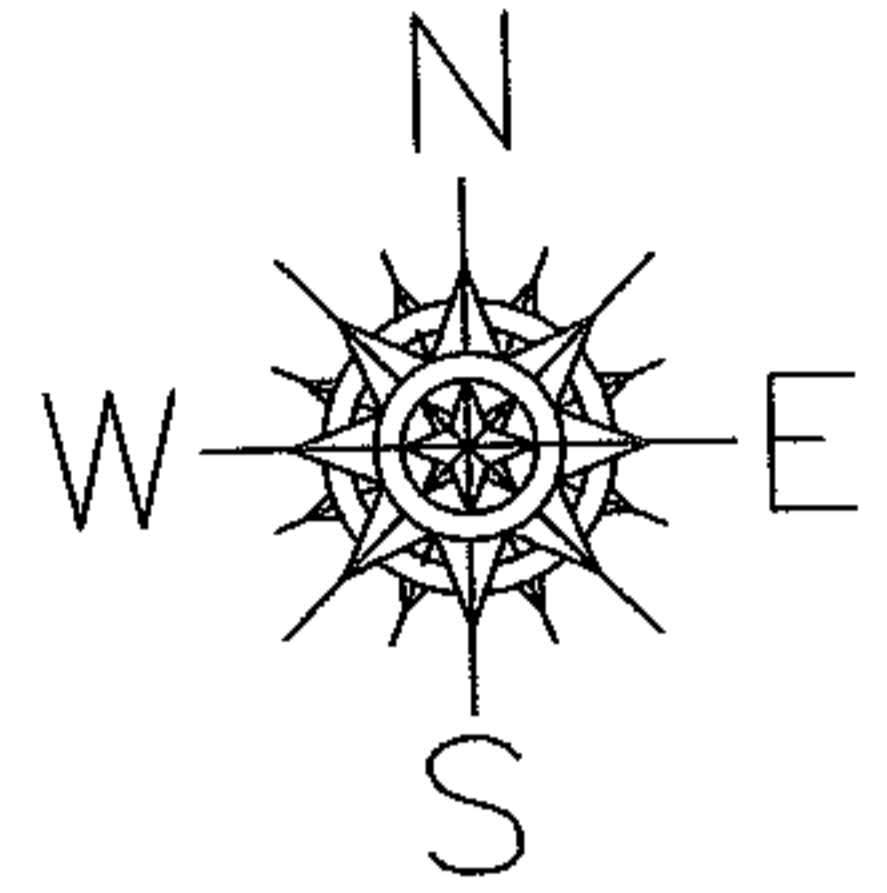

D.L. 33
D.L. 34

JAYCOX RD

SPLITS/DEEDS PROCESSED

LORAIN COUNTY TAX MAP DEPARTMENT
226 MIDDLE AVE. ELYRIA, OHIO

SURVEYED BY: CHRISTOPHER M. HIRZEL

CLOSURE: 1:10,000

MAP PAGE(S): V88/76-83

APPROVED BY: DRH DATE: 11/20/2006

SCALE: 1" = 100 PRIOR INSTRUMENT: