

RASTER


PARENT PARCEL: 21-05-020-000-009, 21-05-021-000-004

06-01419-C


CHILD PARCEL: --SAME--

STARTING POINT: INT CL GRIGGS ROAD WEST AND CL OF CLARK RD

GRIGGS RD.

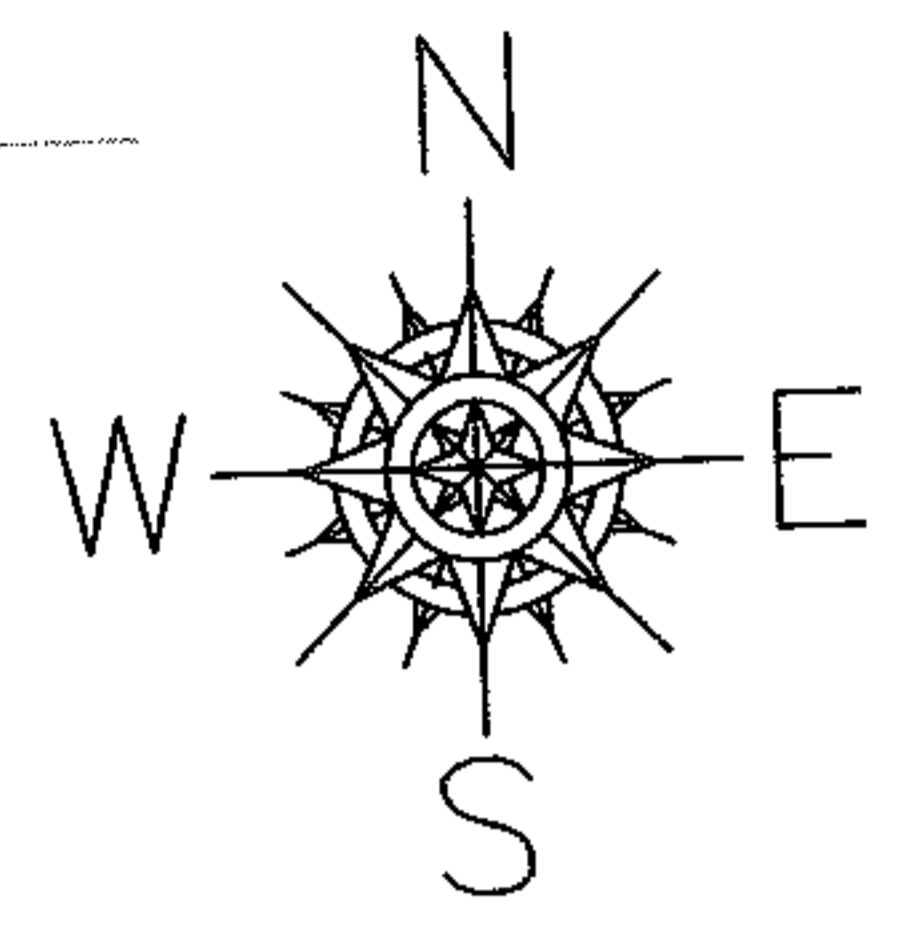

1858.59
RD.

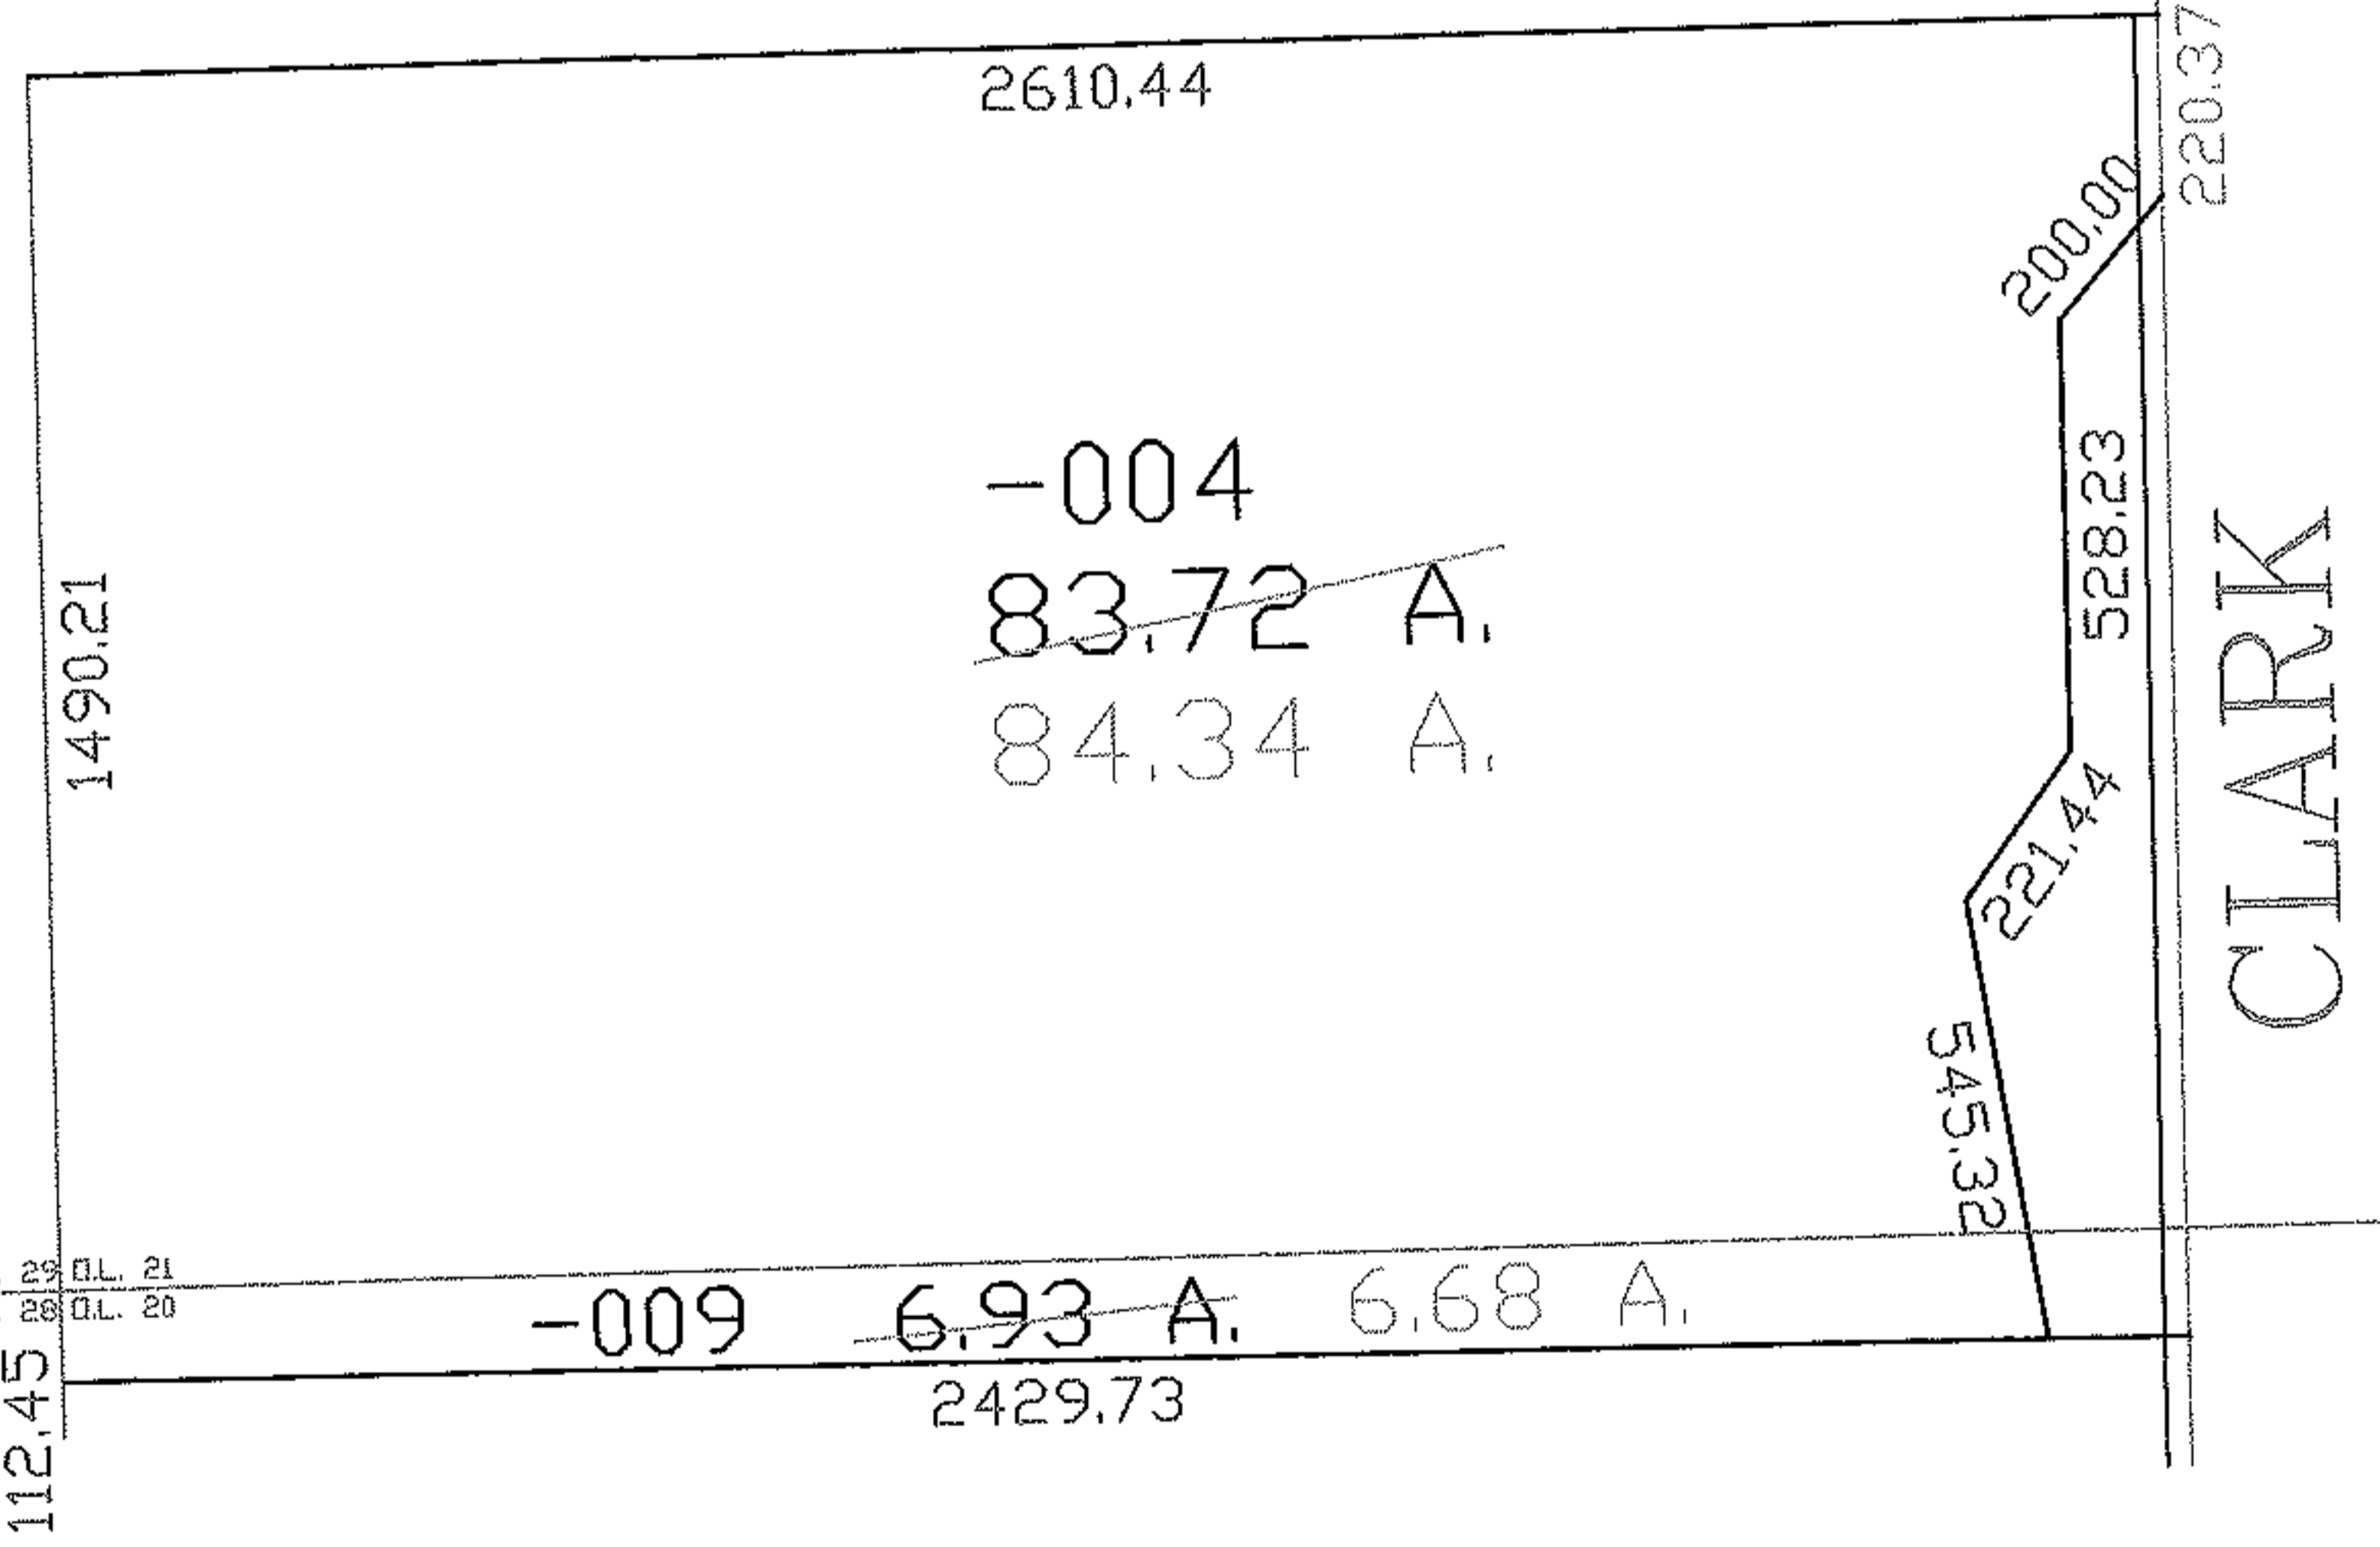

SPLITS/DEEDS PROCESSED

LORAIN COUNTY TAX MAP DEPARTMENT
226 MIDDLE AVE. ELYRIA, OHIO

SURVEYED BY: THOMAS M. SNEZEK

CLOSURE: 1:10,000

MAP PAGE(S): 21-A

APPROVED BY: DRH DATE: 10/30/2006

SCALE: 1" = 500 PRIOR INSTRUMENT: 2006071375