

PARENT PARCEL: 11-00-009-102-030

CHILD PARCEL: --SAME--

STARTING POINT: S.L. 109 IN DROSD & RISMAN

06-01431-D

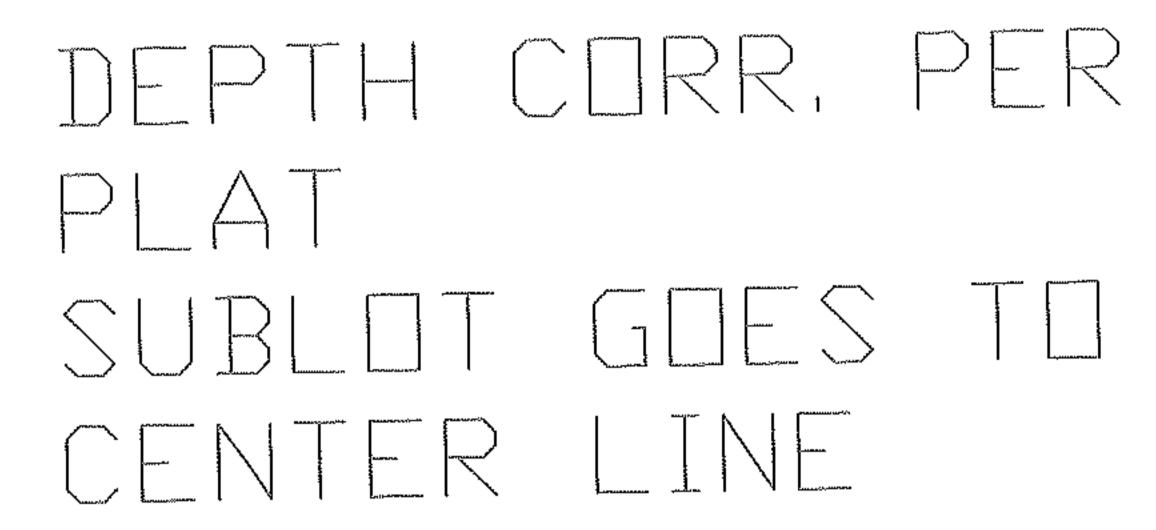

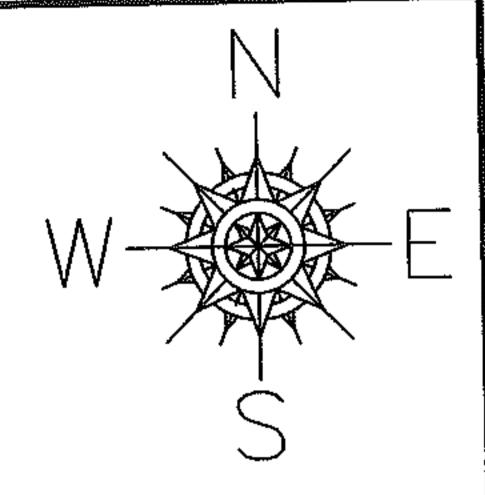

		····		· · · · · · · · · · · · · · · · · · ·				ia
D-D	25865 BROKAW RD					RD.	•	
227	028	029	- OSO	86	108	45 -03/	\$0 \$5	30
٠ ا		- 0	275	8	27	-032	BC	
			A CO	*	106	- <i>0</i> 33	,	WKE R
36	13	-062	063	*	105	-064 2 45	***	
, 0,	-06/	,	1 .	9	104	-065	90	SEE

SPLITS/DEEDS PROCESSED

LORAIN COUNTY TAX MAP DEPARTMENT 226 MIDDLE AVE. ELYRIA, OHIO