


RASTER

PARENT PARCEL: 14-00-030-000-038



06-01432-C

CHILD PARCEL: --SAME--

STARTING POINT: INT CL QUARRY RD AND NE CORNER OF O.L. 30

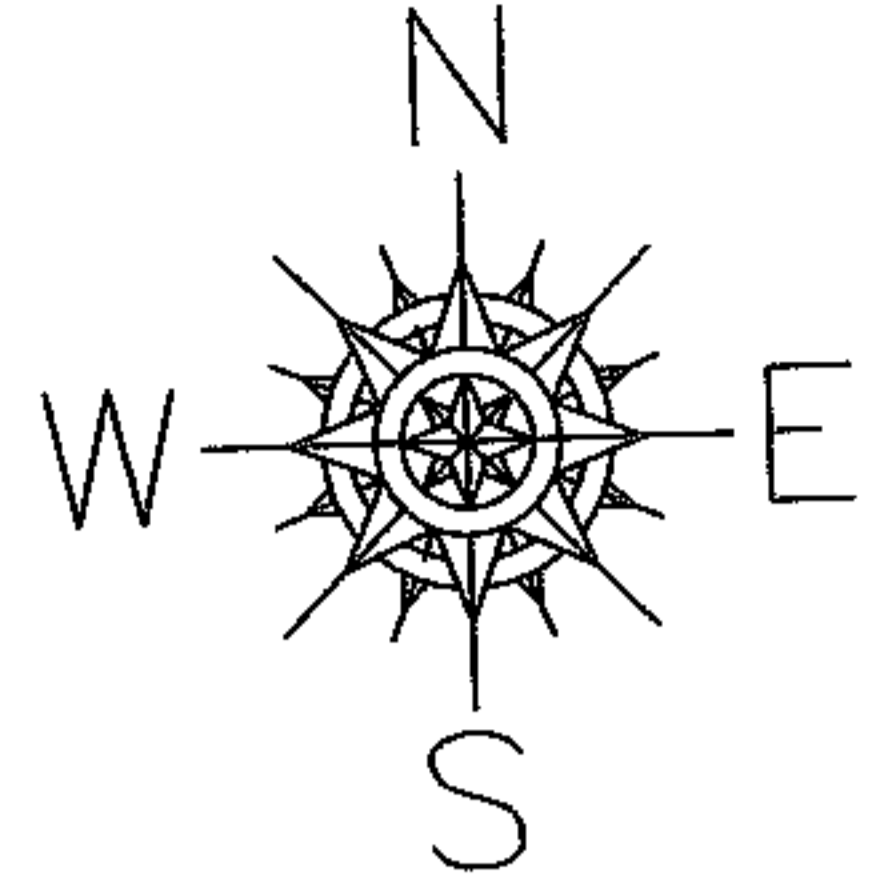

AC. CORR.
PER SURVEY
DALE HAYWOOD

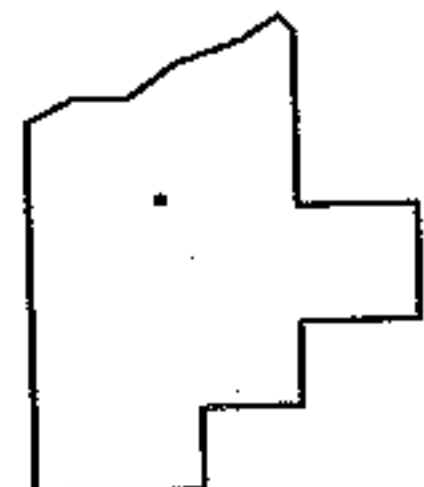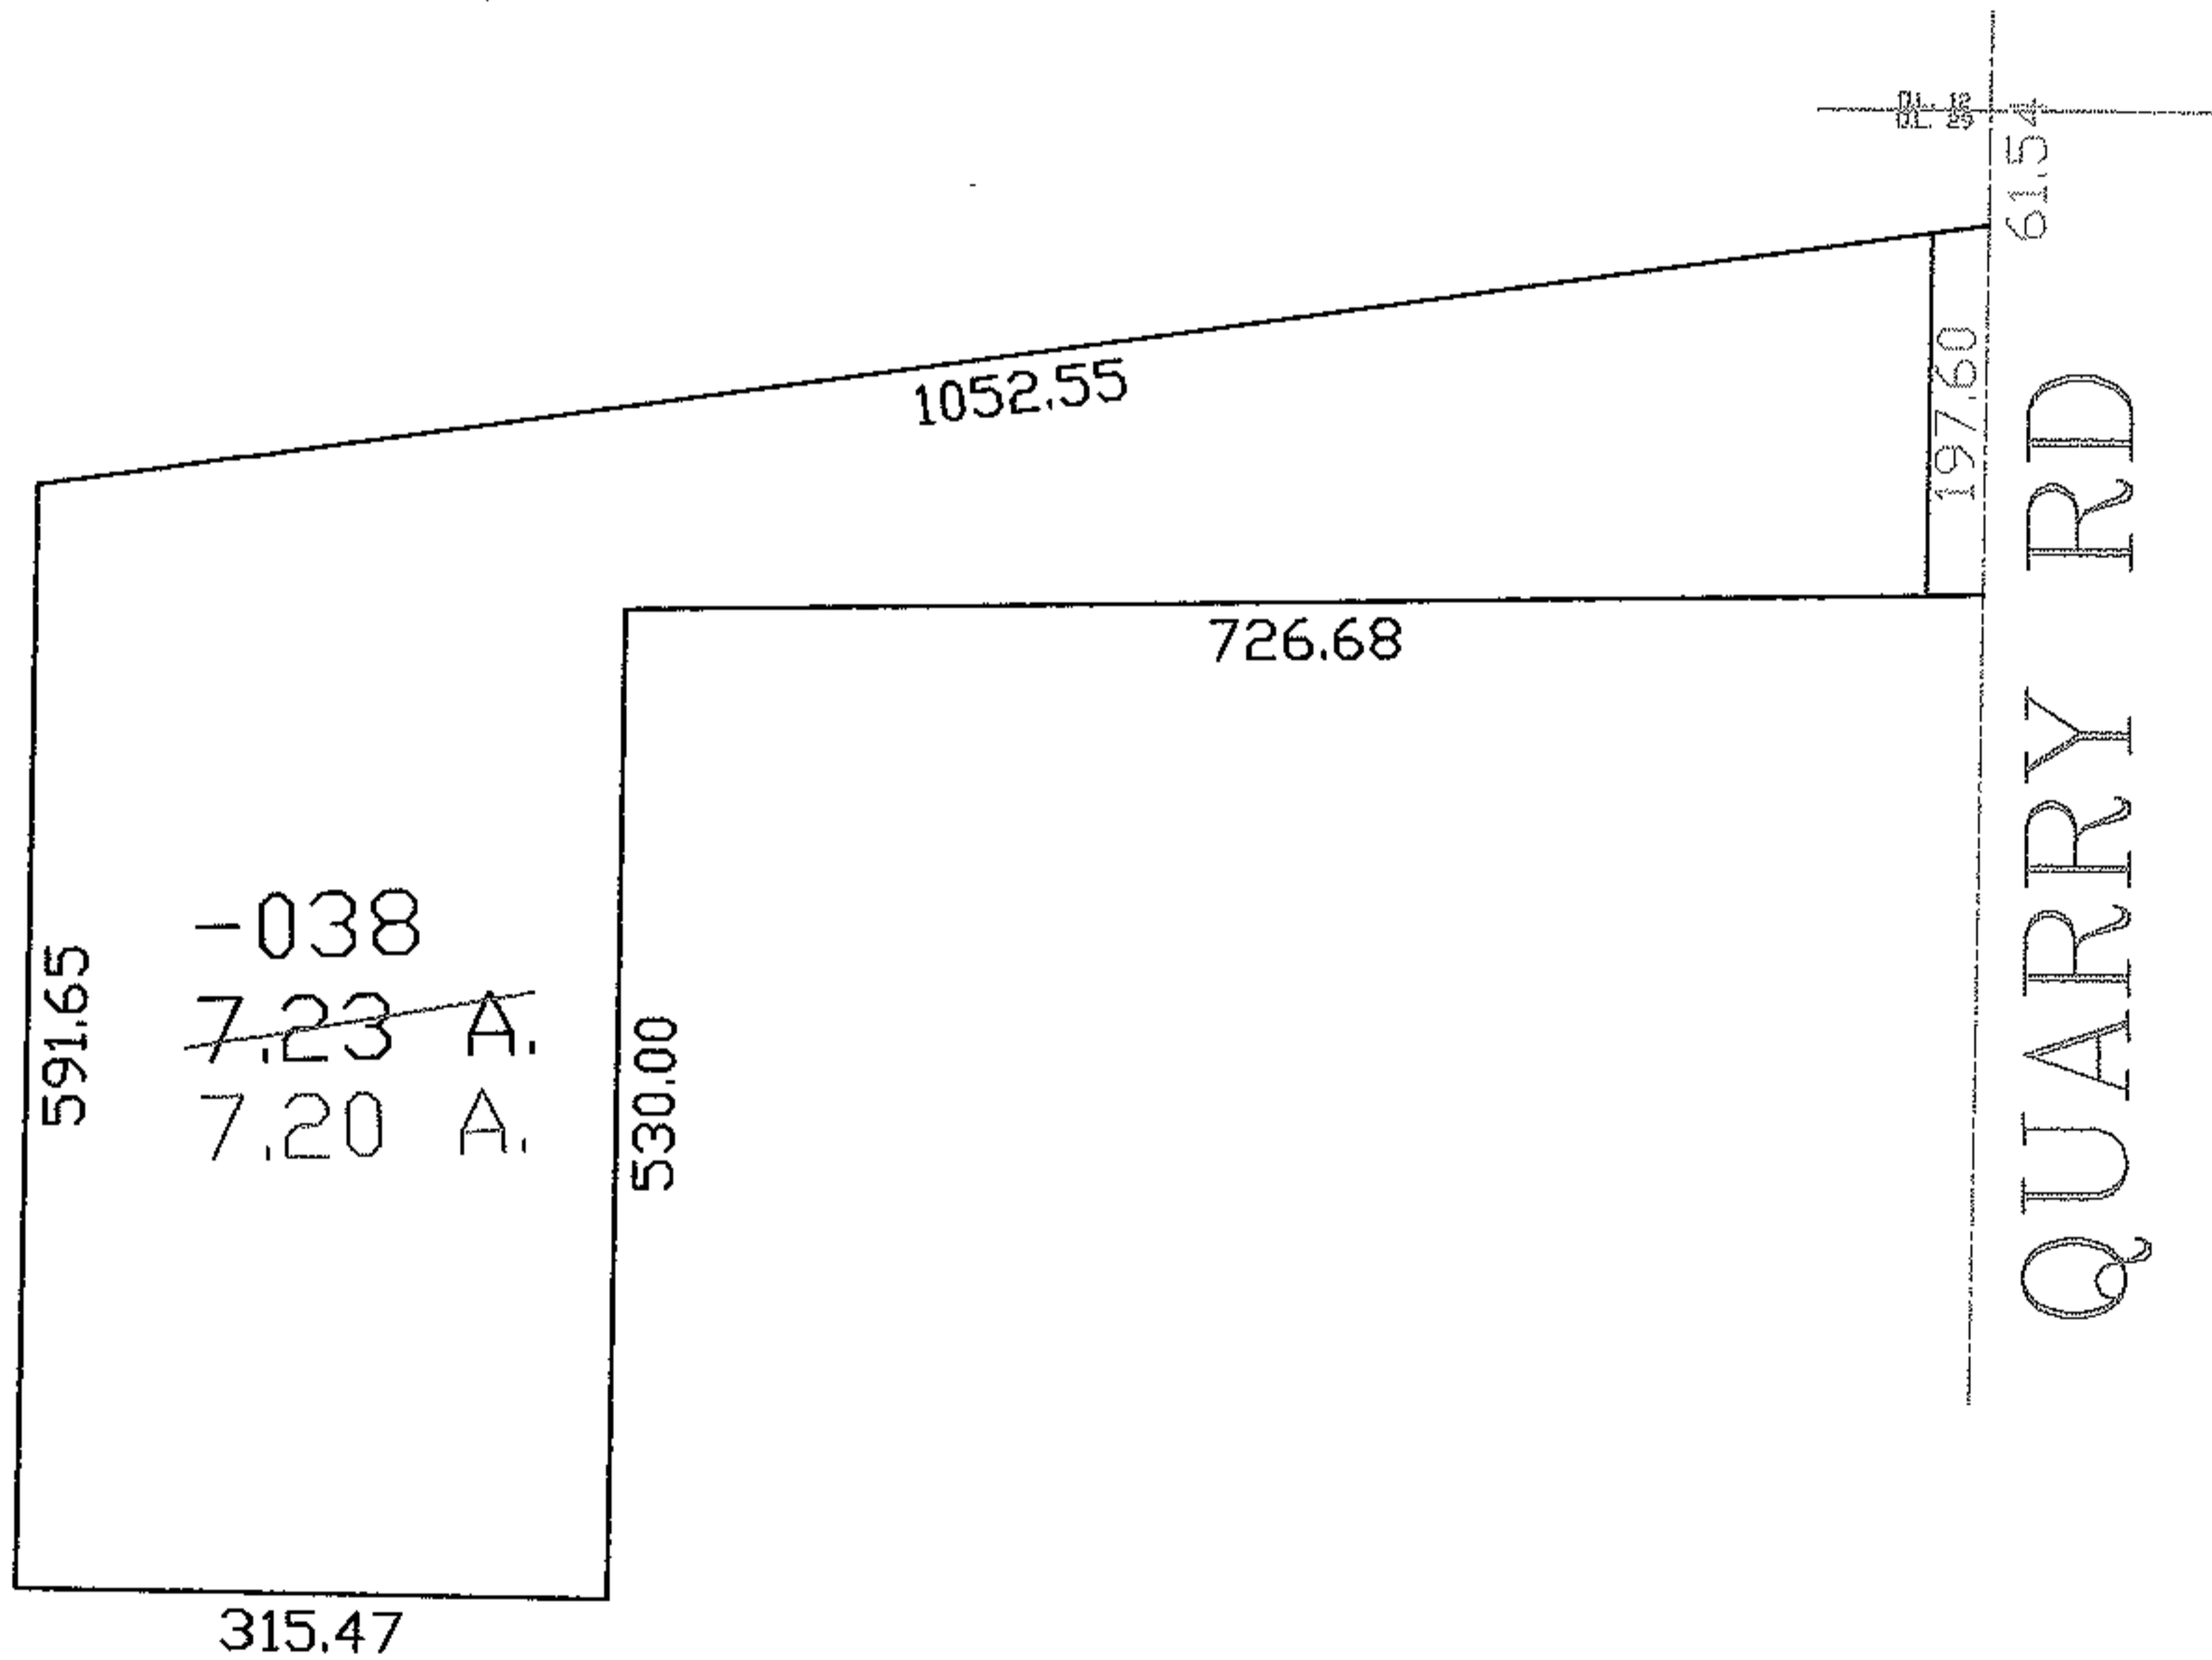

SPLITS/DEEDS PROCESSED
LORAIN COUNTY TAX MAP DEPARTMENT
226 MIDDLE AVE. ELYRIA, OHIO

SURVEYED BY: DALE HAYWOOD
CLOSURE: 1:10,000
MAP PAGE(S): 14-A
APPROVED BY: DRH DATE: 12/4/2006
SCALE: 1" = 200 PRIOR INSTRUMENT: 20020862595