
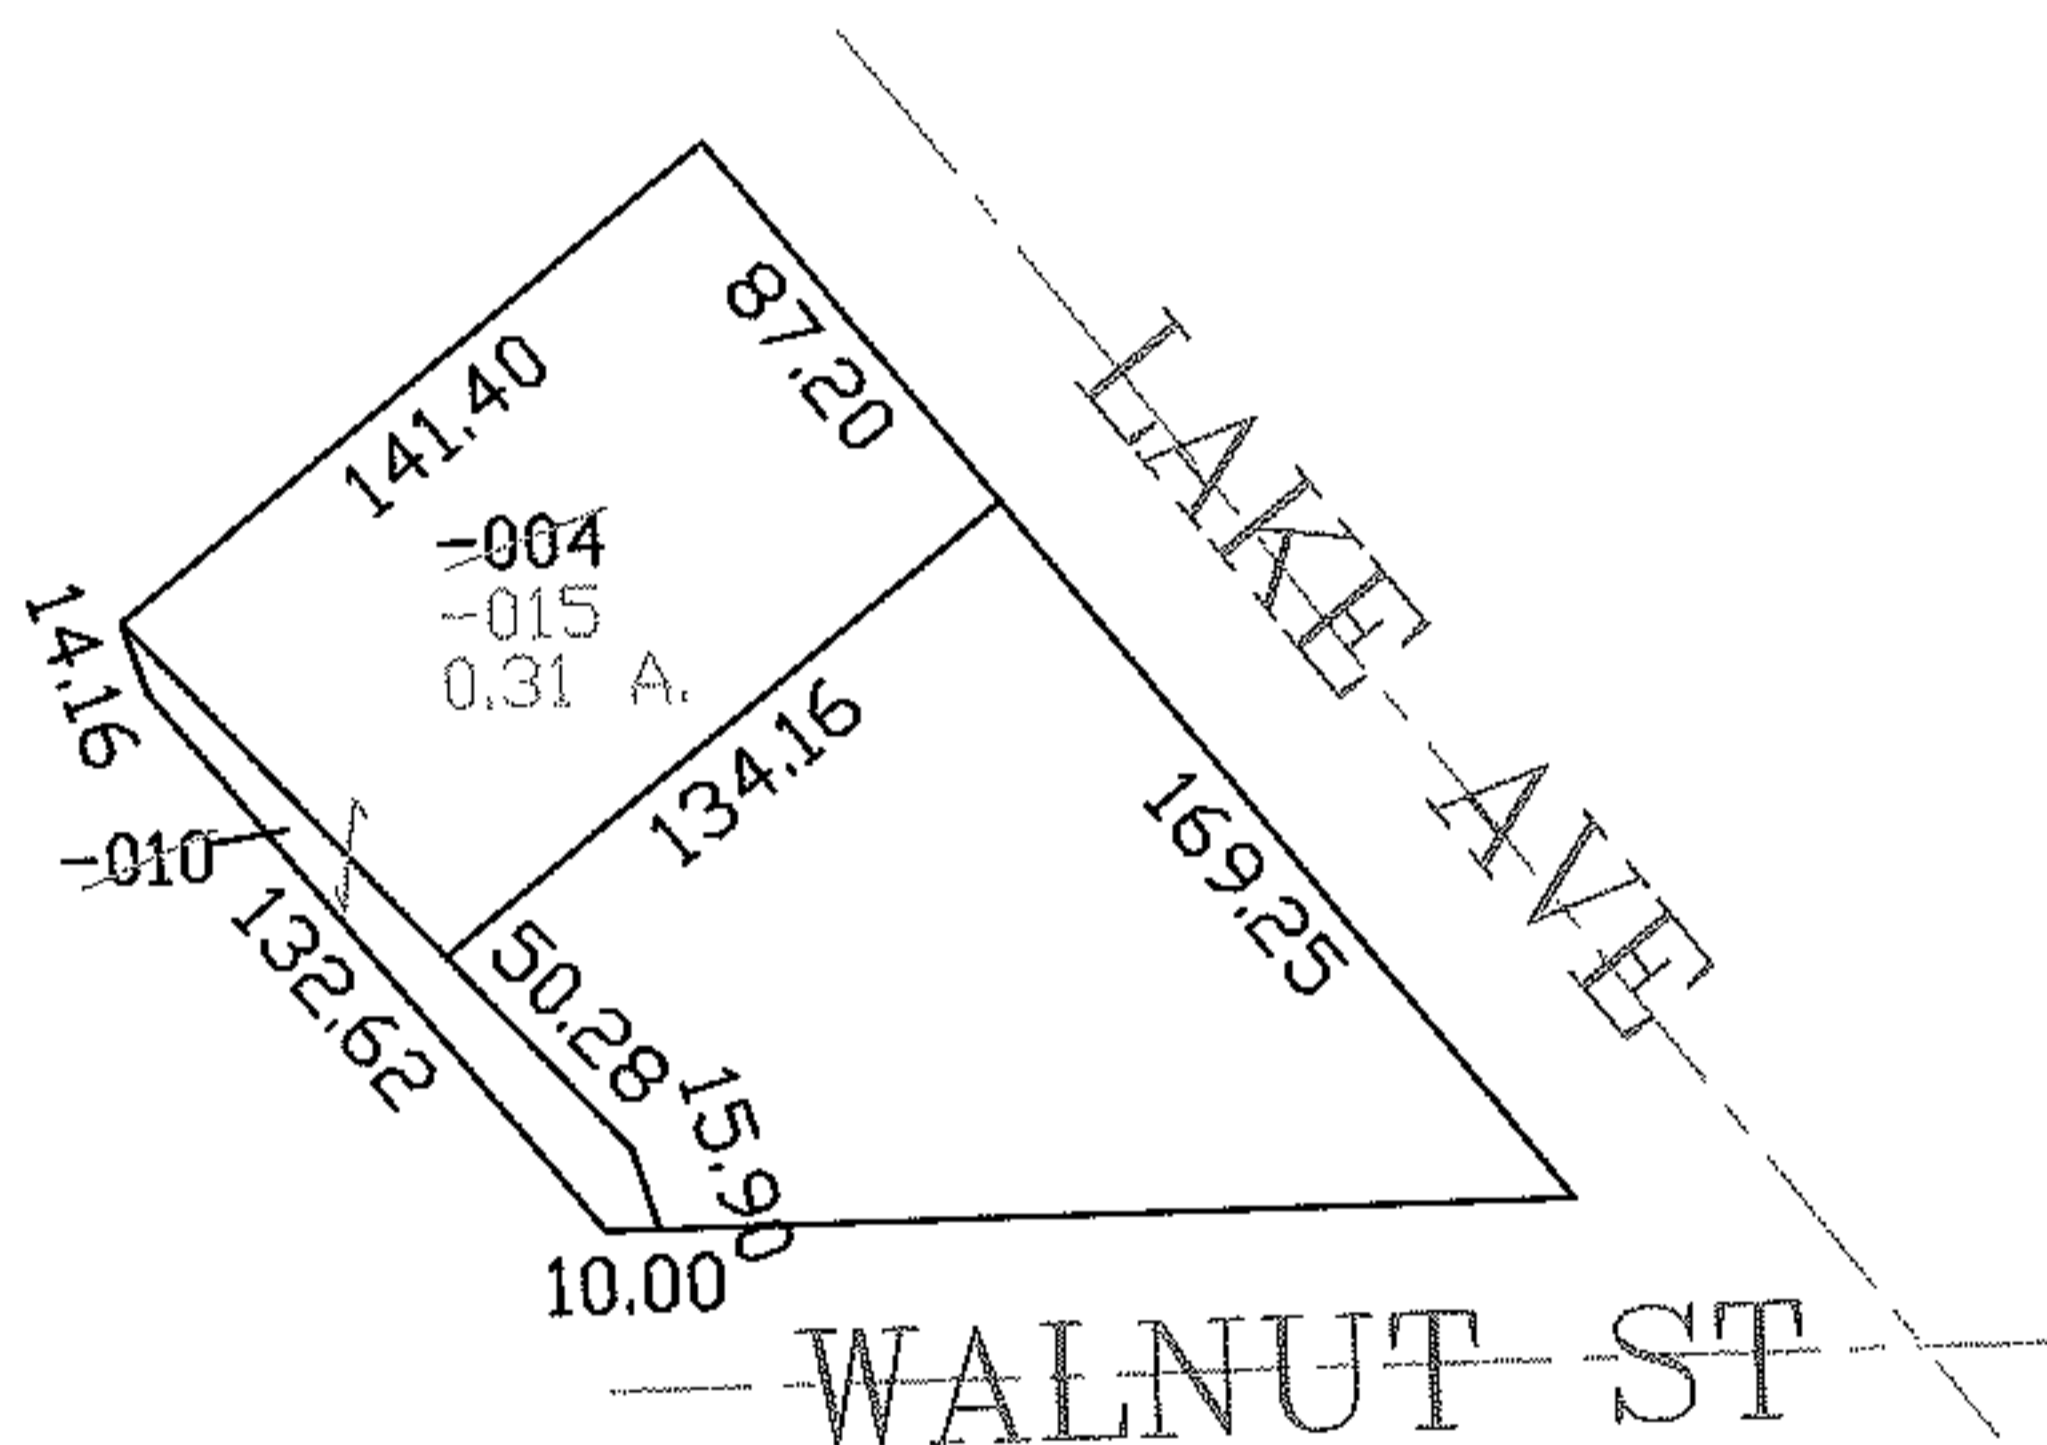


MASTER

PARENT PARCEL: 06-24-027-109-004 & -010  
CHILD PARCEL: 06-24-027-109-015  
STARTING POINT: INT CL LAKE AVE AND WALNUT ST

06-01438-A

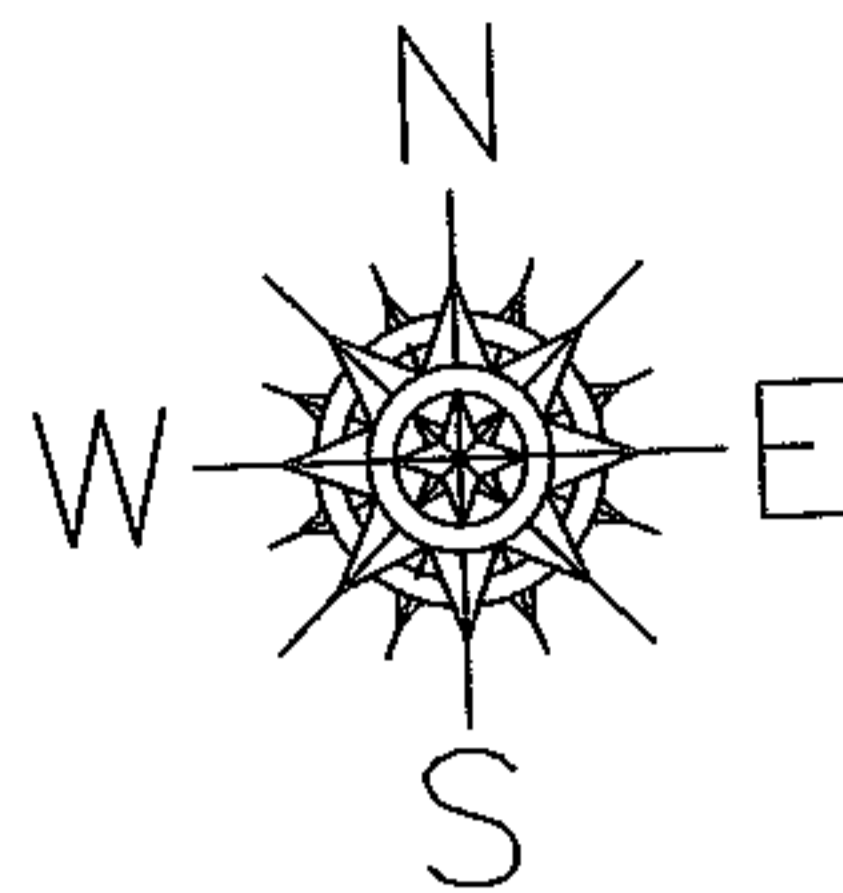

SPLITS/DEEDS PROCESSED

LORAIN COUNTY TAX MAP DEPARTMENT  
226 MIDDLE AVE. ELYRIA, OHIO

SURVEYED BY: RICHARD R. MCKAY  
CLOSURE: 1:10,000  
MAP PAGE(S): 06-80  
APPROVED BY: DRH DATE: 12/8/2006  
SCALE: 1"=100 PRIOR INSTRUMENT: 20050060568