



RASTER

PARENT PARCEL: 01-20-026-000-005


CHILD PARCEL: --SAME--

STARTING POINT: INT CL DEAN RD AND SPERRY RD

06-01439-A

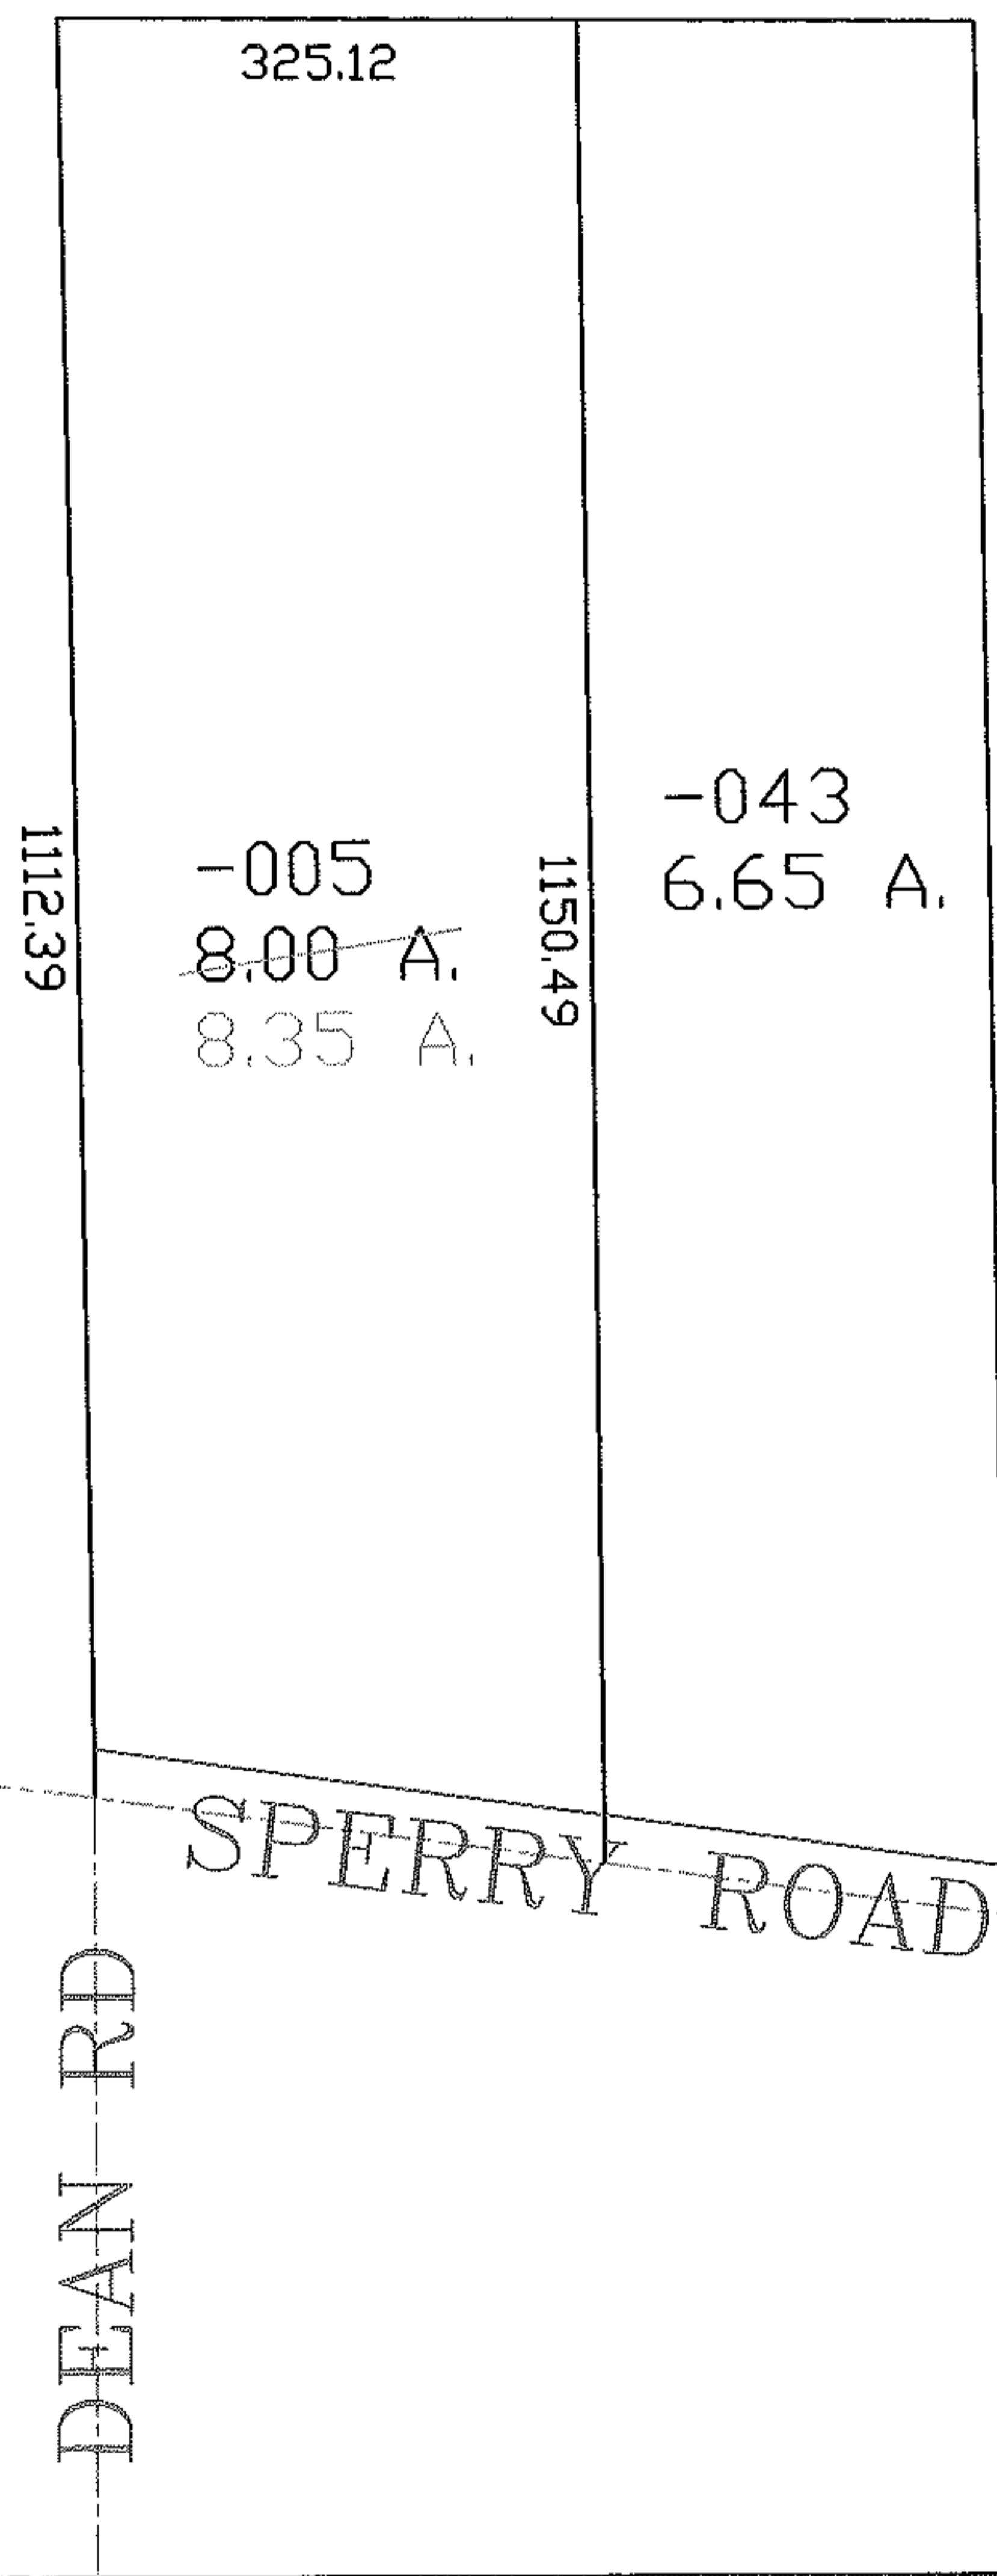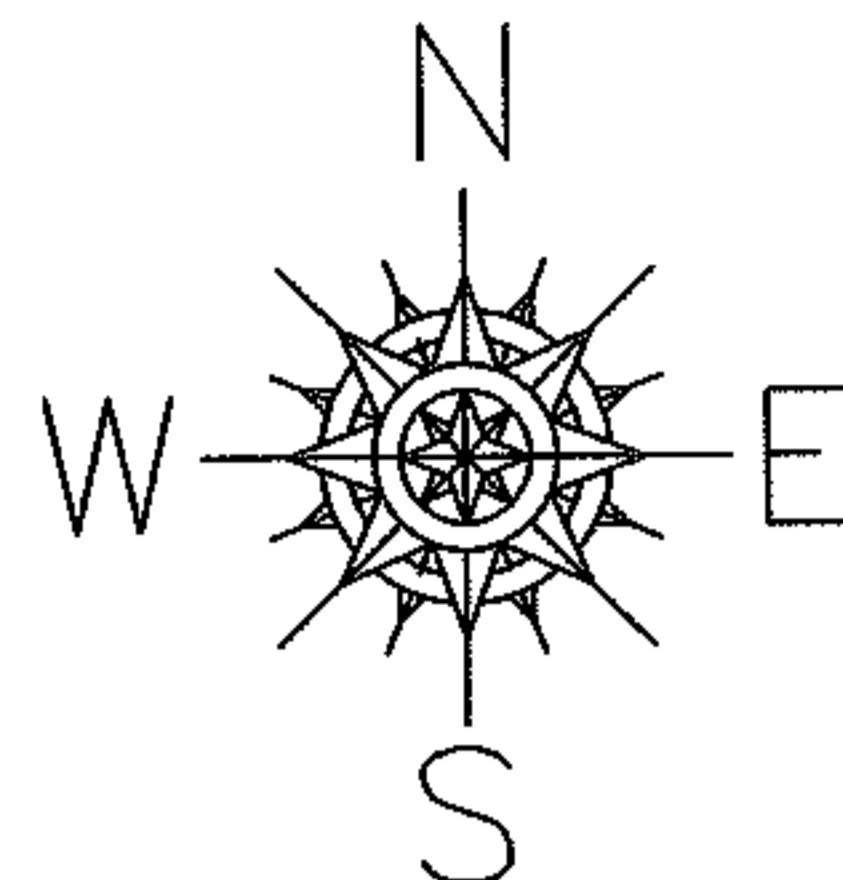

AC. CORR.  
PER DEED

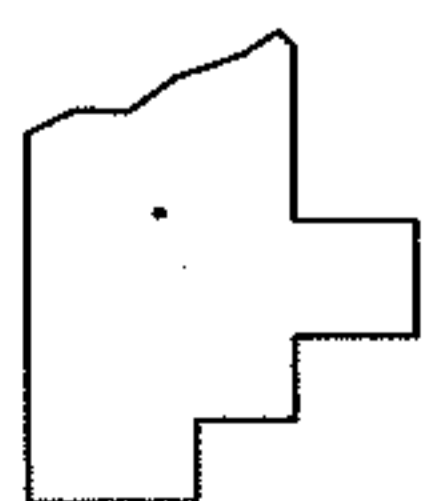

**SPLITS/DEEDS PROCESSED**  
**LORAIN COUNTY TAX MAP DEPARTMENT**  
 226 MIDDLE AVE. ELYRIA, OHIO

SURVEYED BY: N/A  
 CLOSURE: N/A  
 MAP PAGE(S): 1-1  
 APPROVED BY: DRH DATE: 12/21/2006  
 SCALE: 1" = 200 PRIOR INSTRUMENT: OR 1365/866