

RASTER



PARENT PARCEL: 02-01-003-135-013

CHILD PARCEL: --SAME--

STARTING POINT: S.L. 34 IN W.S. STREATOR T.R. SUB P.V. 4 P 29

07-01462-C

DEPTH CORR PER PLAT AND DEED

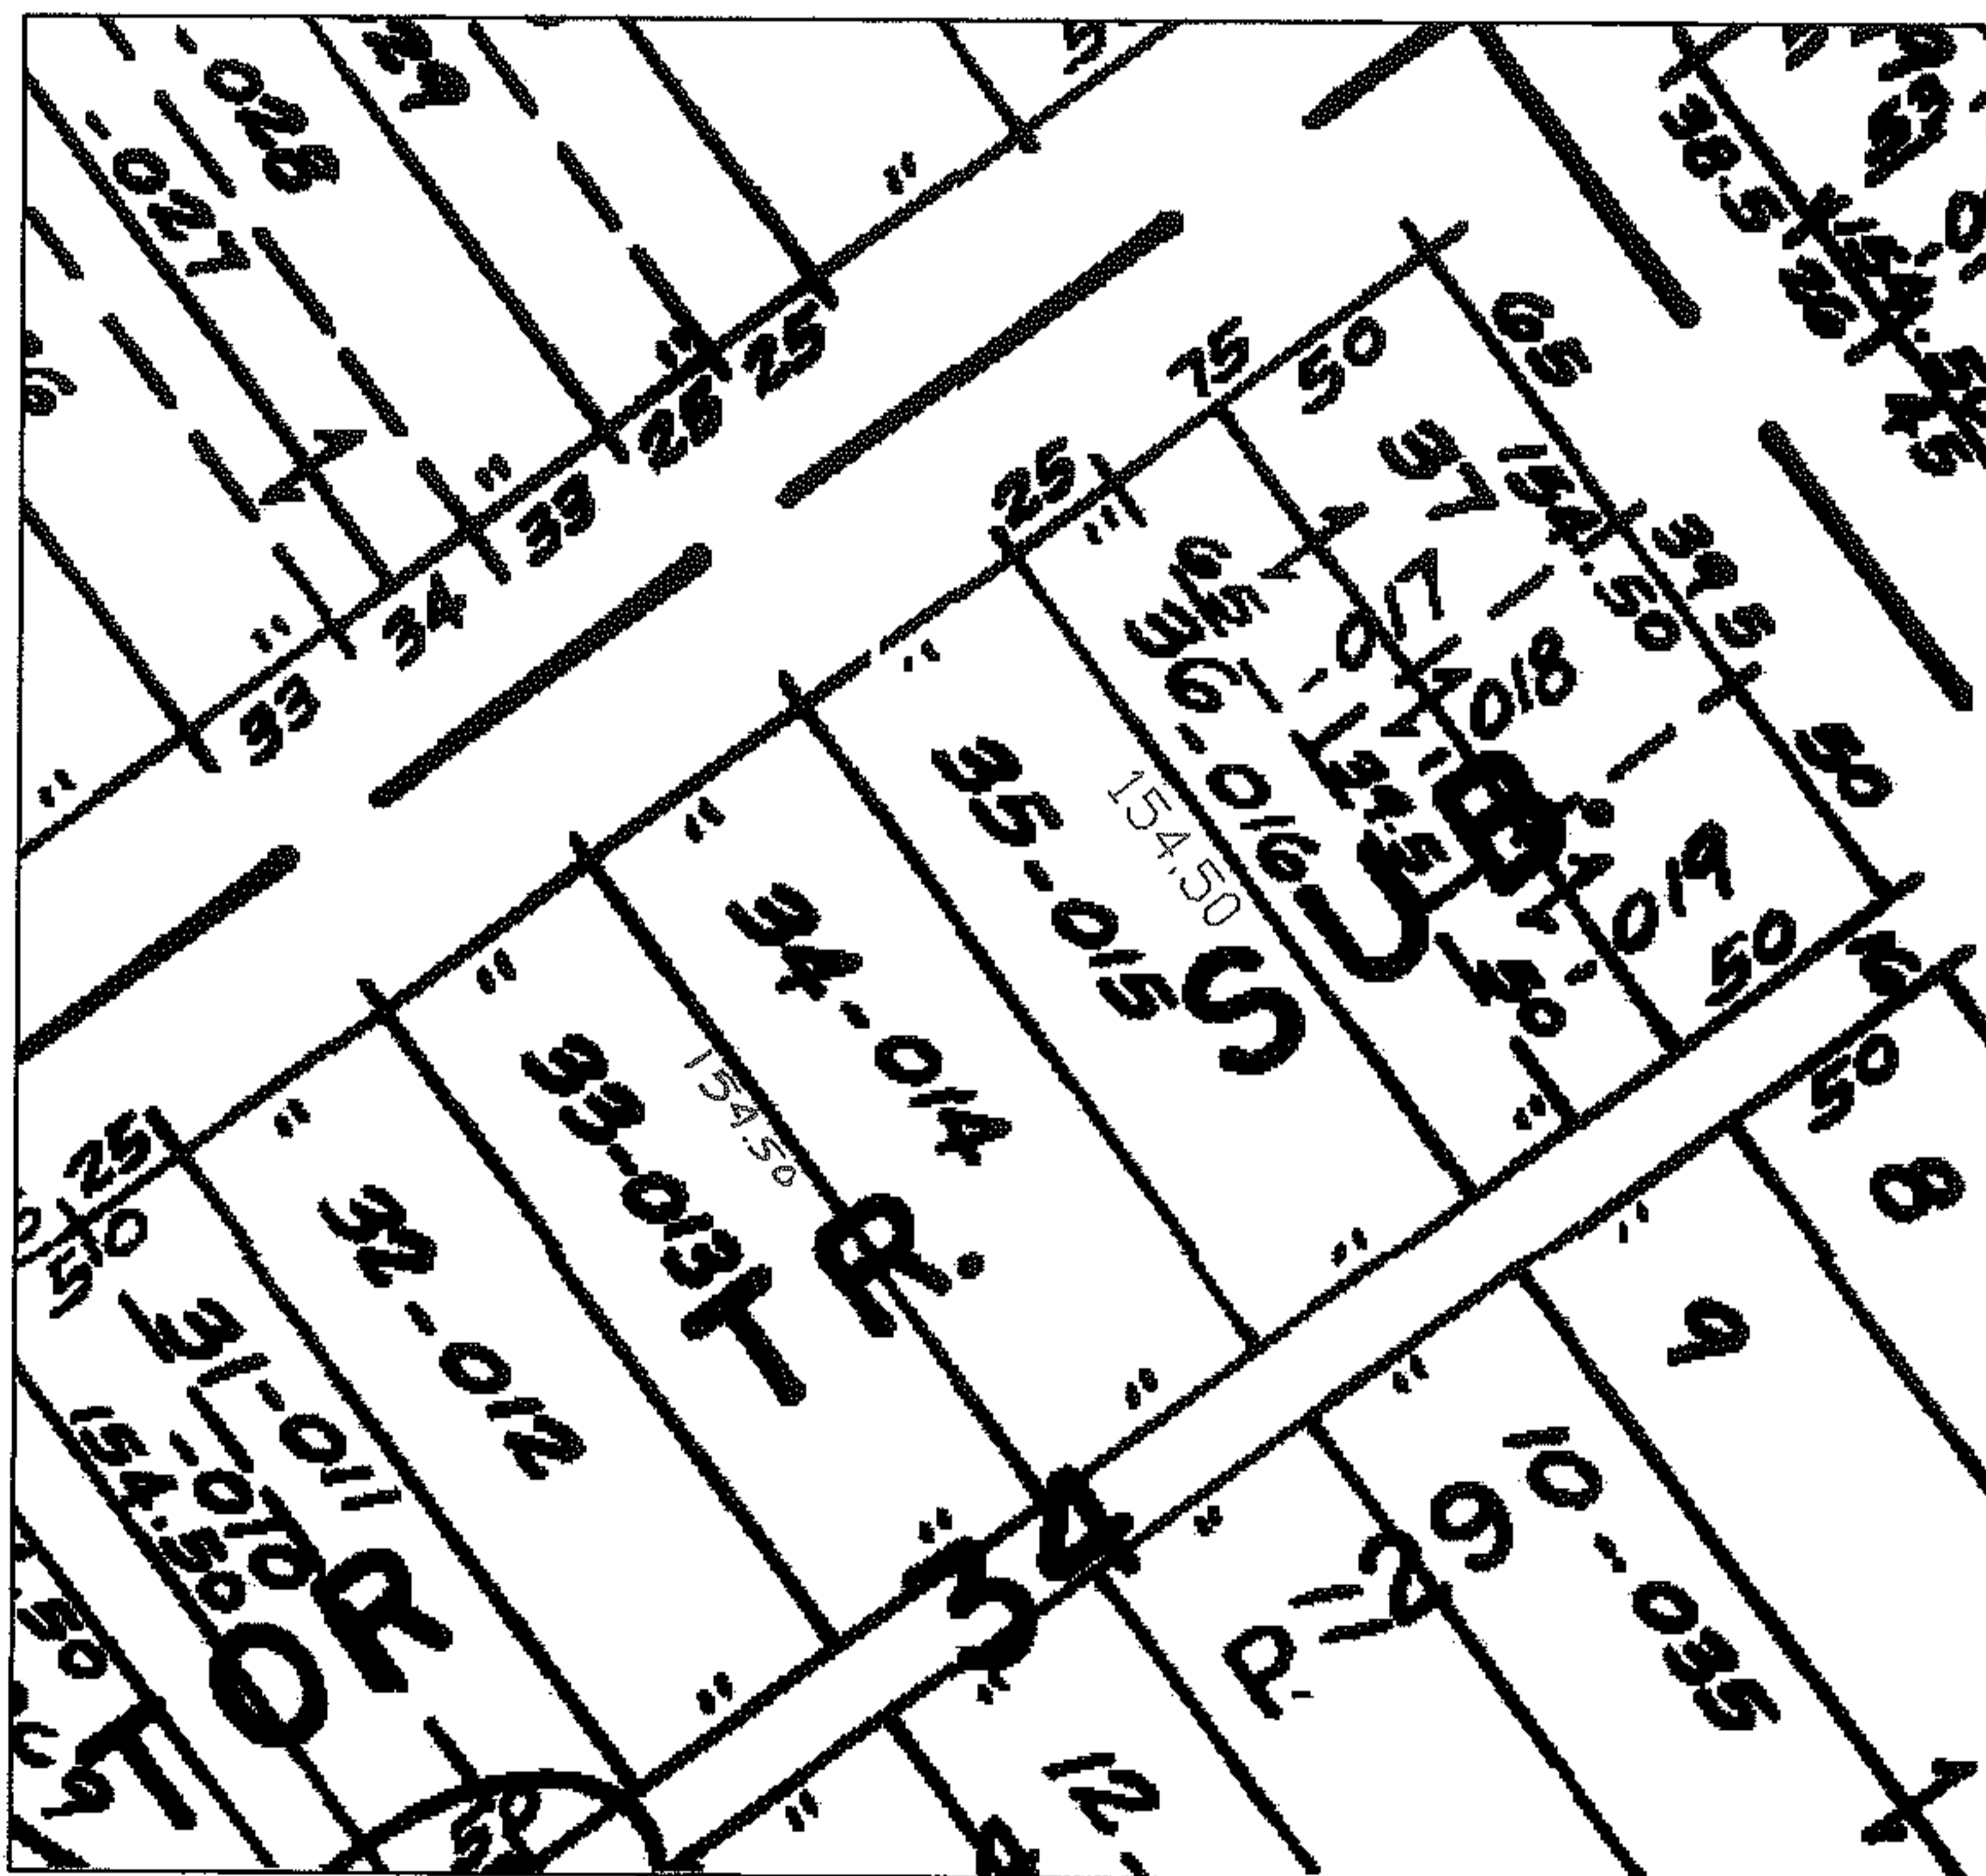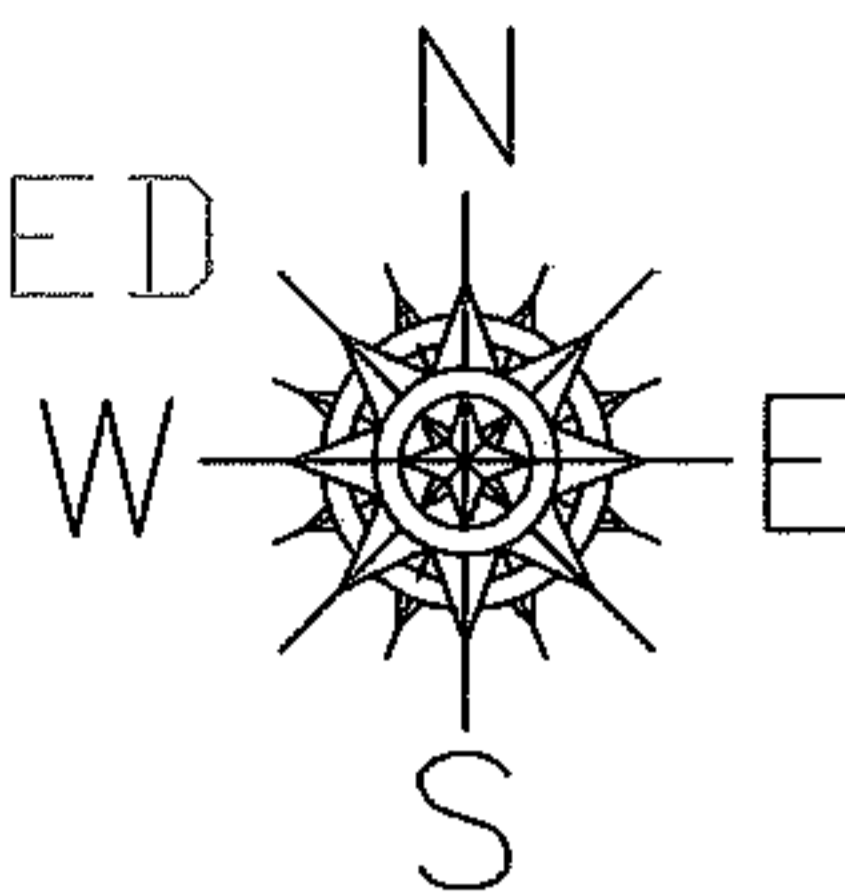

SPLITS/DEEDS PROCESSED

LORAIN COUNTY TAX MAP DEPARTMENT  
226 MIDDLE AVE. ELYRIA, OHIO

SURVEYED BY: N/A

CLOSURE: N/A

MAP PAGE(S): 02-01-003-B

APPROVED BY: DRH DATE: 2/27/2007

SCALE: 1" = 100 PRIOR INSTRUMENT: 1448/340