



PARENT PARCEL: 04-00-008-104-102, -105

CHILD PARCEL: 04-00-008-900-009, -010

STARTING POINT:

07-01471-X

ORDINANCE 27-2007

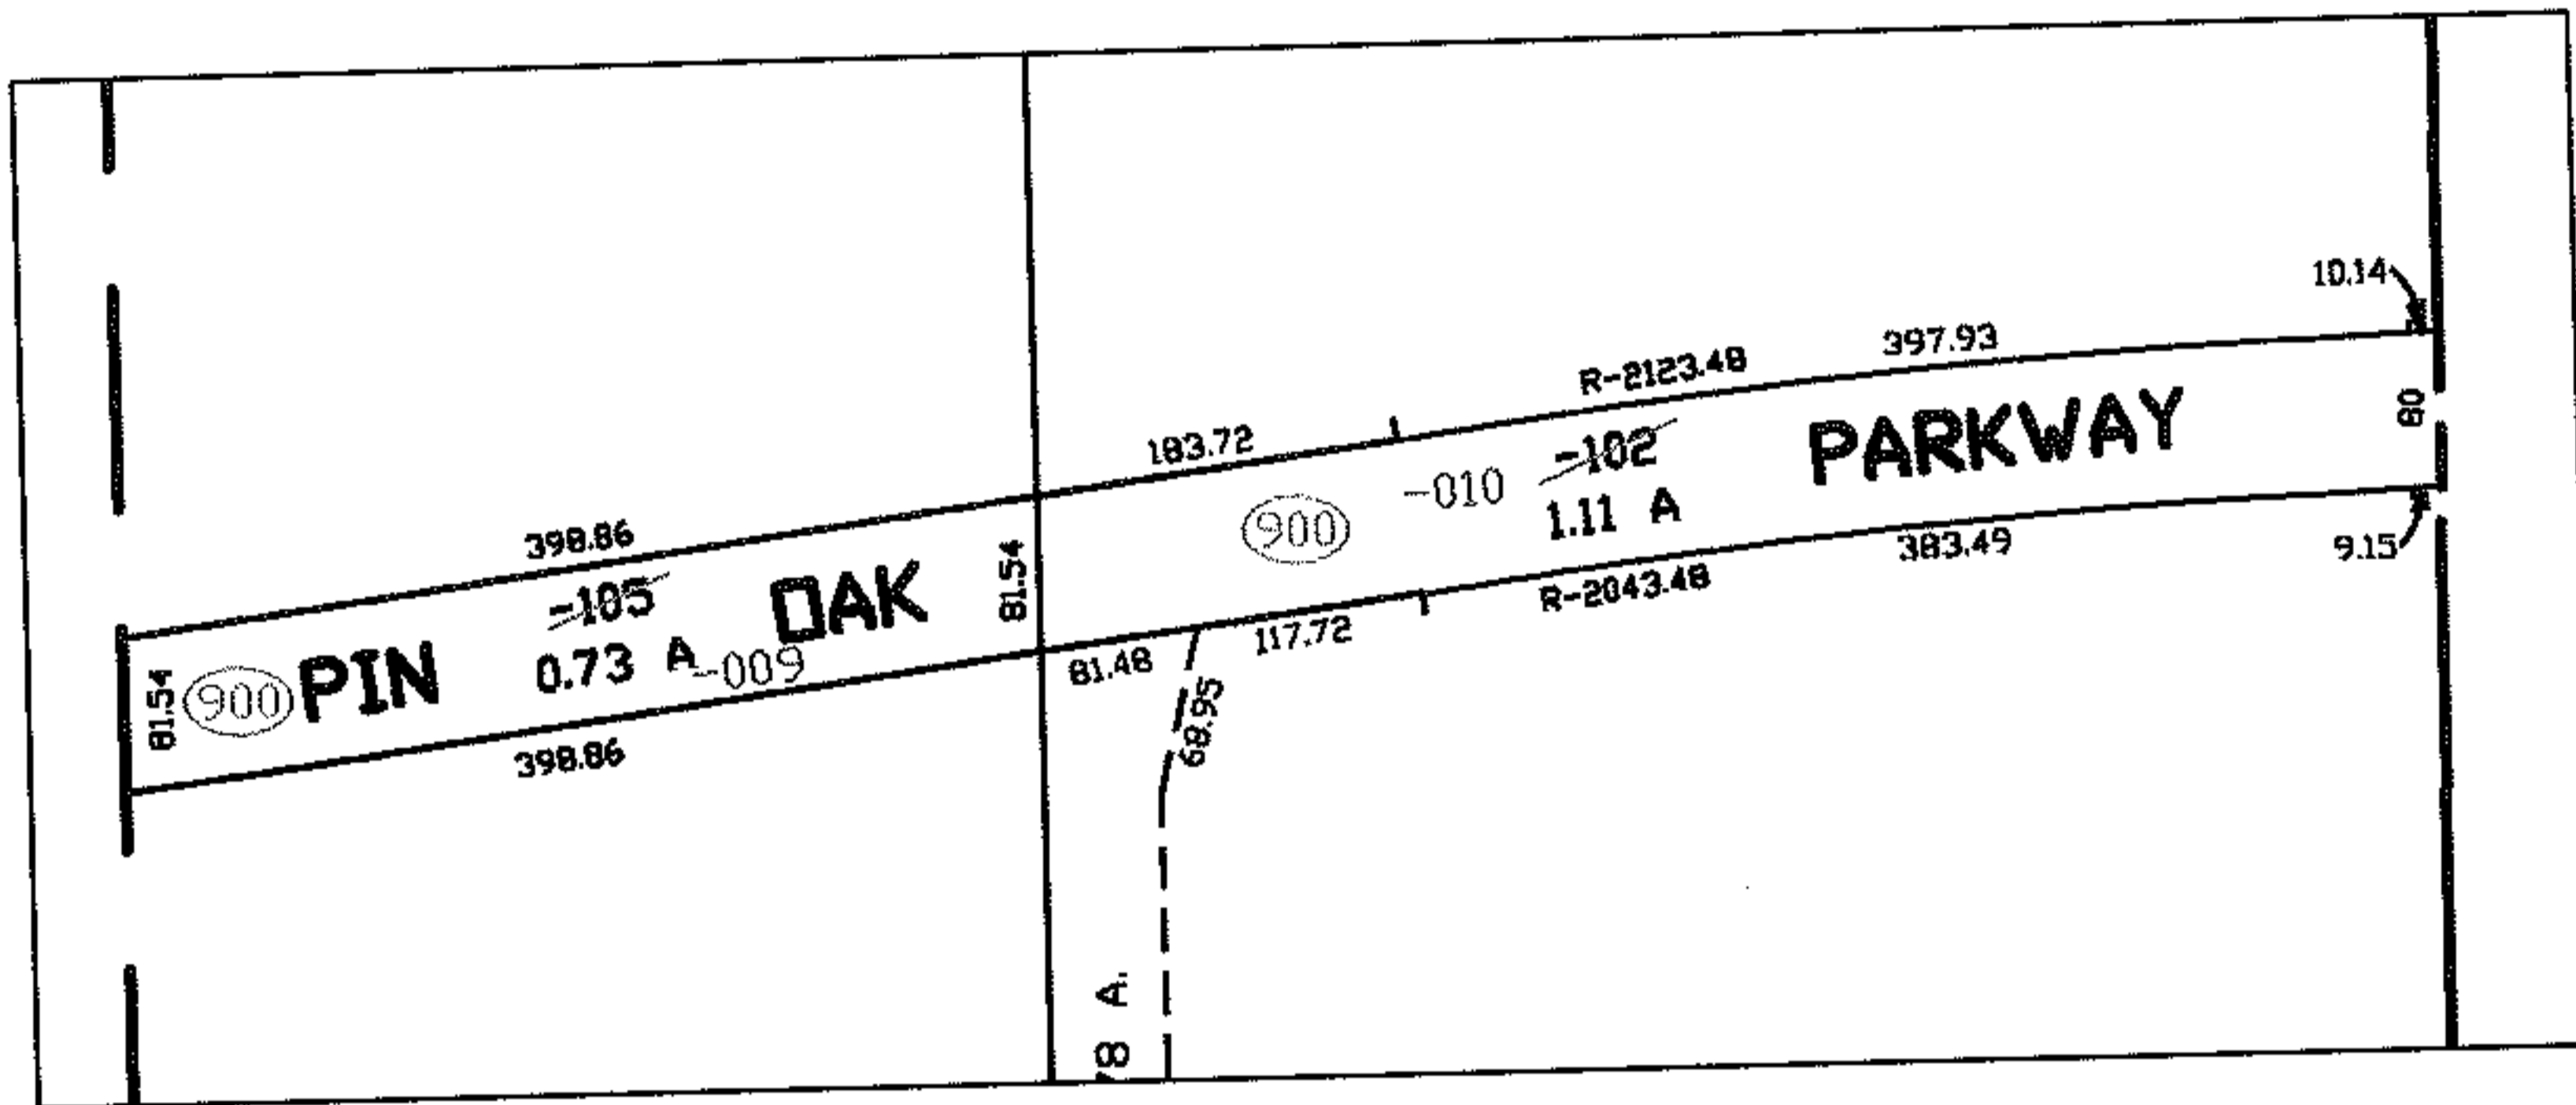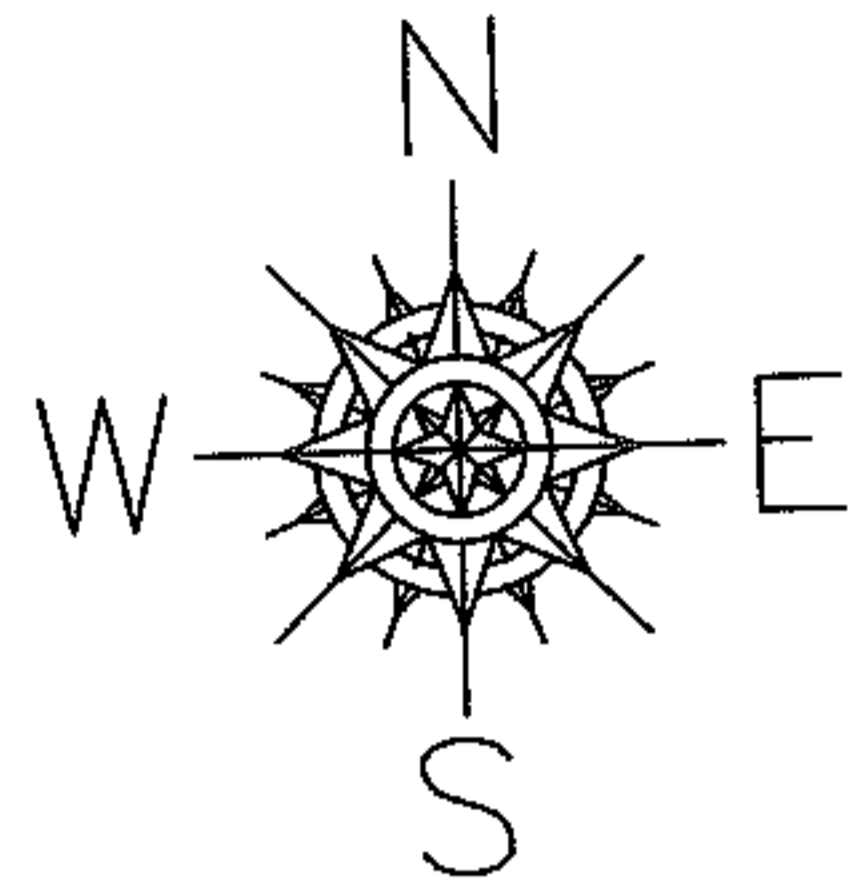

PAGE 2 OF 3

SPLITS/DEEDS PROCESSED

LORAIN COUNTY TAX MAP DEPARTMENT  
226 MIDDLE AVE. ELYRIA, OHIO

SURVEYED BY: N/A

CLOSURE: N/A

MAP PAGE(S): 04-00-008-H

APPROVED BY: DRH DATE: 4/3/2007

SCALE: 1" = 300' PRIOR INSTRUMENT: