

RASTER



PARENT PARCEL: 04-00-008-104-099

CHILD PARCEL: 04-00-008-900-008

STARTING POINT:

07-01471-X

ORDINANCE 27-2007

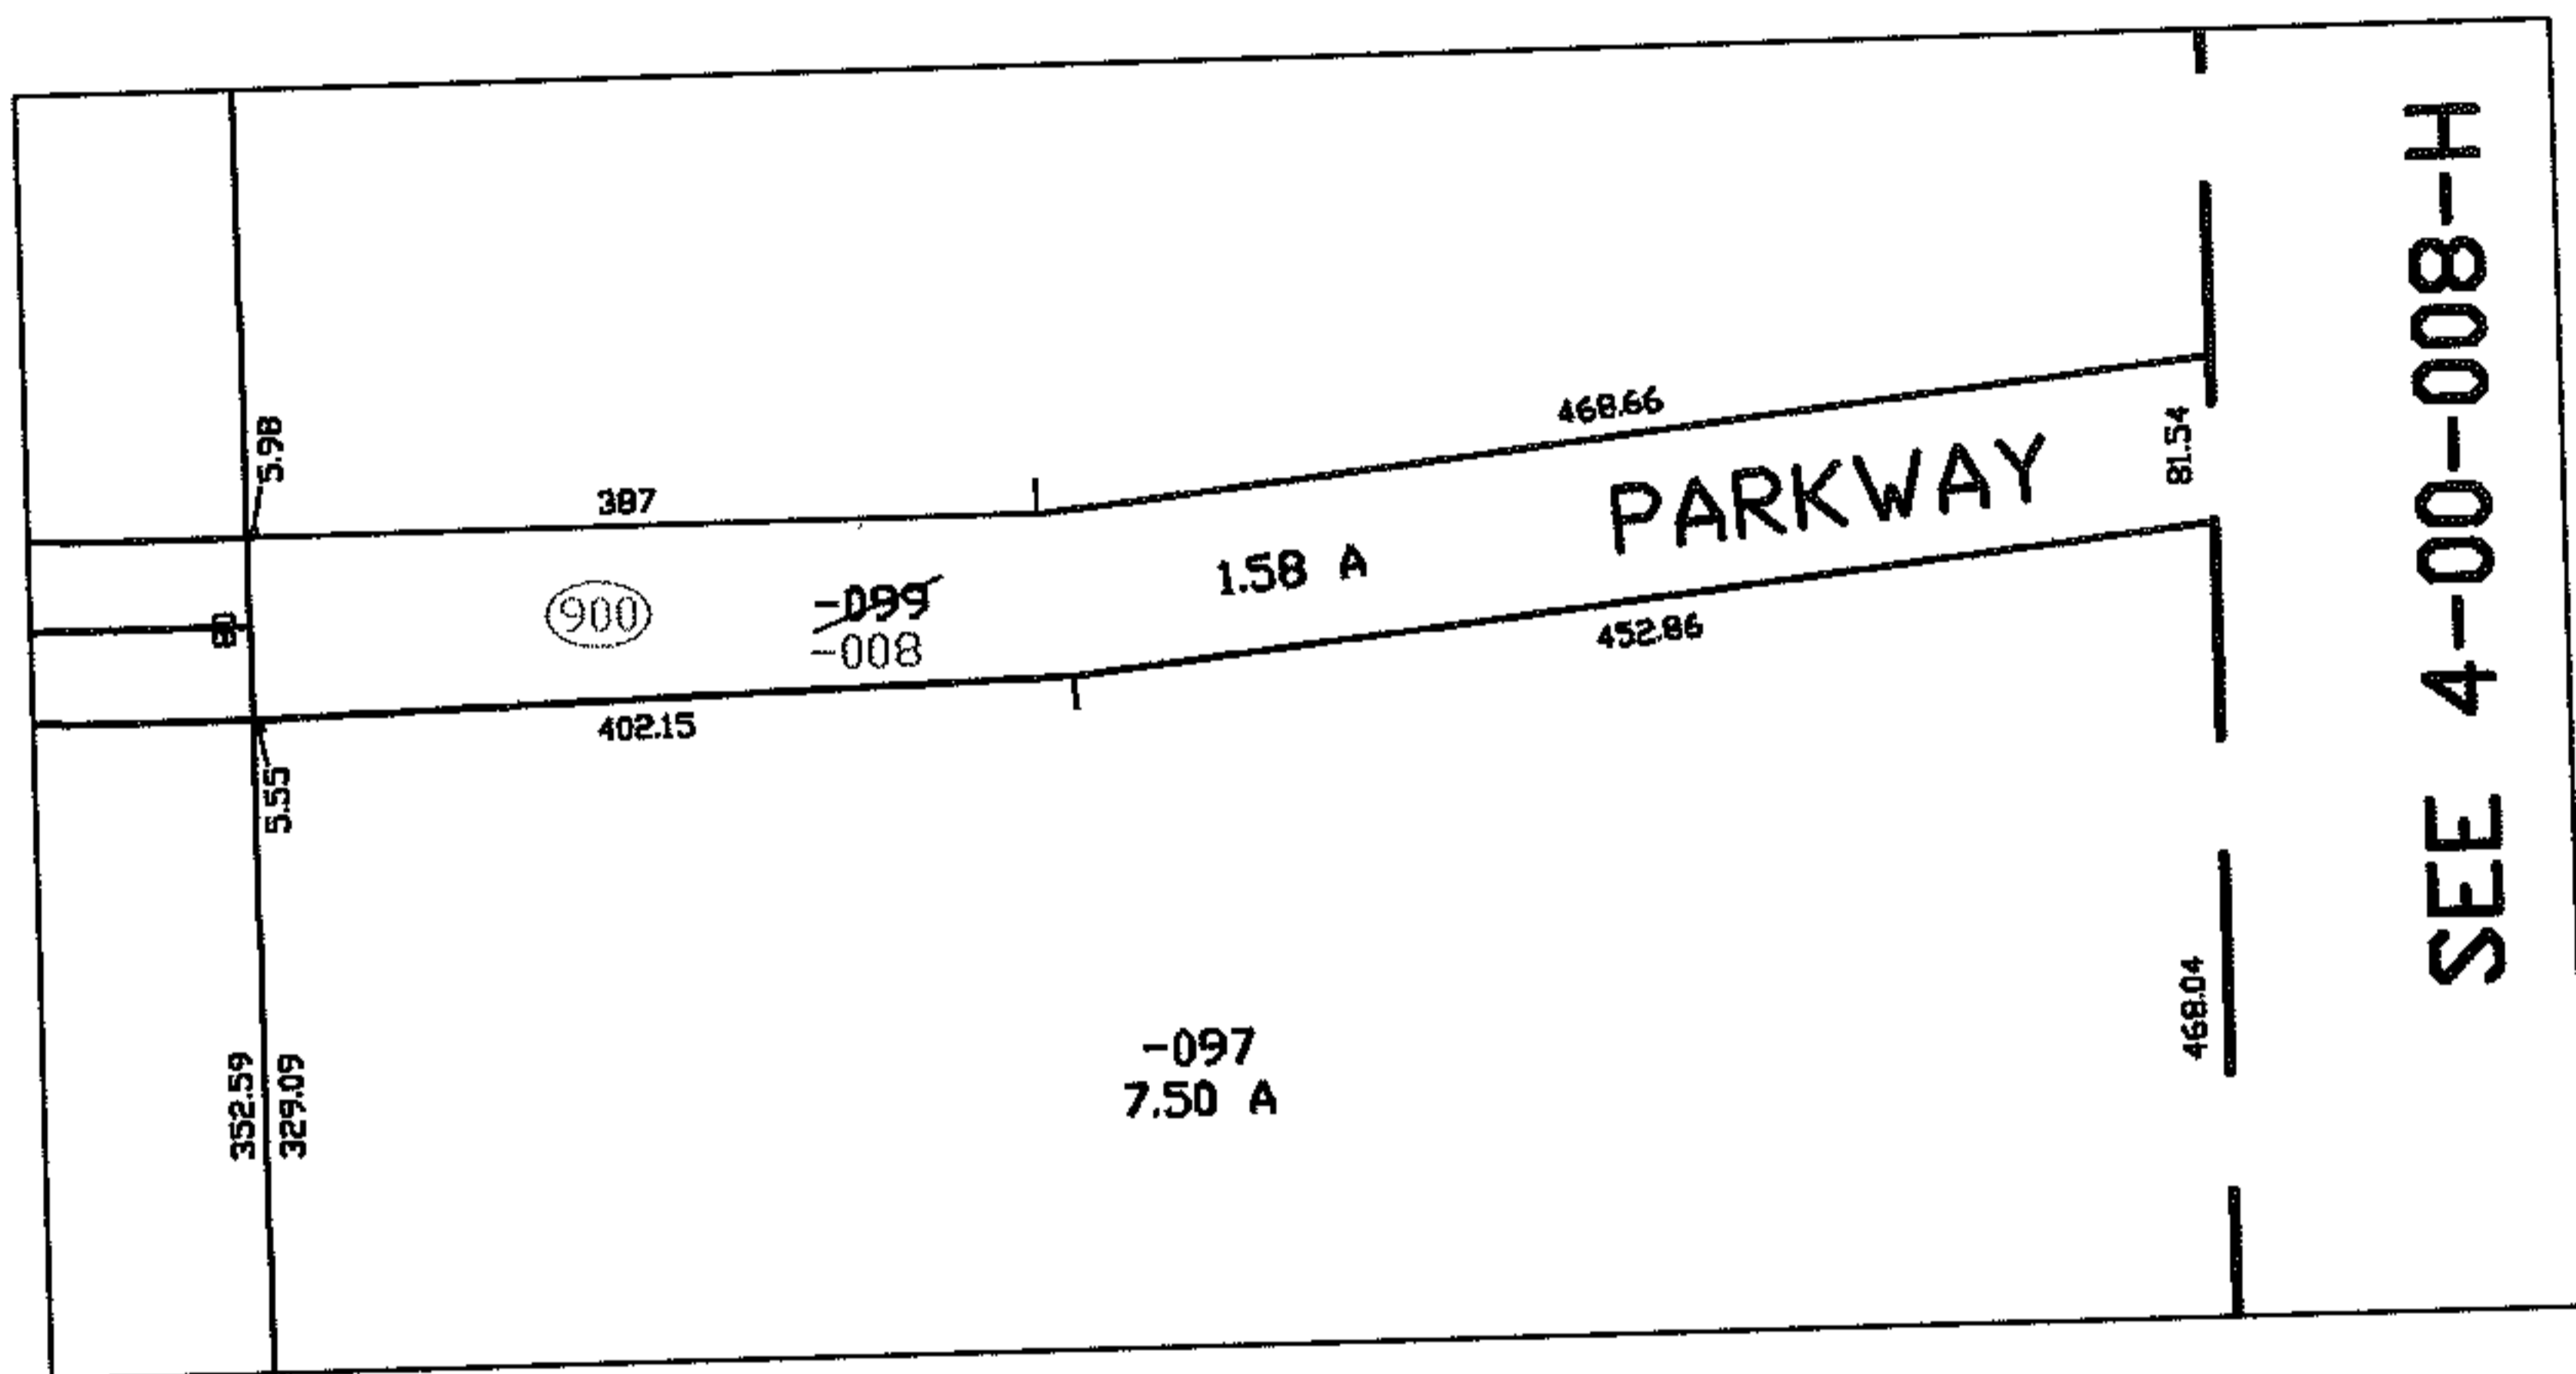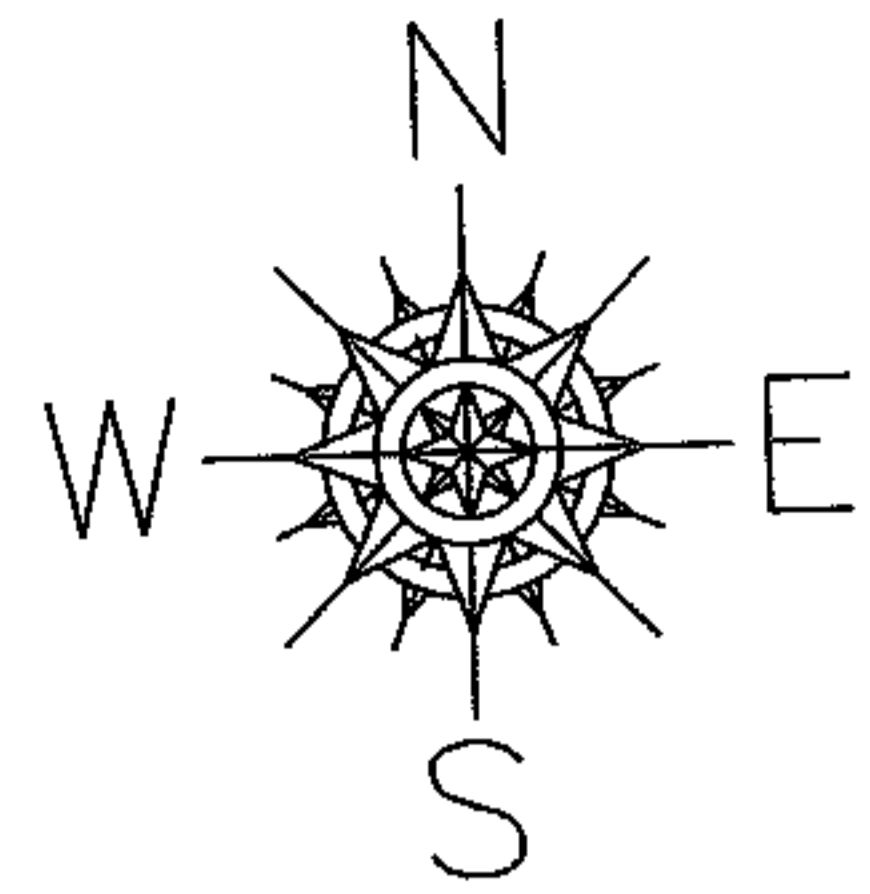

PAGE 1 OF 3

SPLITS/DEEDS PROCESSED

LORAIN COUNTY TAX MAP DEPARTMENT
226 MIDDLE AVE. ELYRIA, OHIO

SURVEYED BY: N/A

CLOSURE: N/A

MAP PAGE(S): 04-00-008-G

APPROVED BY: DRH DATE: 4/3/2007

SCALE: 1" = 300 PRIOR INSTRUMENT: