
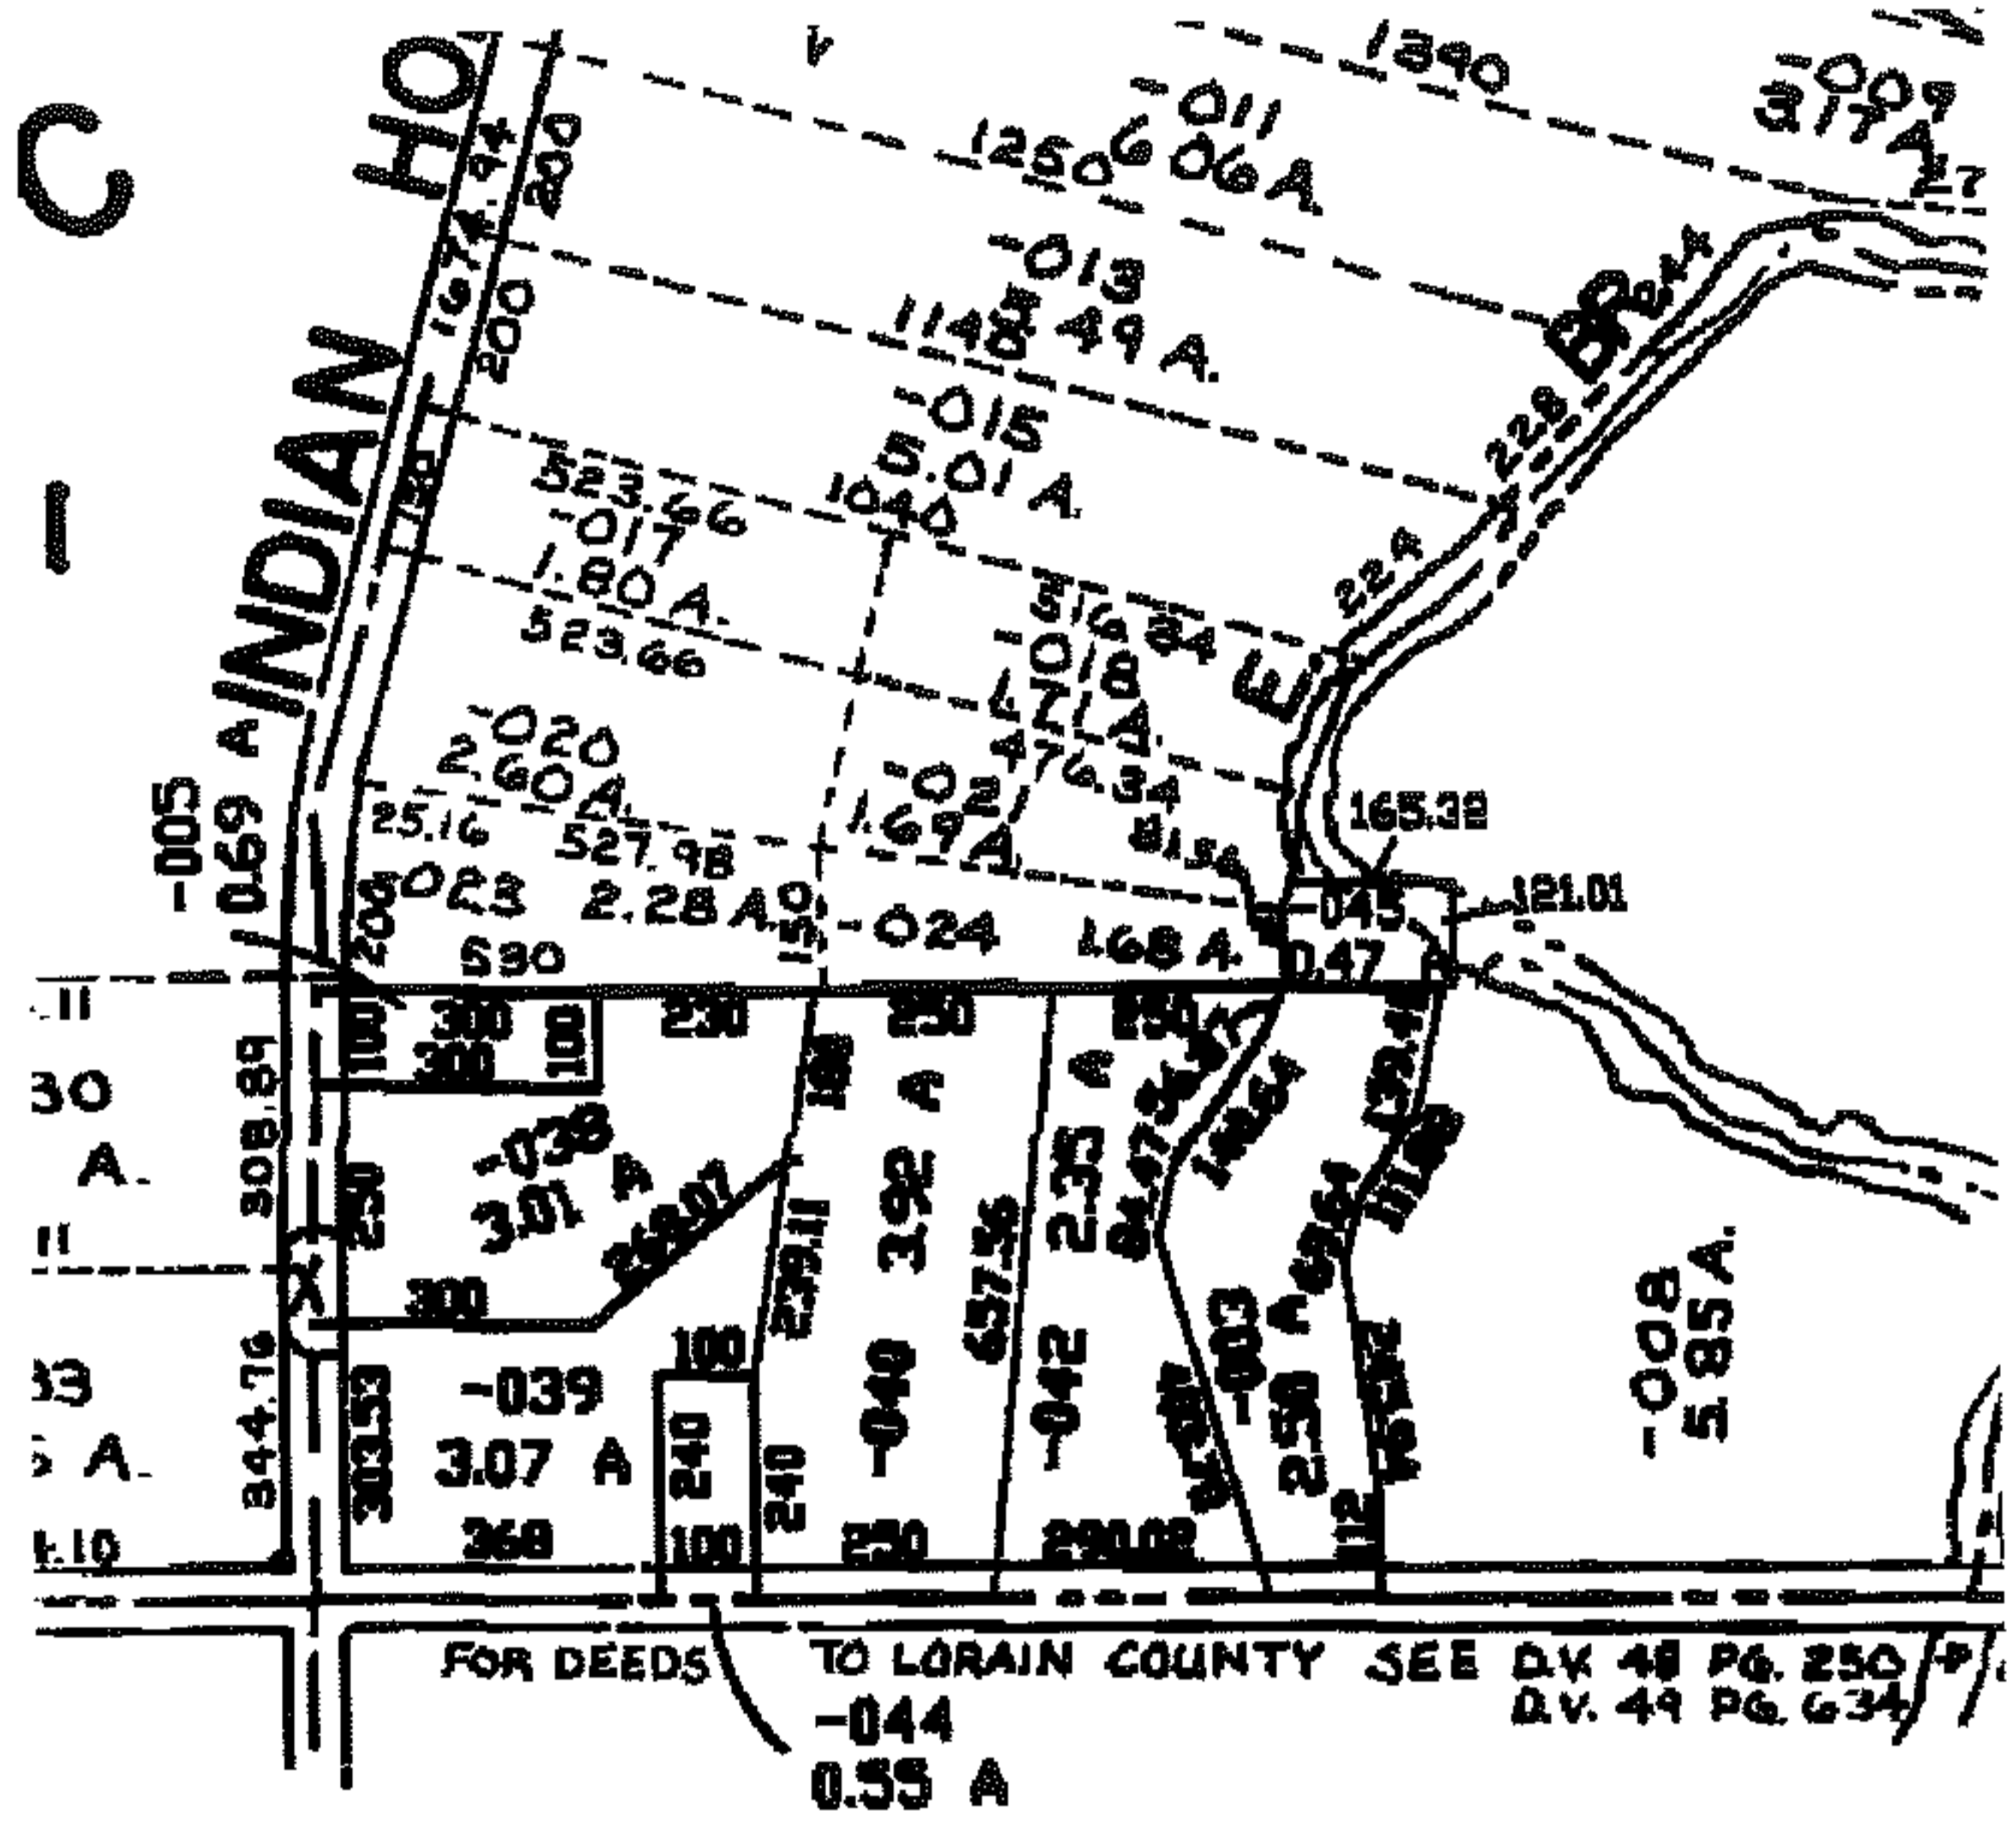


PASTER


07-01498-A

PARENT PARCEL: --NONE--
CHILD PARCEL: 19-04-011-000-045
STARTING POINT:

ADD TO DUP PER DEED AND SURVEY
RICHARD FREDRICKSON

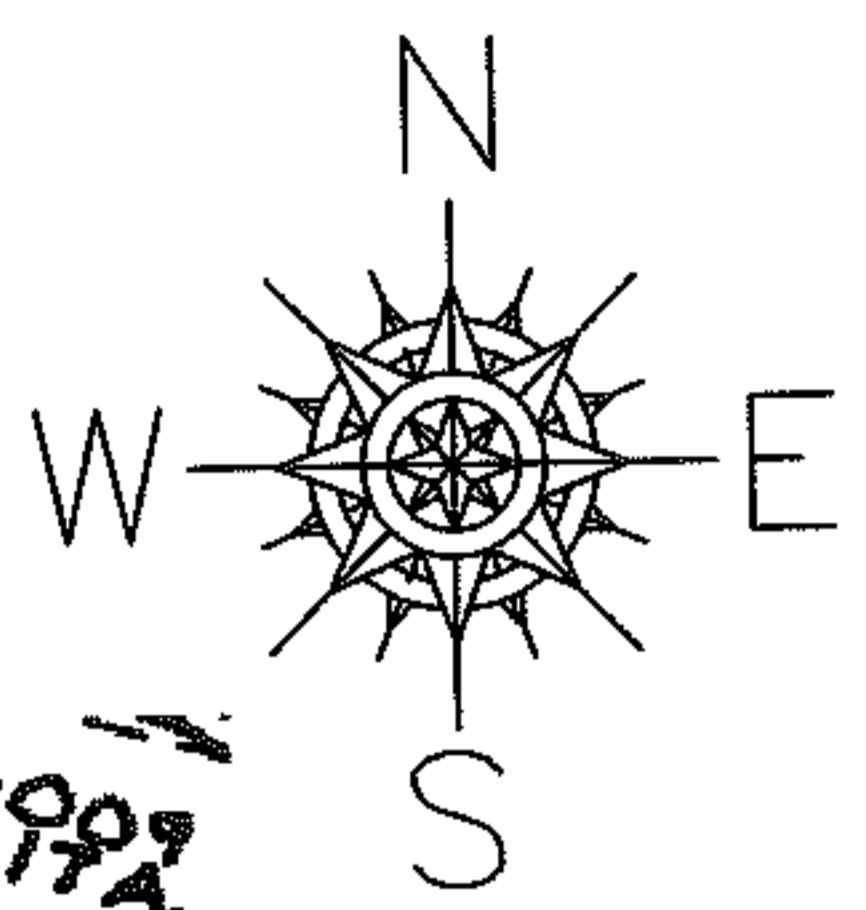

SEE 19-G

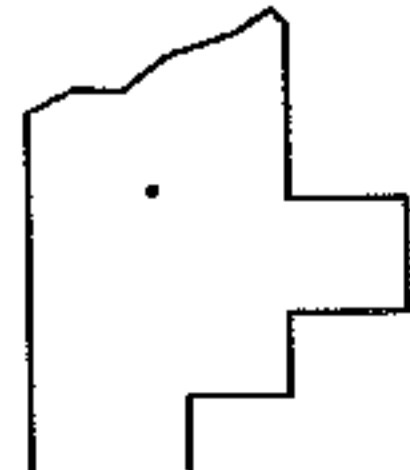

SPLITS/DEEDS PROCESSED

LORAIN COUNTY TAX MAP DEPARTMENT
226 MIDDLE AVE. ELYRIA, OHIO

SURVEYED BY: RICH FREDRICKSON
CLOSURE: 1:10,000
MAP PAGE(S): 19-C
APPROVED BY: DRH DATE: 7/10/2007
SCALE: NOT TO SCALE PRIOR INSTRUMENT: DV 49/634