
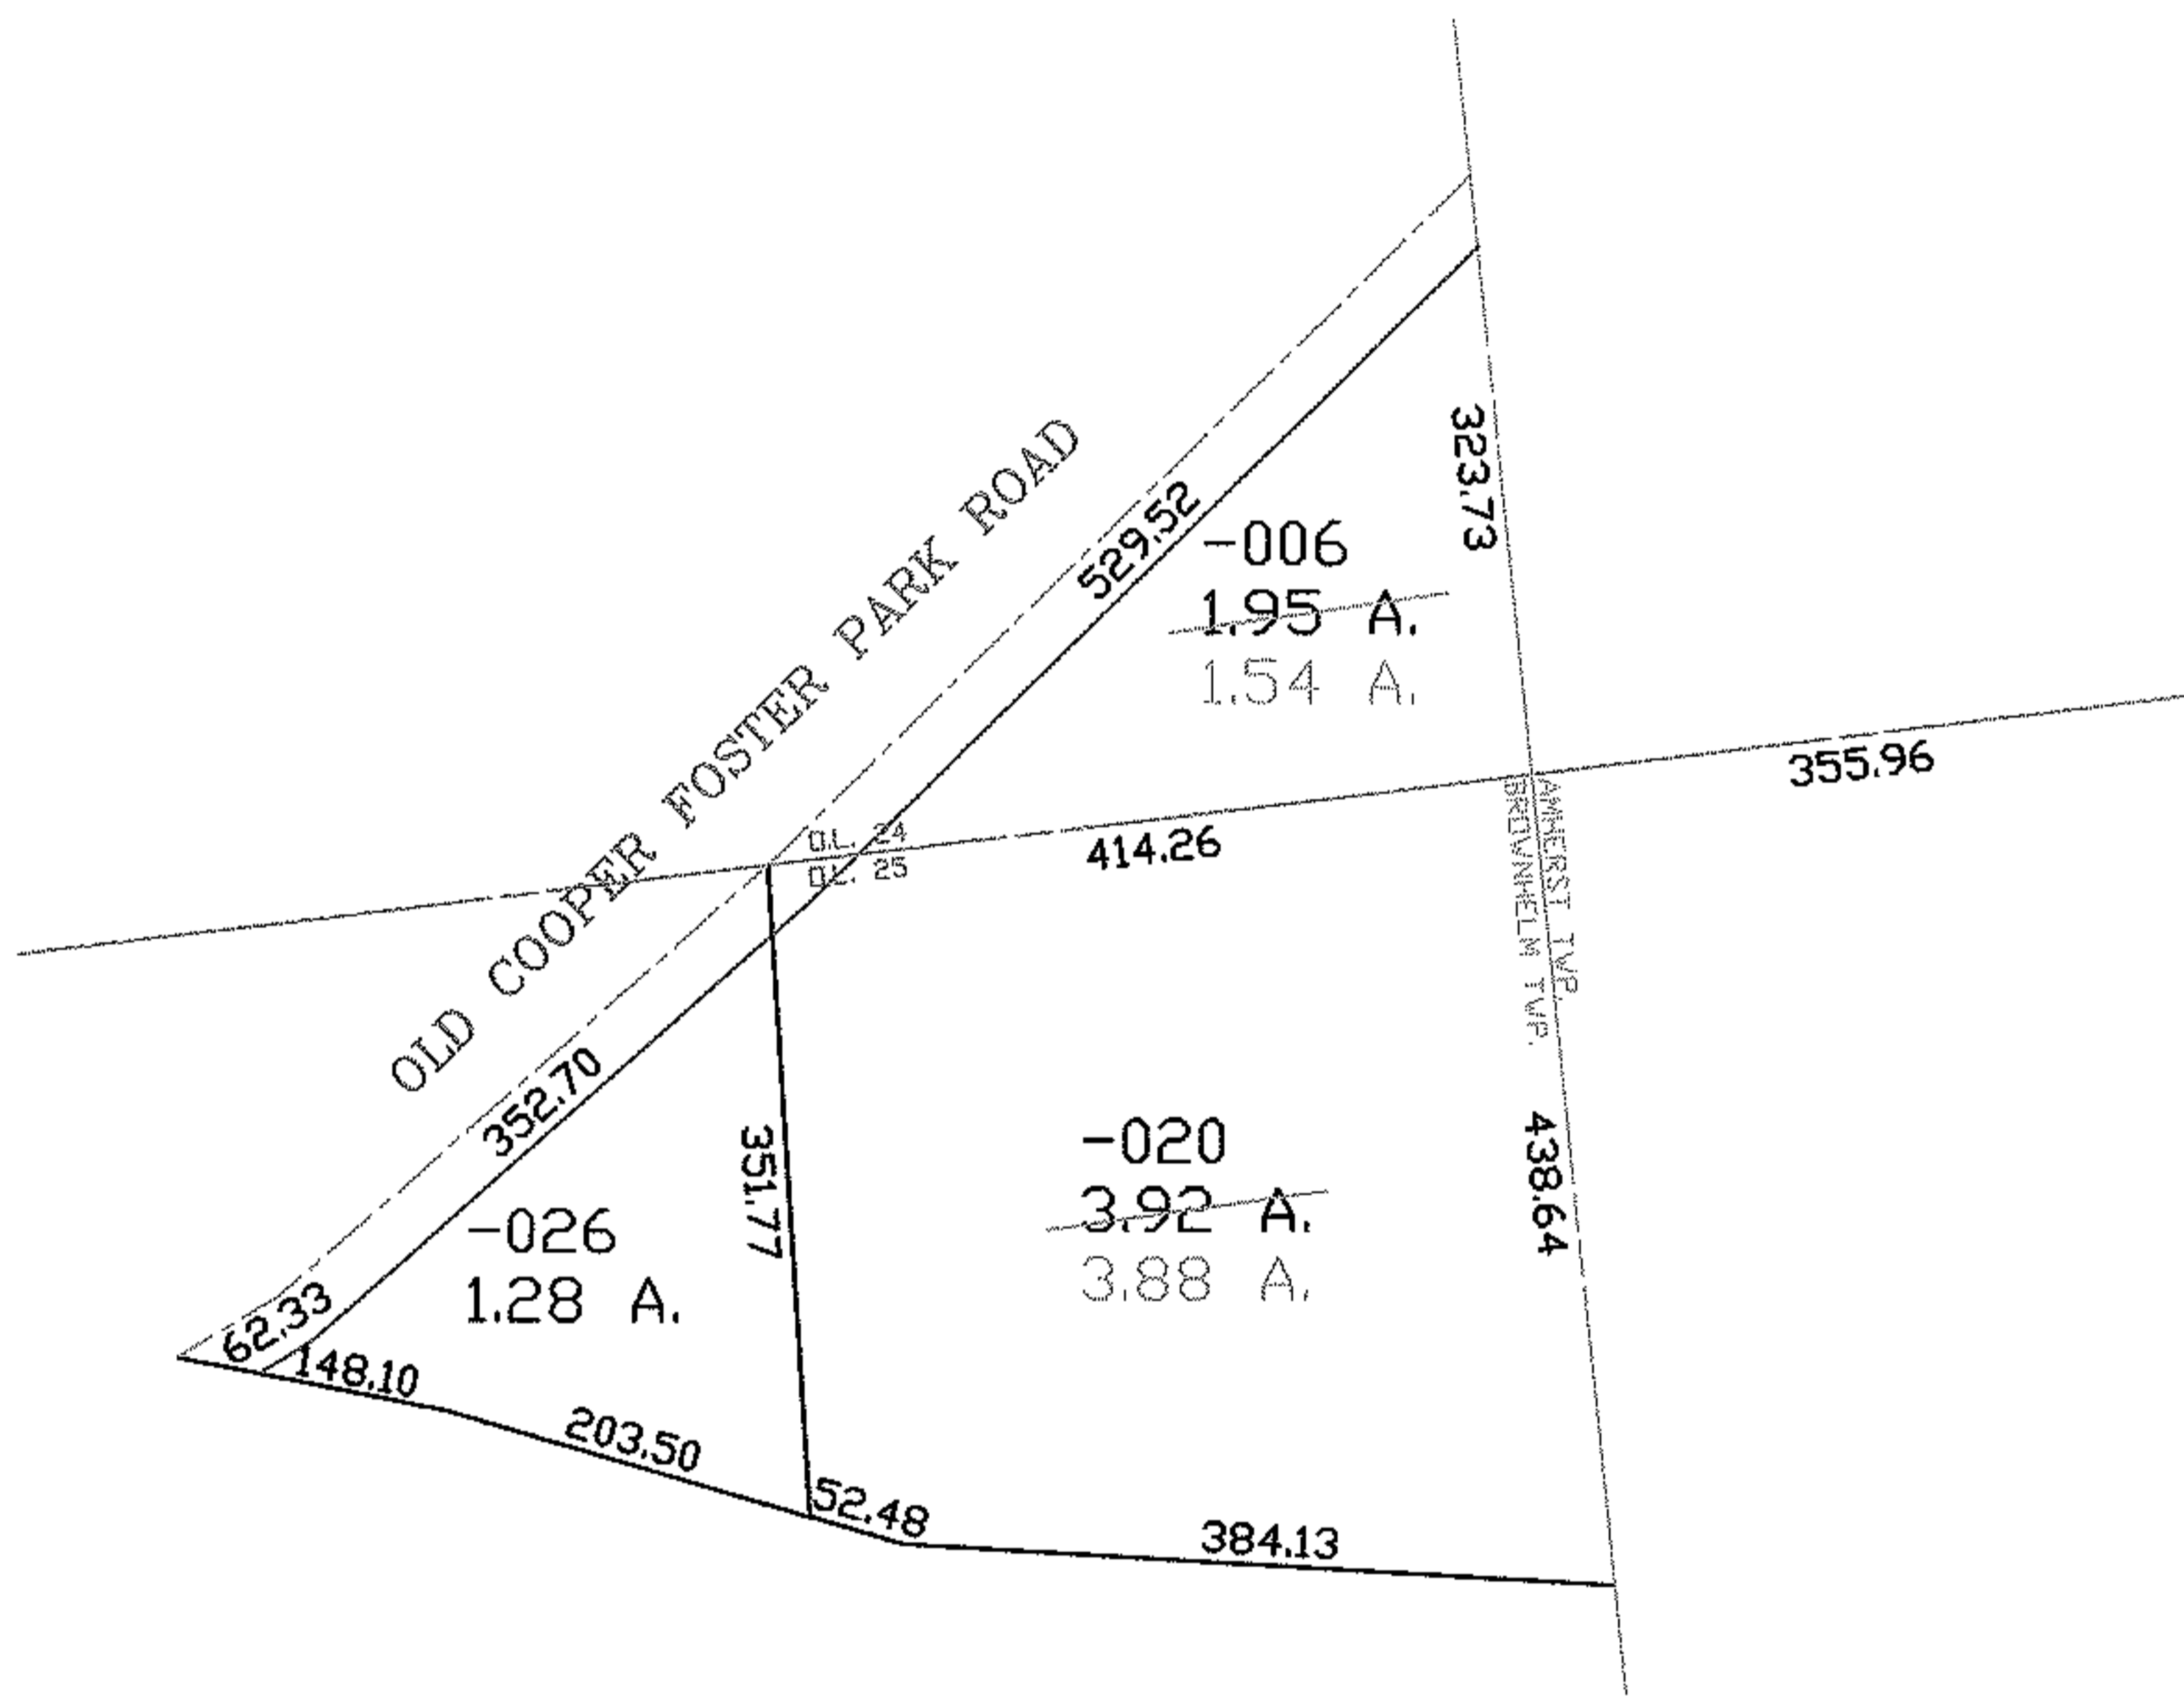



PARENT PARCEL: 01-00-024-000-006, 01-00-025-000-020  
CHILD PARCEL: --SAME--  
STARTING POINT: SE CORNER OF O.L. 24 AND NE CORNER OF O.L. 25

07-01499-X

AC. CORRS.  
PER SURVEY  
DALE HAYWOOD

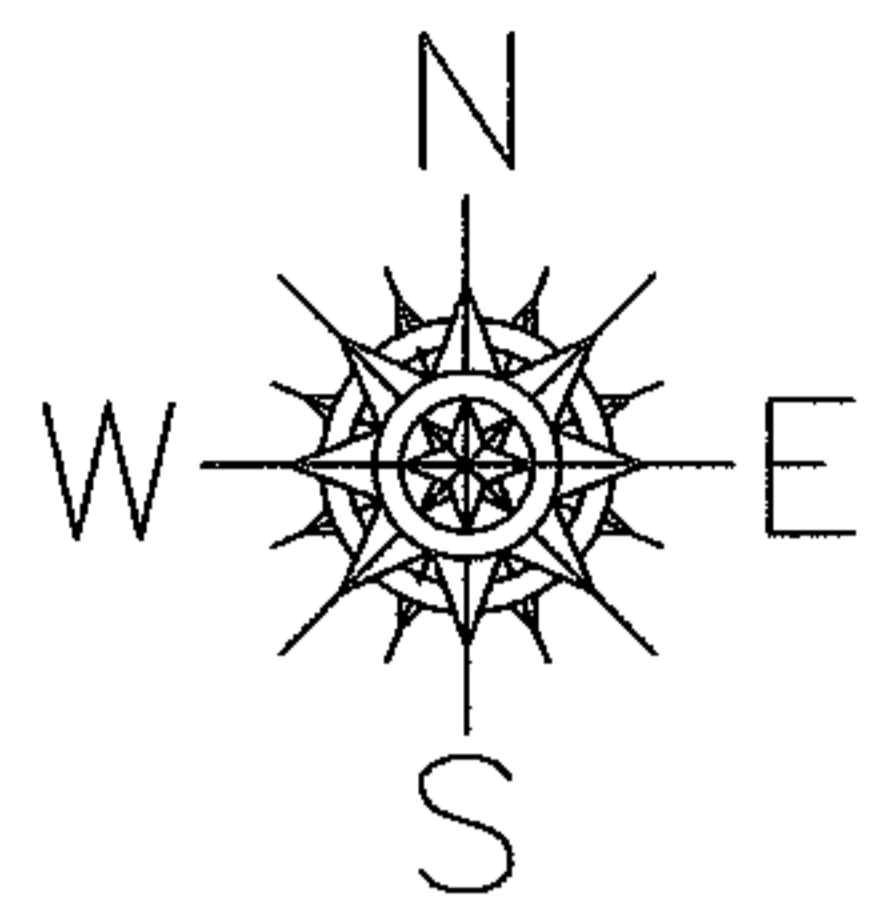

PRIOR INSTRUMENT: DV 701/377

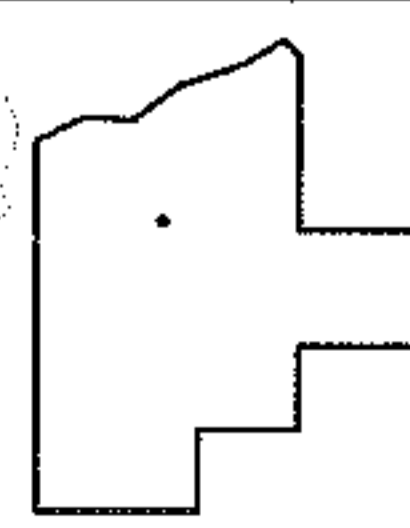

**SPLITS/DEEDS PROCESSED**  
LORAIN COUNTY TAX MAP DEPARTMENT  
226 MIDDLE AVE. ELYRIA, OHIO

SURVEYED BY: DALE HAYWOOD  
CLOSURE: 1:10,000  
MAP PAGE(S): 01-00-024-B, 01-00-025-B  
APPROVED BY: DRH DATE: 6/27/2007  
SCALE: 1" = 200' PRIOR INSTRUMENT: DV 692/146