




PARENT PARCEL: 06-25-054-600-001

07-01520-X

CHILD PARCEL: --SAME--

STARTING POINT:

# MAP CORRECTION ONLY

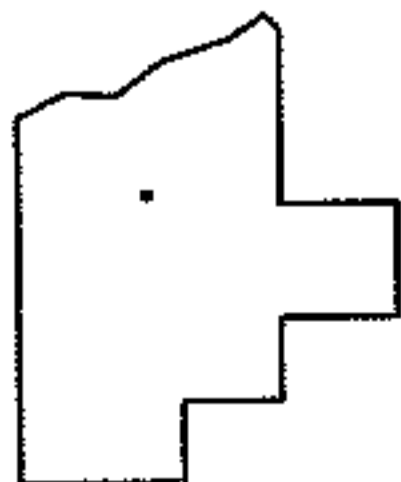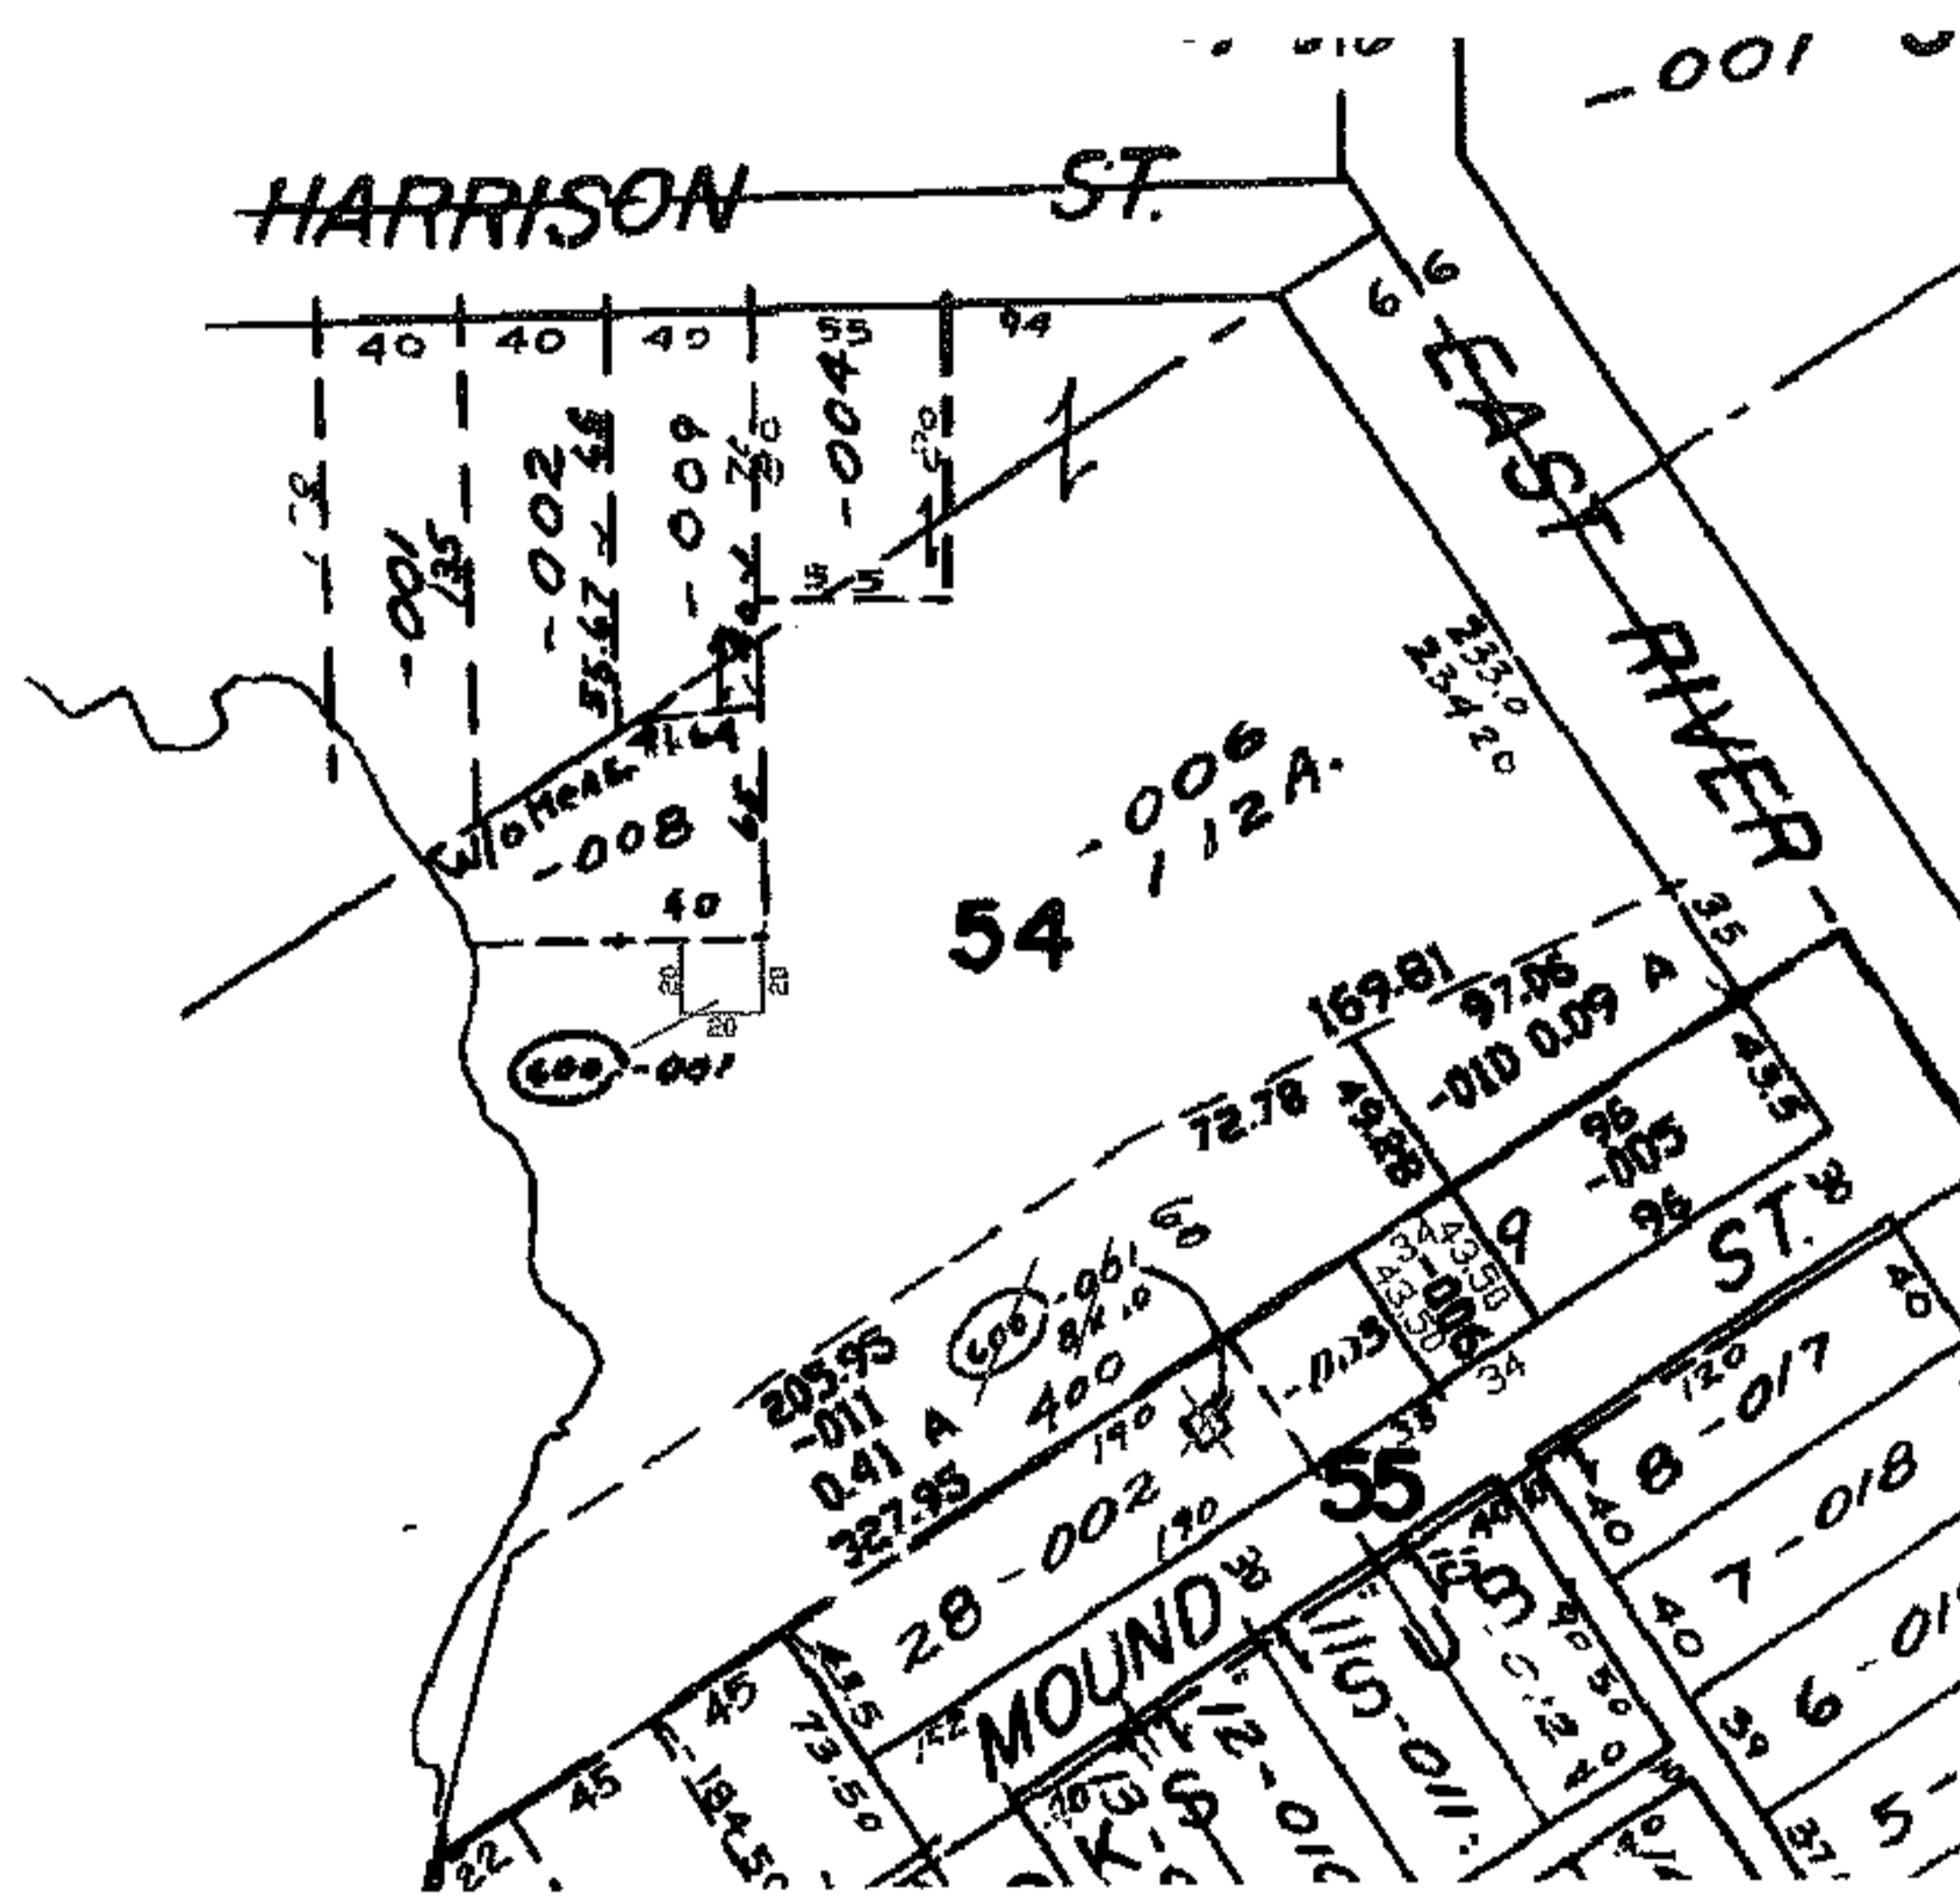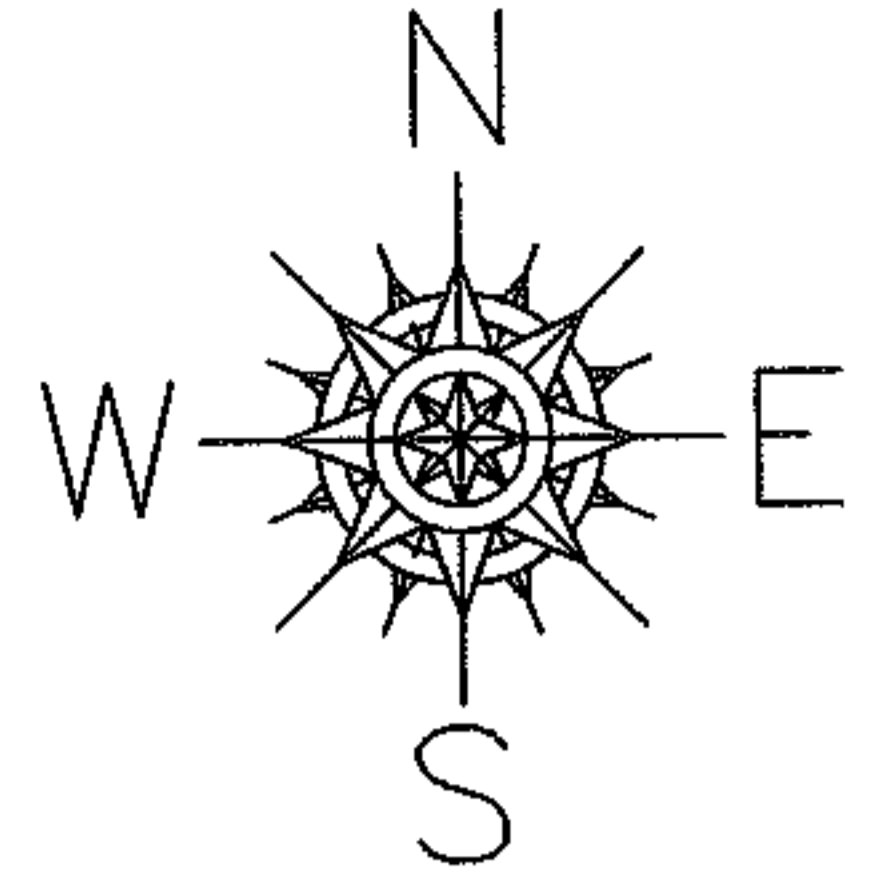

**SPLITS/DEEDS PROCESSED**  
LORAIN COUNTY TAX MAP DEPARTMENT  
226 MIDDLE AVE. ELYRIA, OHIO

SURVEYED BY: N/A  
CLOSURE: N/A  
MAP PAGE(S): 06-103  
APPROVED BY: DRH DATE: 8/13/2007  
SCALE: NOT TO SCALE PRIOR INSTRUMENT: 75/603