




PARENT PARCEL: 07-00-004-106-006

CHILD PARCEL: 07-00-004-106-008 & -009

STARTING POINT: WINTERFIELD SUB

07-01522-X

UNCOMBINATION

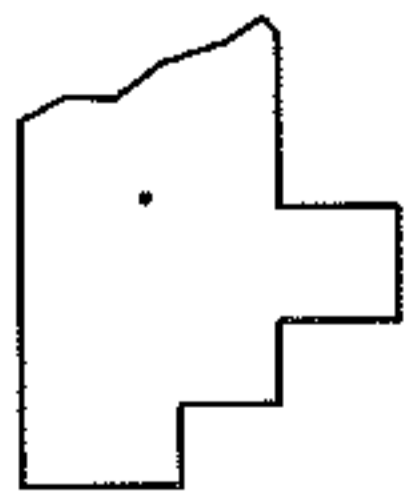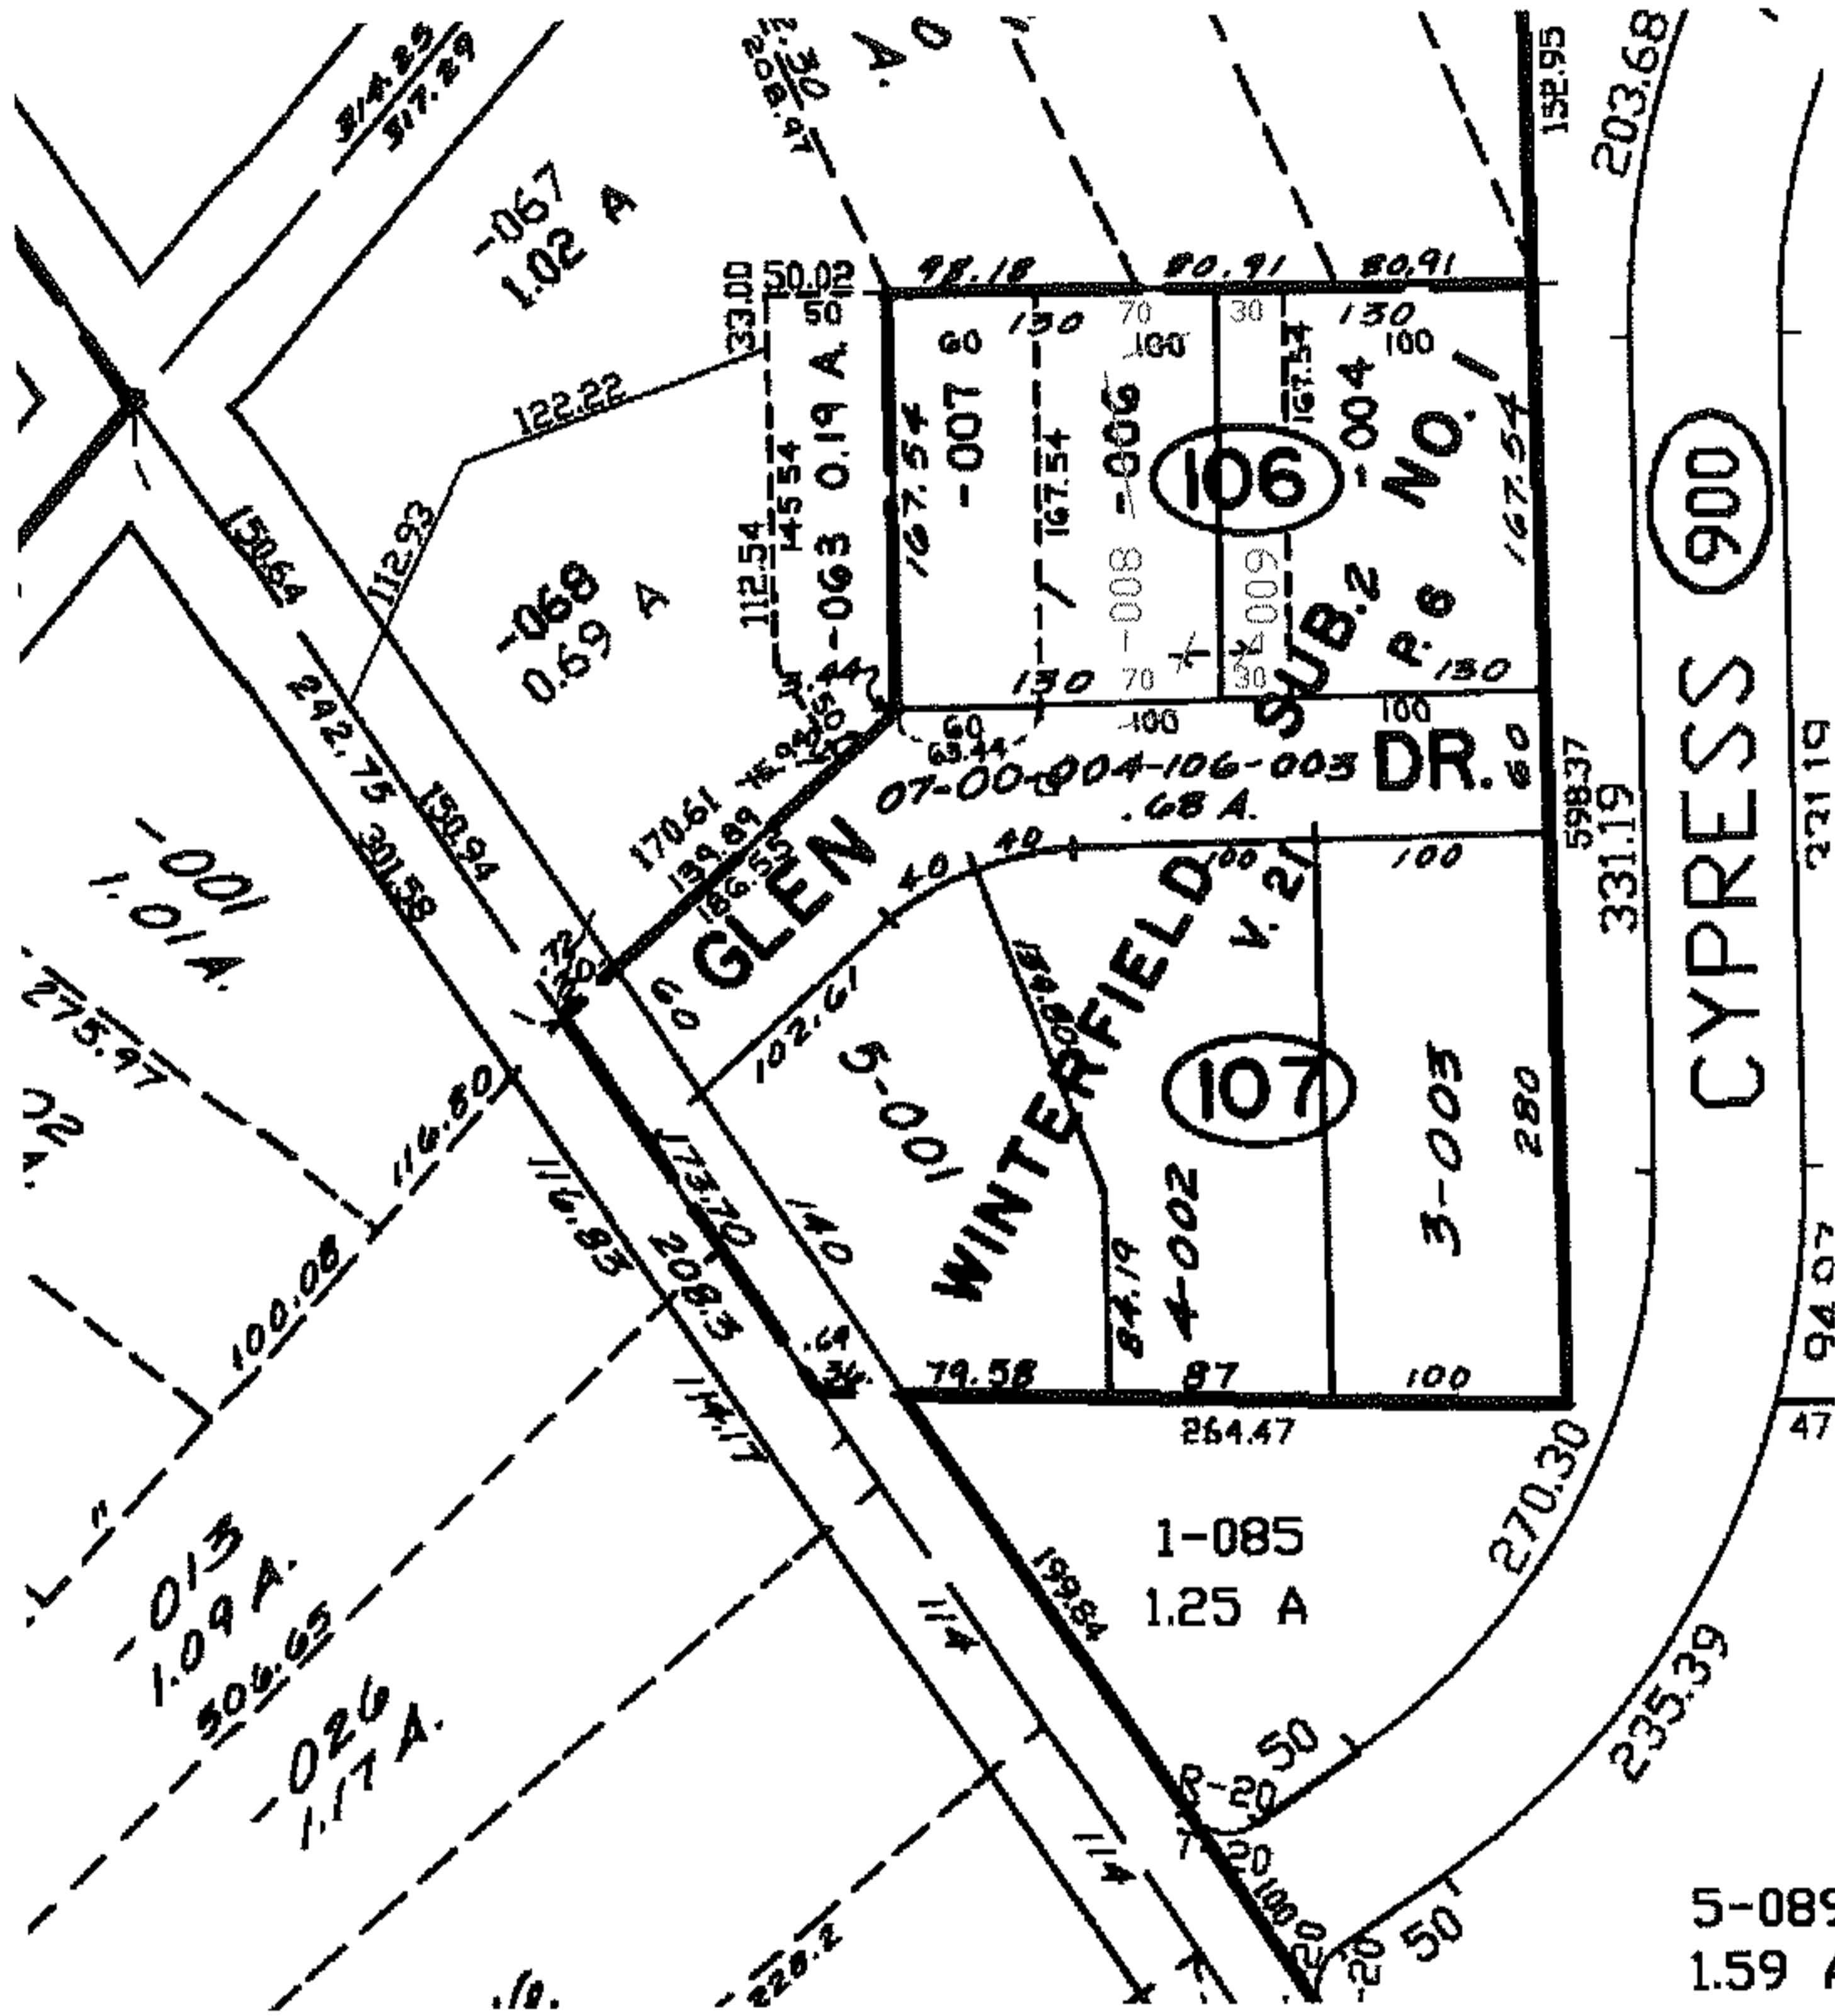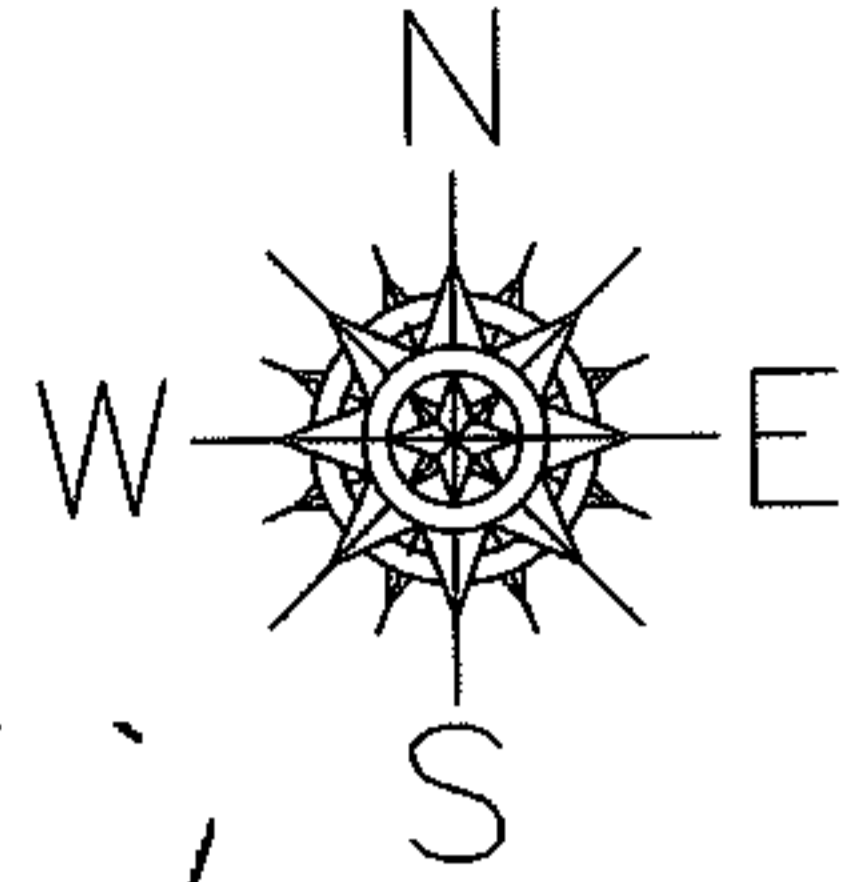

SPLITS/DEEDS PROCESSED

LORAIN COUNTY TAX MAP DEPARTMENT
226 MIDDLE AVE. ELYRIA, OHIO

SURVEYED BY: N/A
CLOSURE: N/A
MAP PAGE(S): 07-00-004-C
APPROVED BY: DRH DATE: 8-13-07
SCALE: NOT TO SCALE PRIOR INSTRUMENT: 20000679432