




PARENT PARCEL: 02-01-003-141-016

07-01523-A

CHILD PARCEL: --SAME--

STARTING POINT: 17TH ST AND ELYRIA ST

DEPTH CORR  
NO MAP CORR

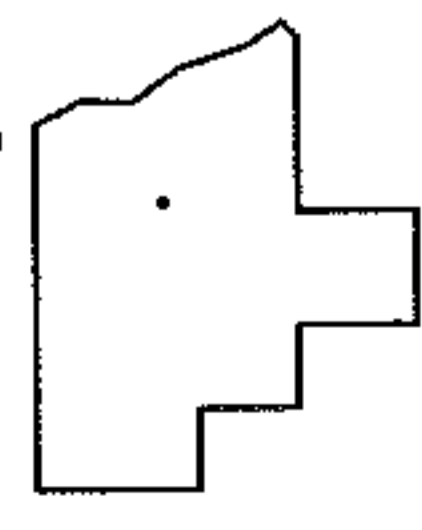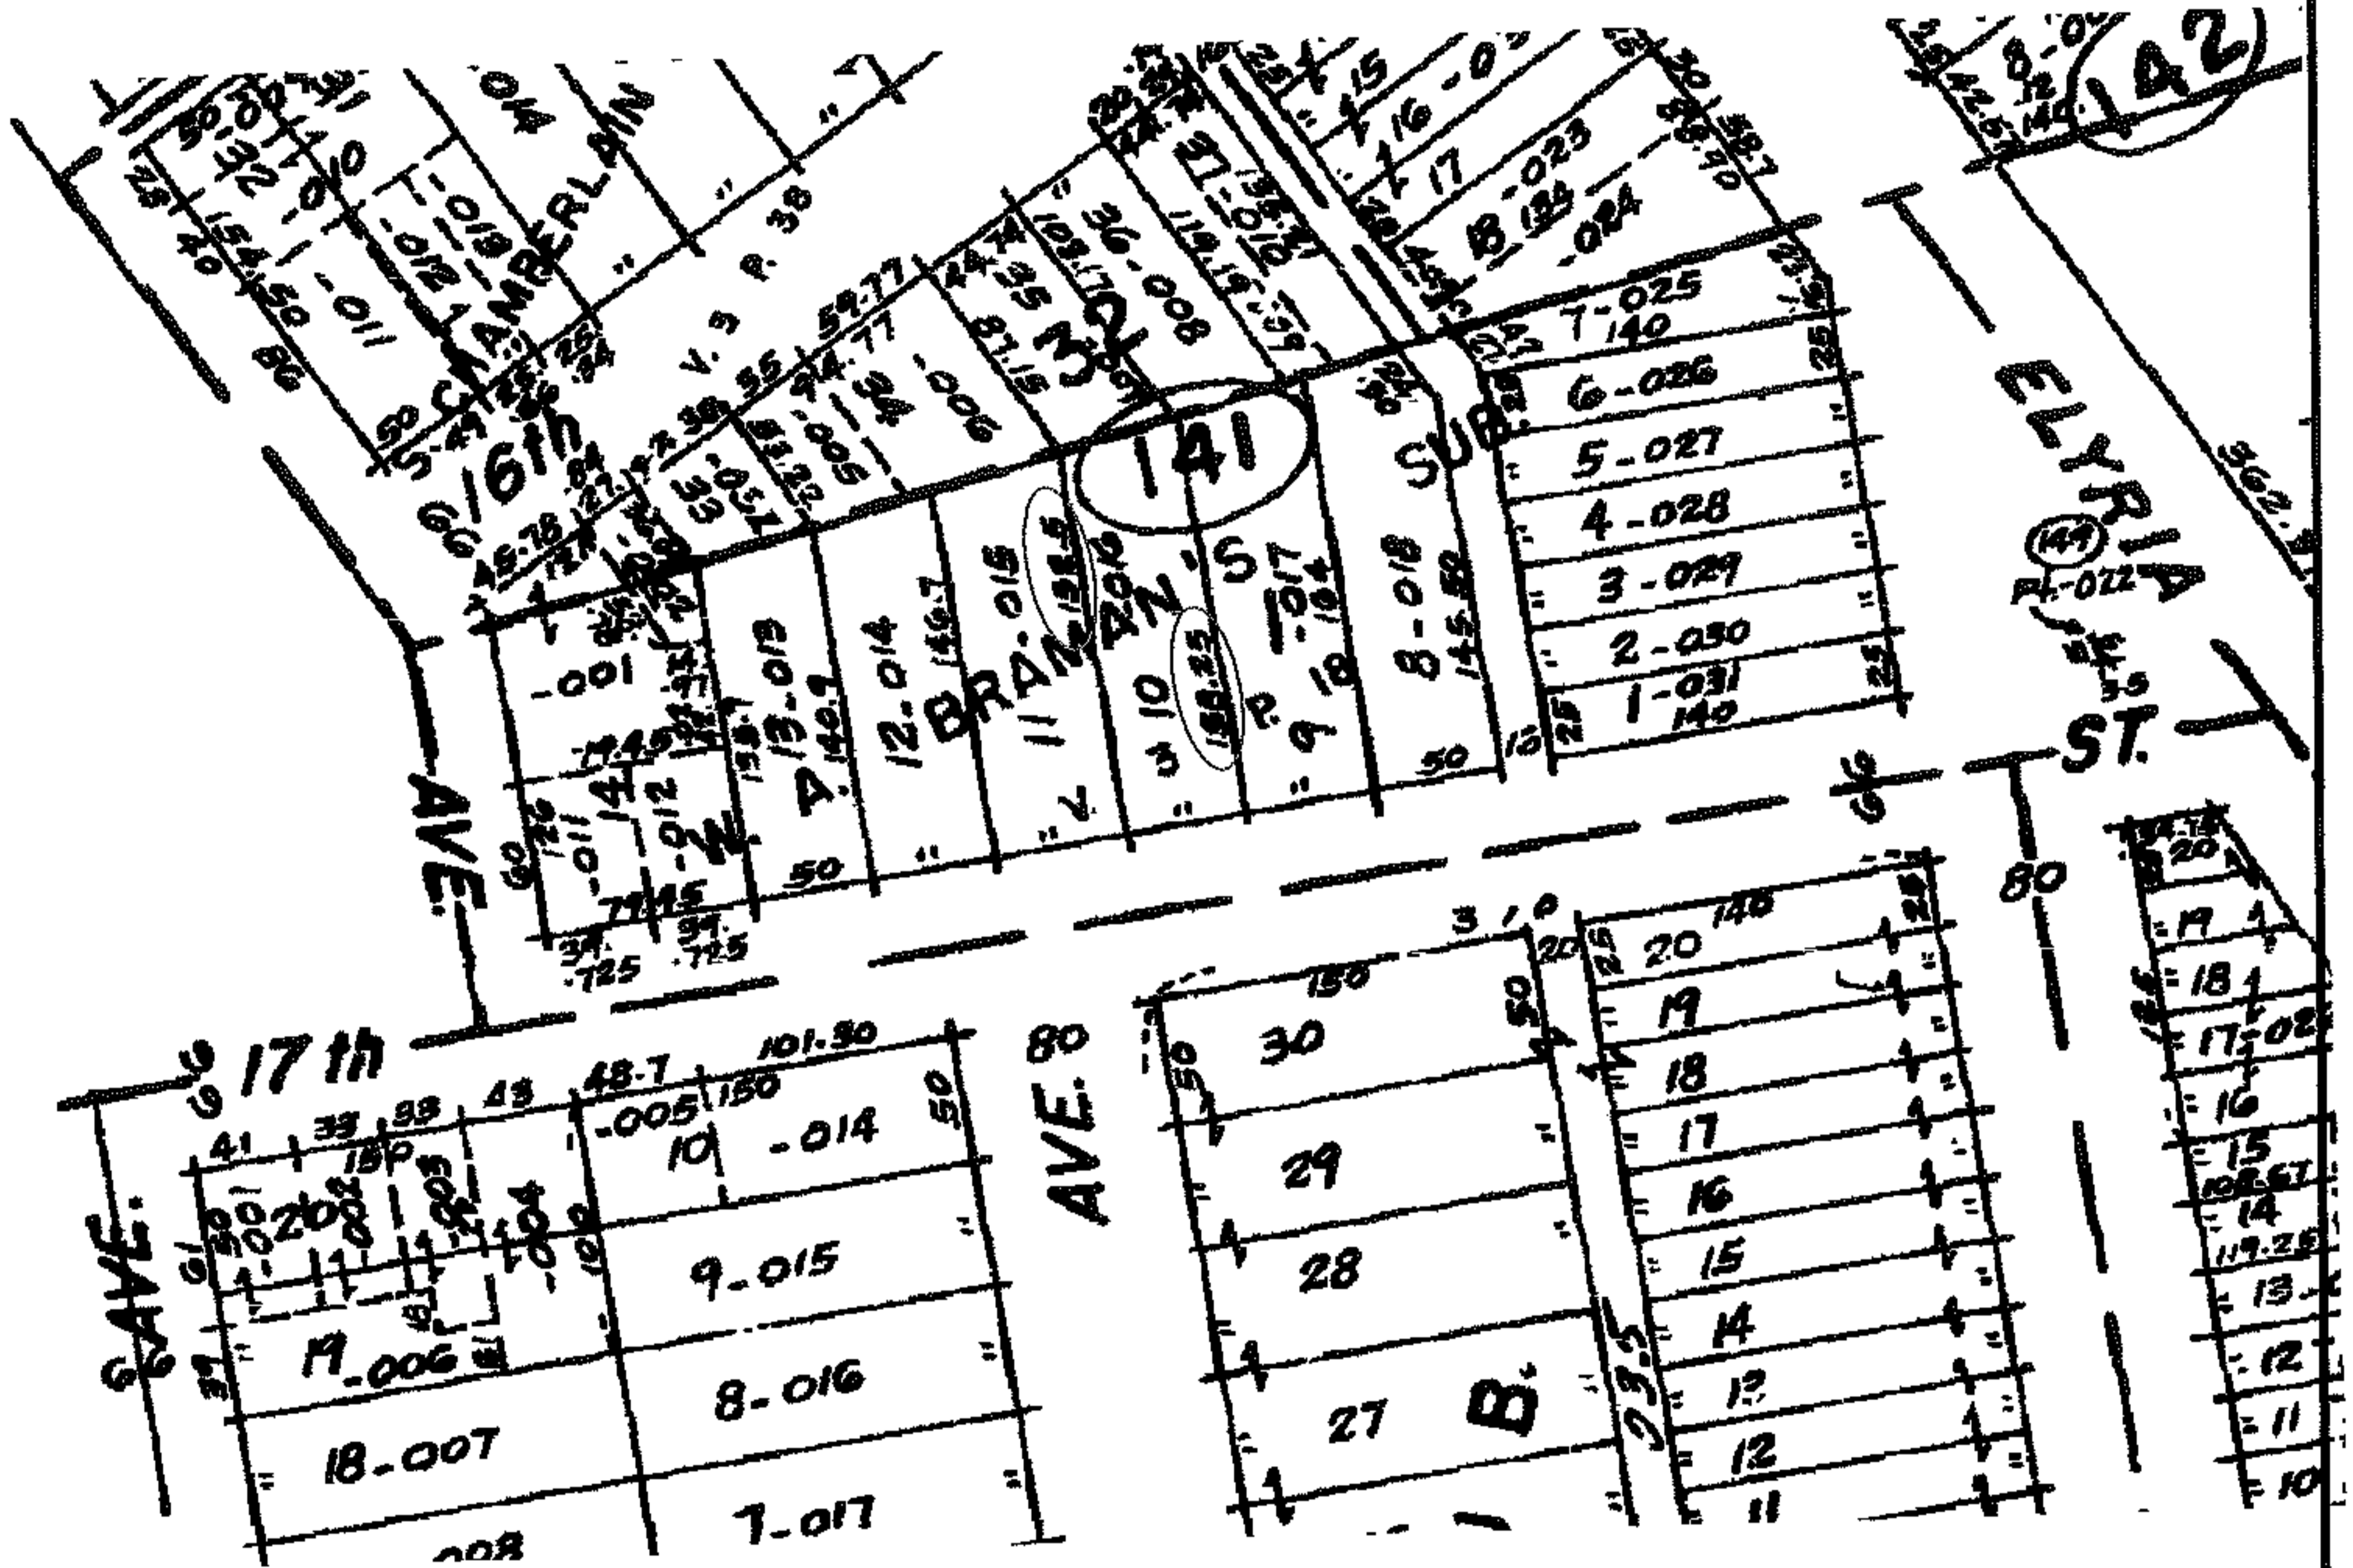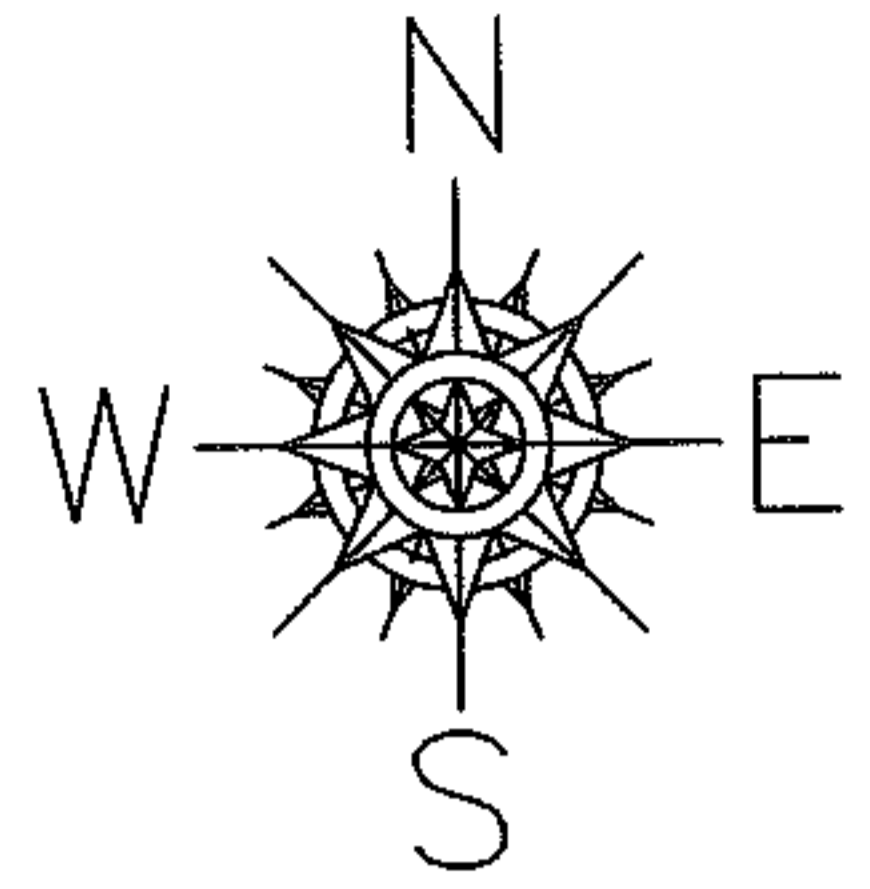

SPLITS/DEEDS PROCESSED

LORAIN COUNTY TAX MAP DEPARTMENT  
226 MIDDLE AVE. ELYRIA, OHIO

SURVEYED BY: N/A  
CLOSURE: N/A  
MAP PAGE(S): 02-01-003-F  
APPROVED BY: DRH DATE: 8/13/2007  
SCALE: NOT TO SCALE. PRIOR INSTRUMENT: 20070004236