



PARENT PARCEL: 16-00-040-000-007

CHILD PARCEL: --SAME--

STARTING POINT: INT CL CHAMBERLAIN RD AND NORTH LINE OF O.L. 40

07-01532-A

AC.CORR. PER SURVEY
RICH FREDRICKSON

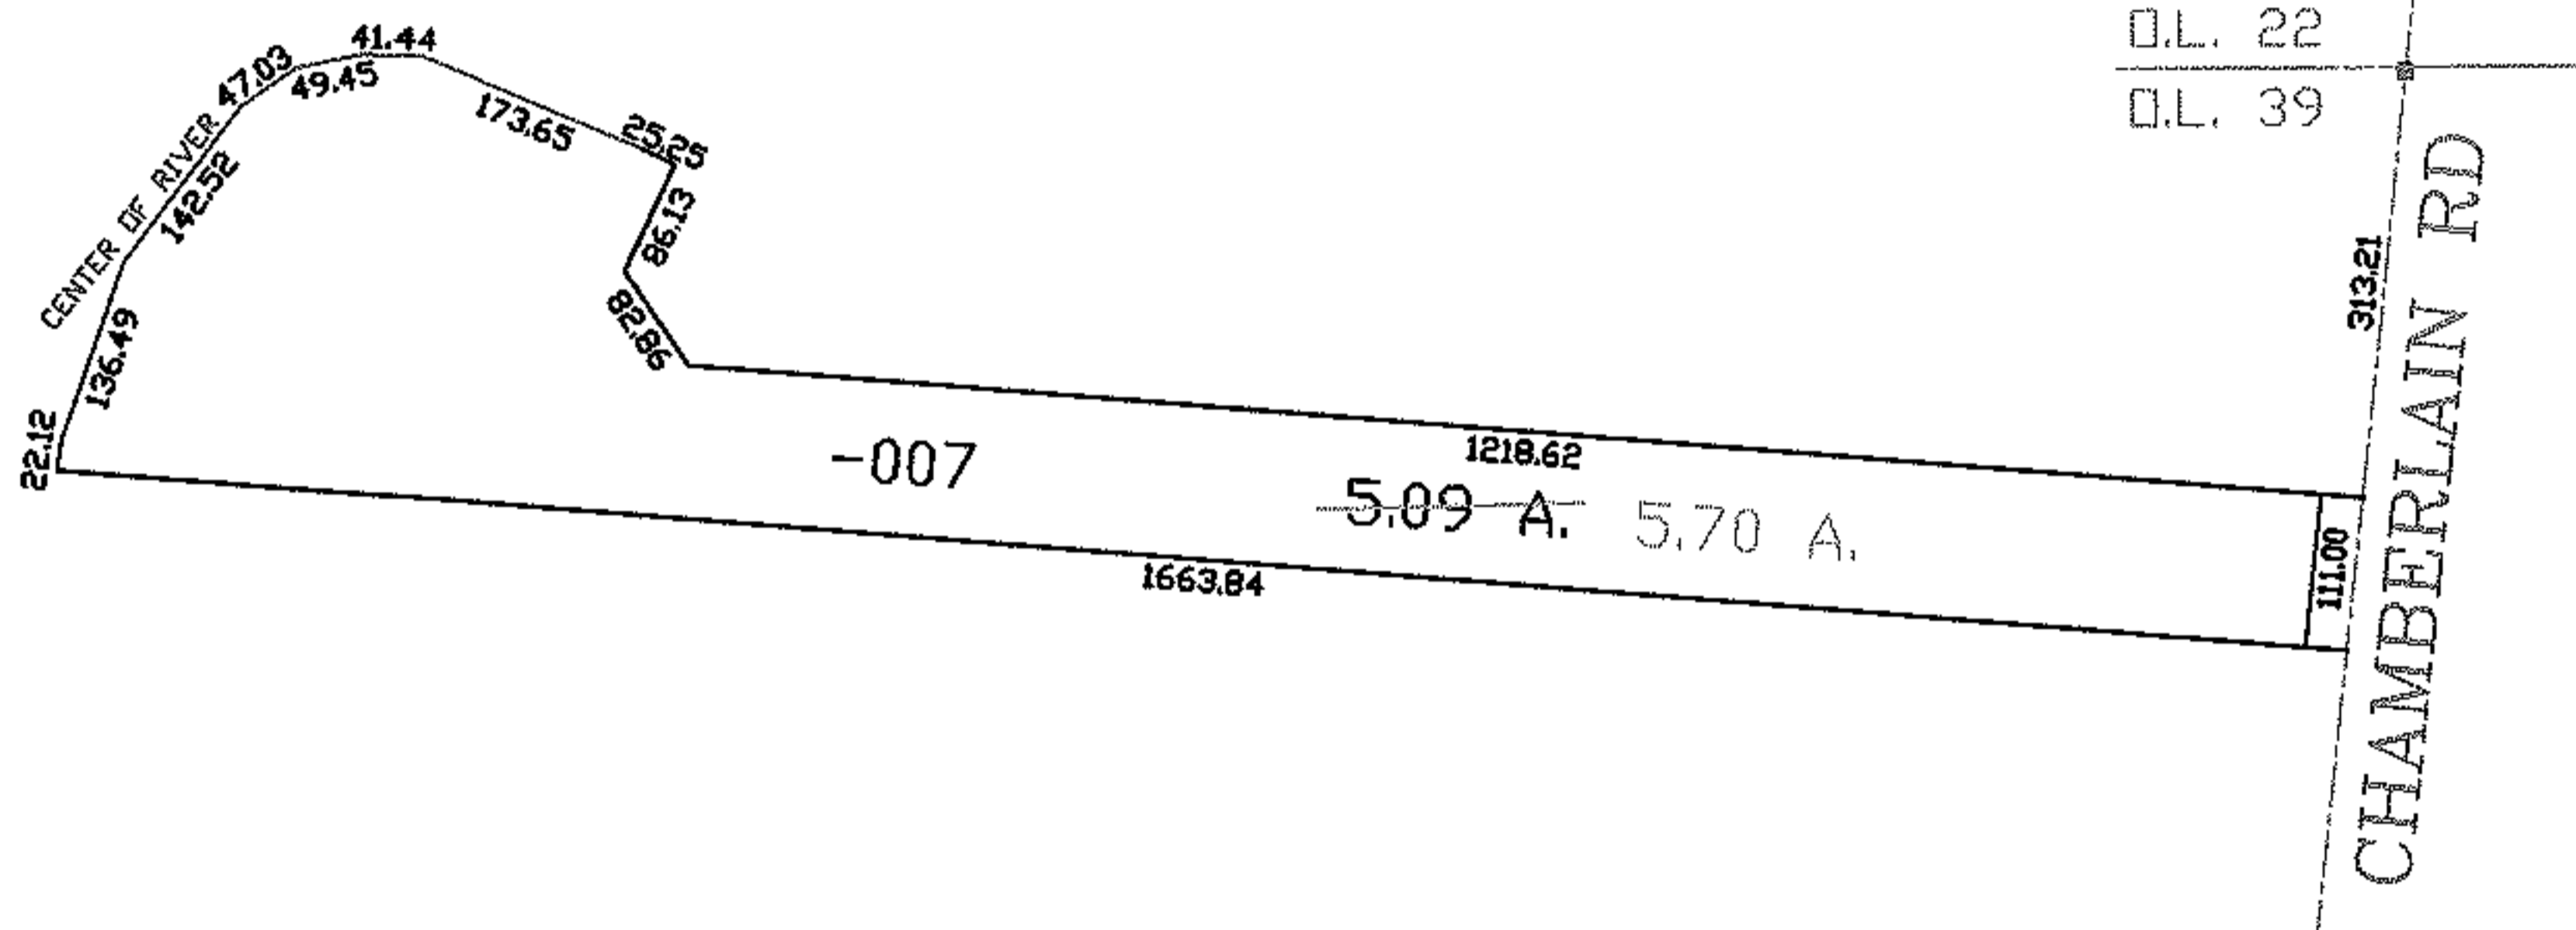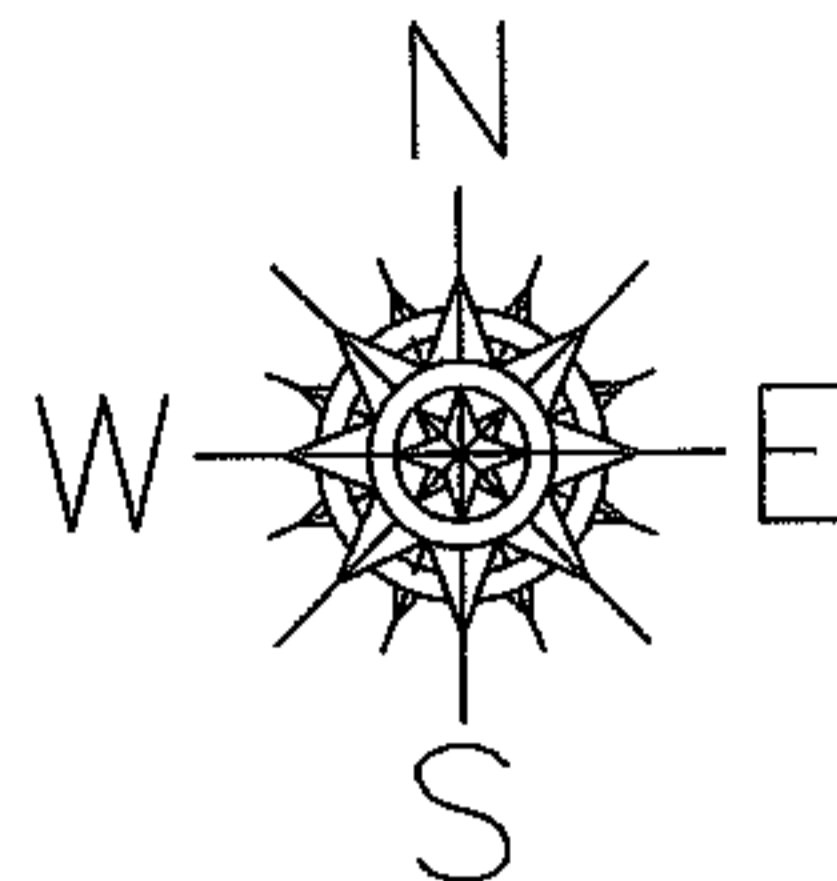

SPLITS/DEEDS PROCESSED
LORAIN COUNTY TAX MAP DEPARTMENT
226 MIDDLE AVE. ELYRIA, OHIO

SURVEYED BY: RICHARD FREDRICKSON
CLOSURE: 1:10,000
MAP PAGE(S): 16-00-040-B
APPROVED BY: DRH DATE: 9/13/2007
SCALE: 1" = 300' PRIOR INSTRUMENT: 20070203530